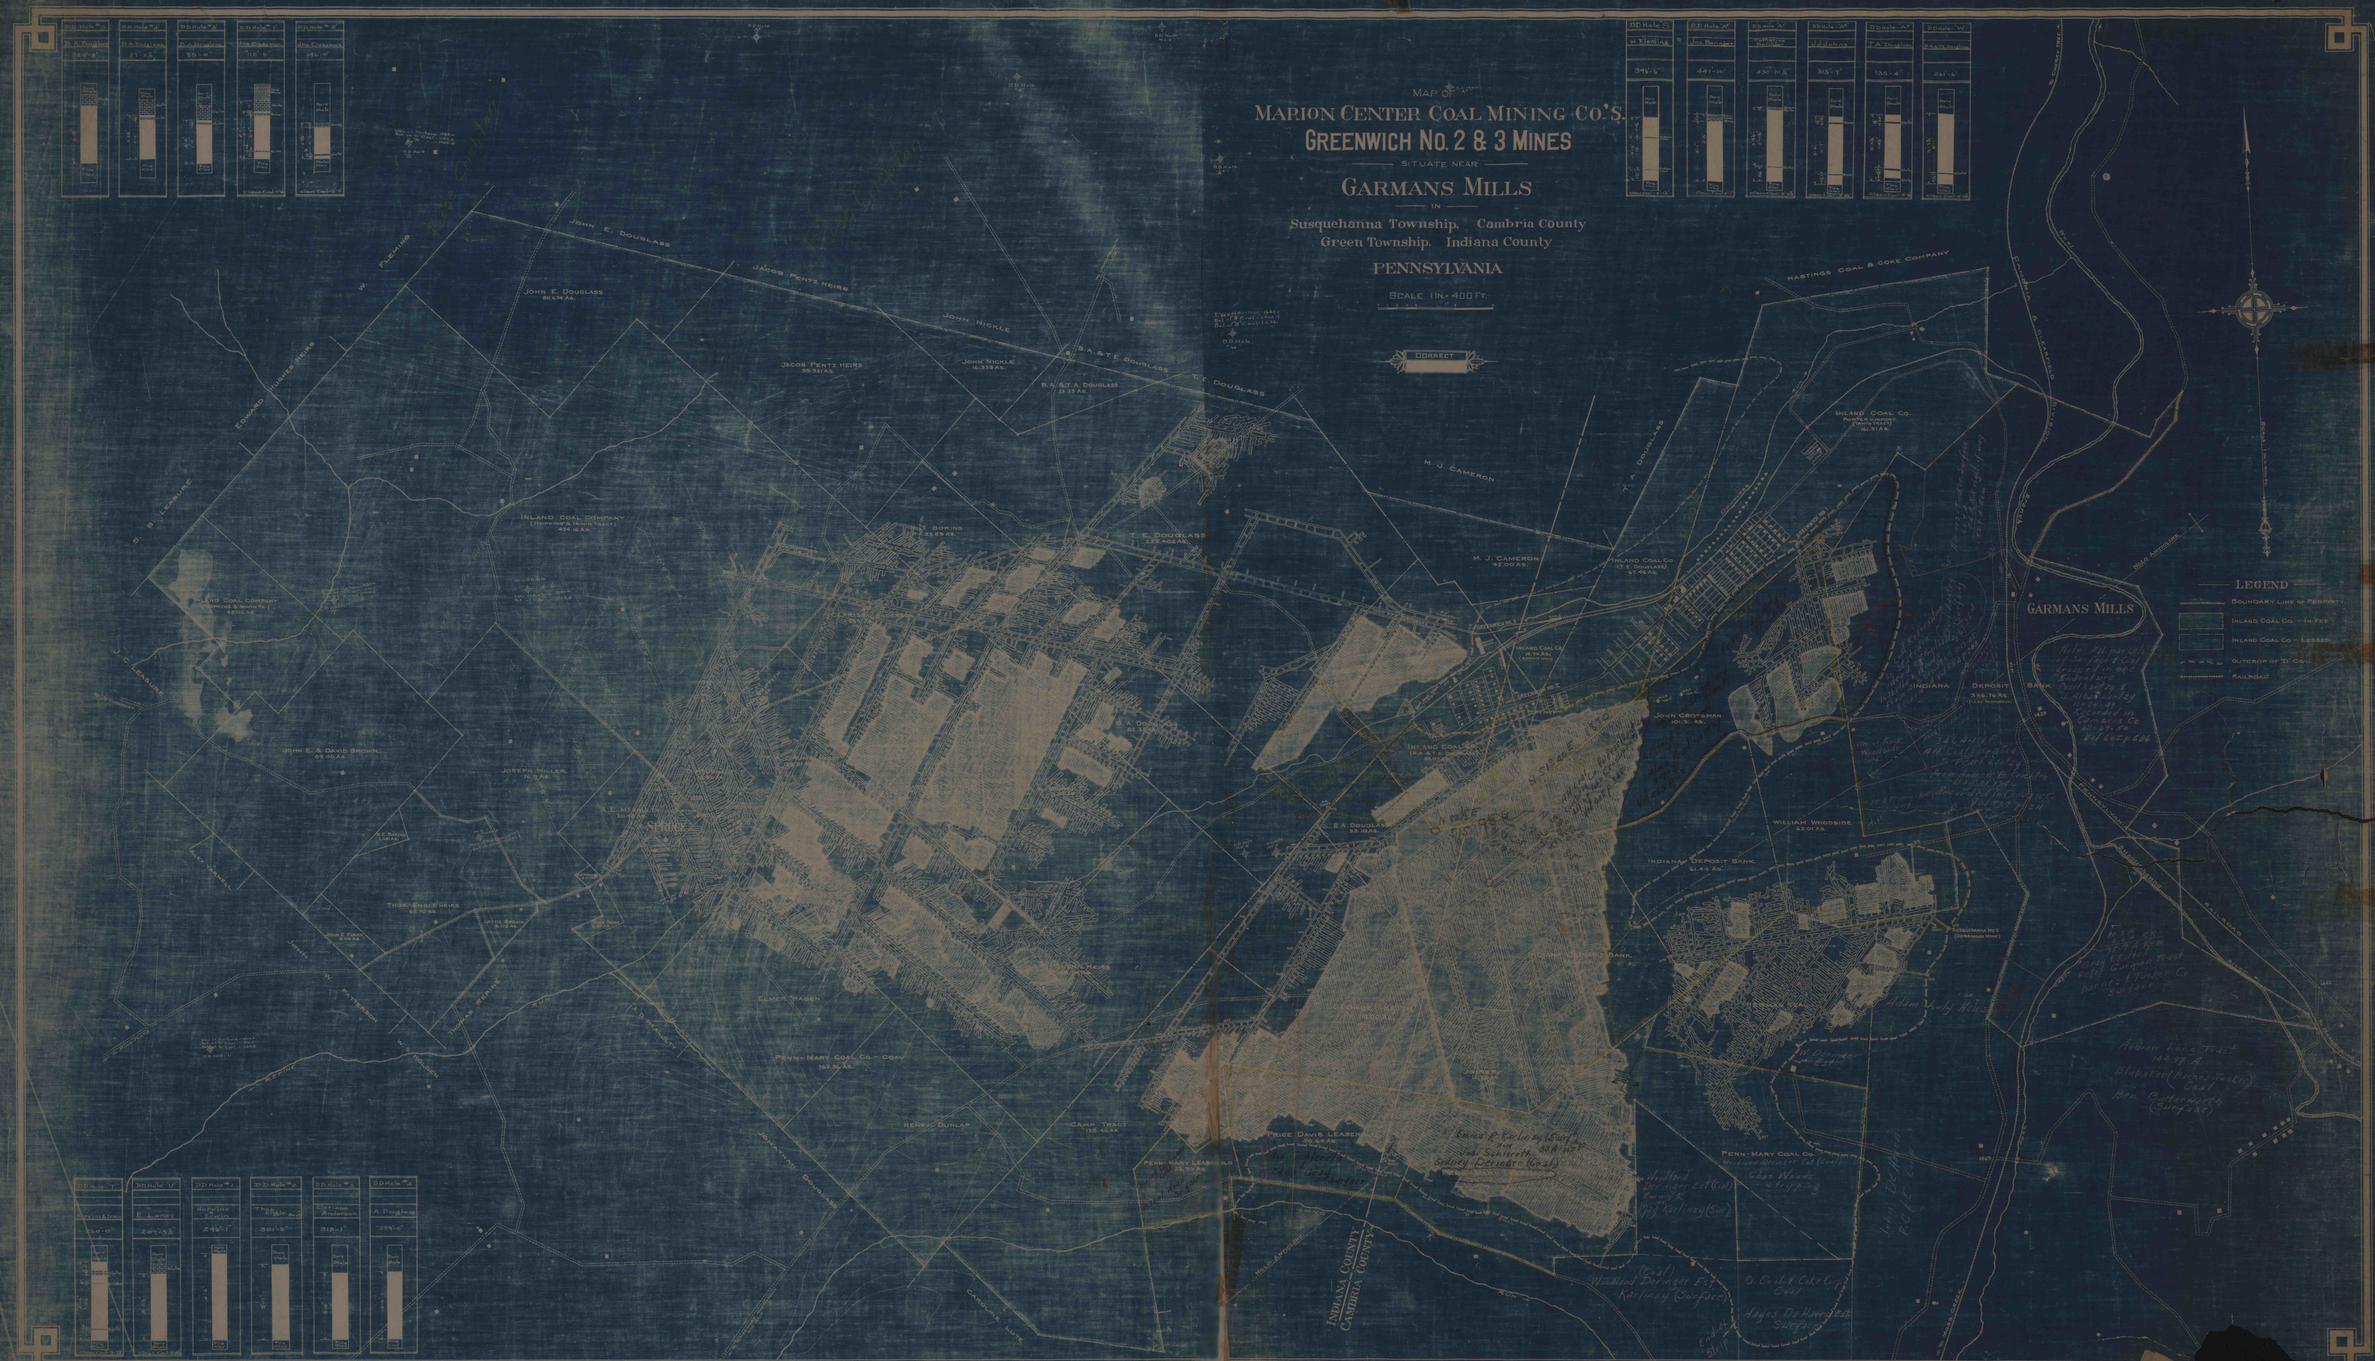
MAP OF
MARION CENTER COAL MINING CO.'S
GREENWICH No. 2 & 3 MINES
SITUATE NEAR
GARMANS MILLS
IN
Susquehanna Township, Cambria County
Green Township, Indiana County
PENNSYLVANIA
SCALE 1 IN. = 400 FT.
CORRECT
LEGEND
BOUNDARY LINE OF PROPERTY
INLAND COAL CO. — IN FEE
INLAND COAL CO. — LEASED
OUTCROP OF "D" COAL
RAILROAD
GARMANS MILLS
JOHN E. DOUGLASS
JACOB PENTZ HEIRS
JOHN NICKLE
B.A. & T.E. DOUGLASS
T.E. DOUGLASS
M. J. CAMERON
HASTINGS COAL & COKE COMPANY
INLAND COAL COMPANY
INLAND COAL CO.
INDIANA DEPOSIT BANK
WILLIAM WOODSIDE
PENN-MARY COAL CO.
PRICE DAVIS LEASE
INDIANA COUNTY
CAMBRIA COUNTY
SPRUCE