


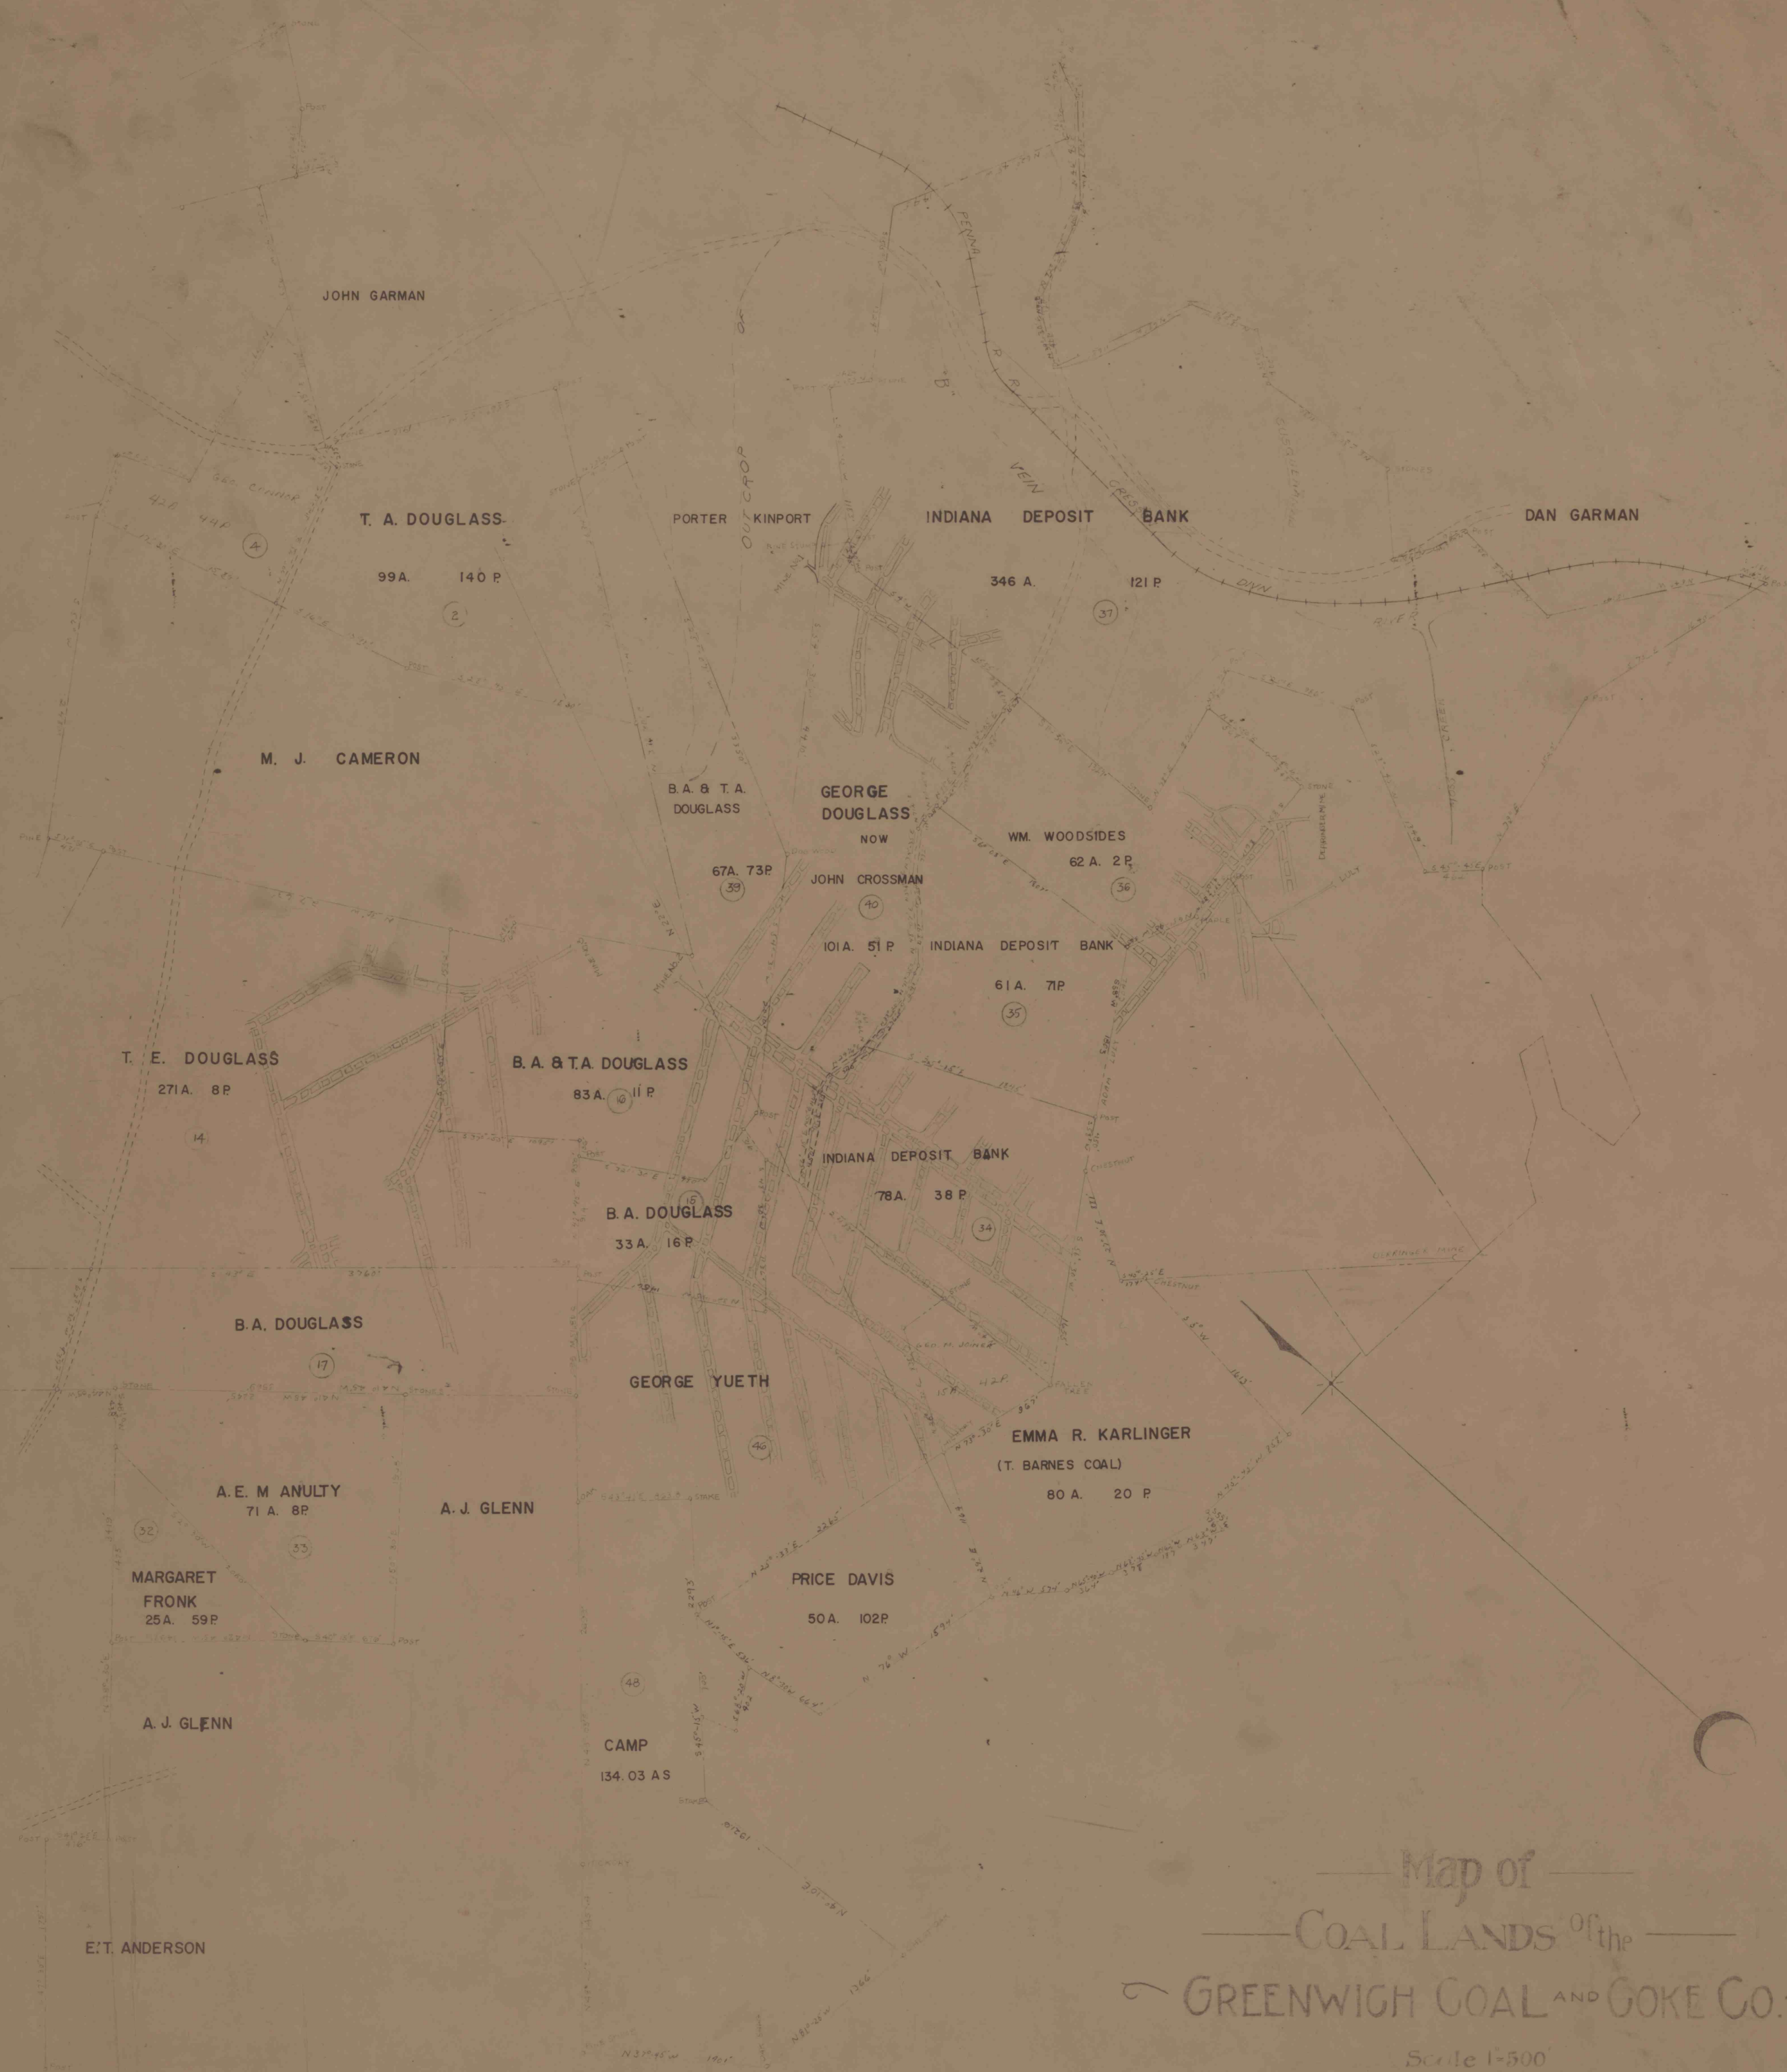

Map of
COAL LANDS of the
GREENWICH COAL AND COKE CO.
Scale 1"=500'