


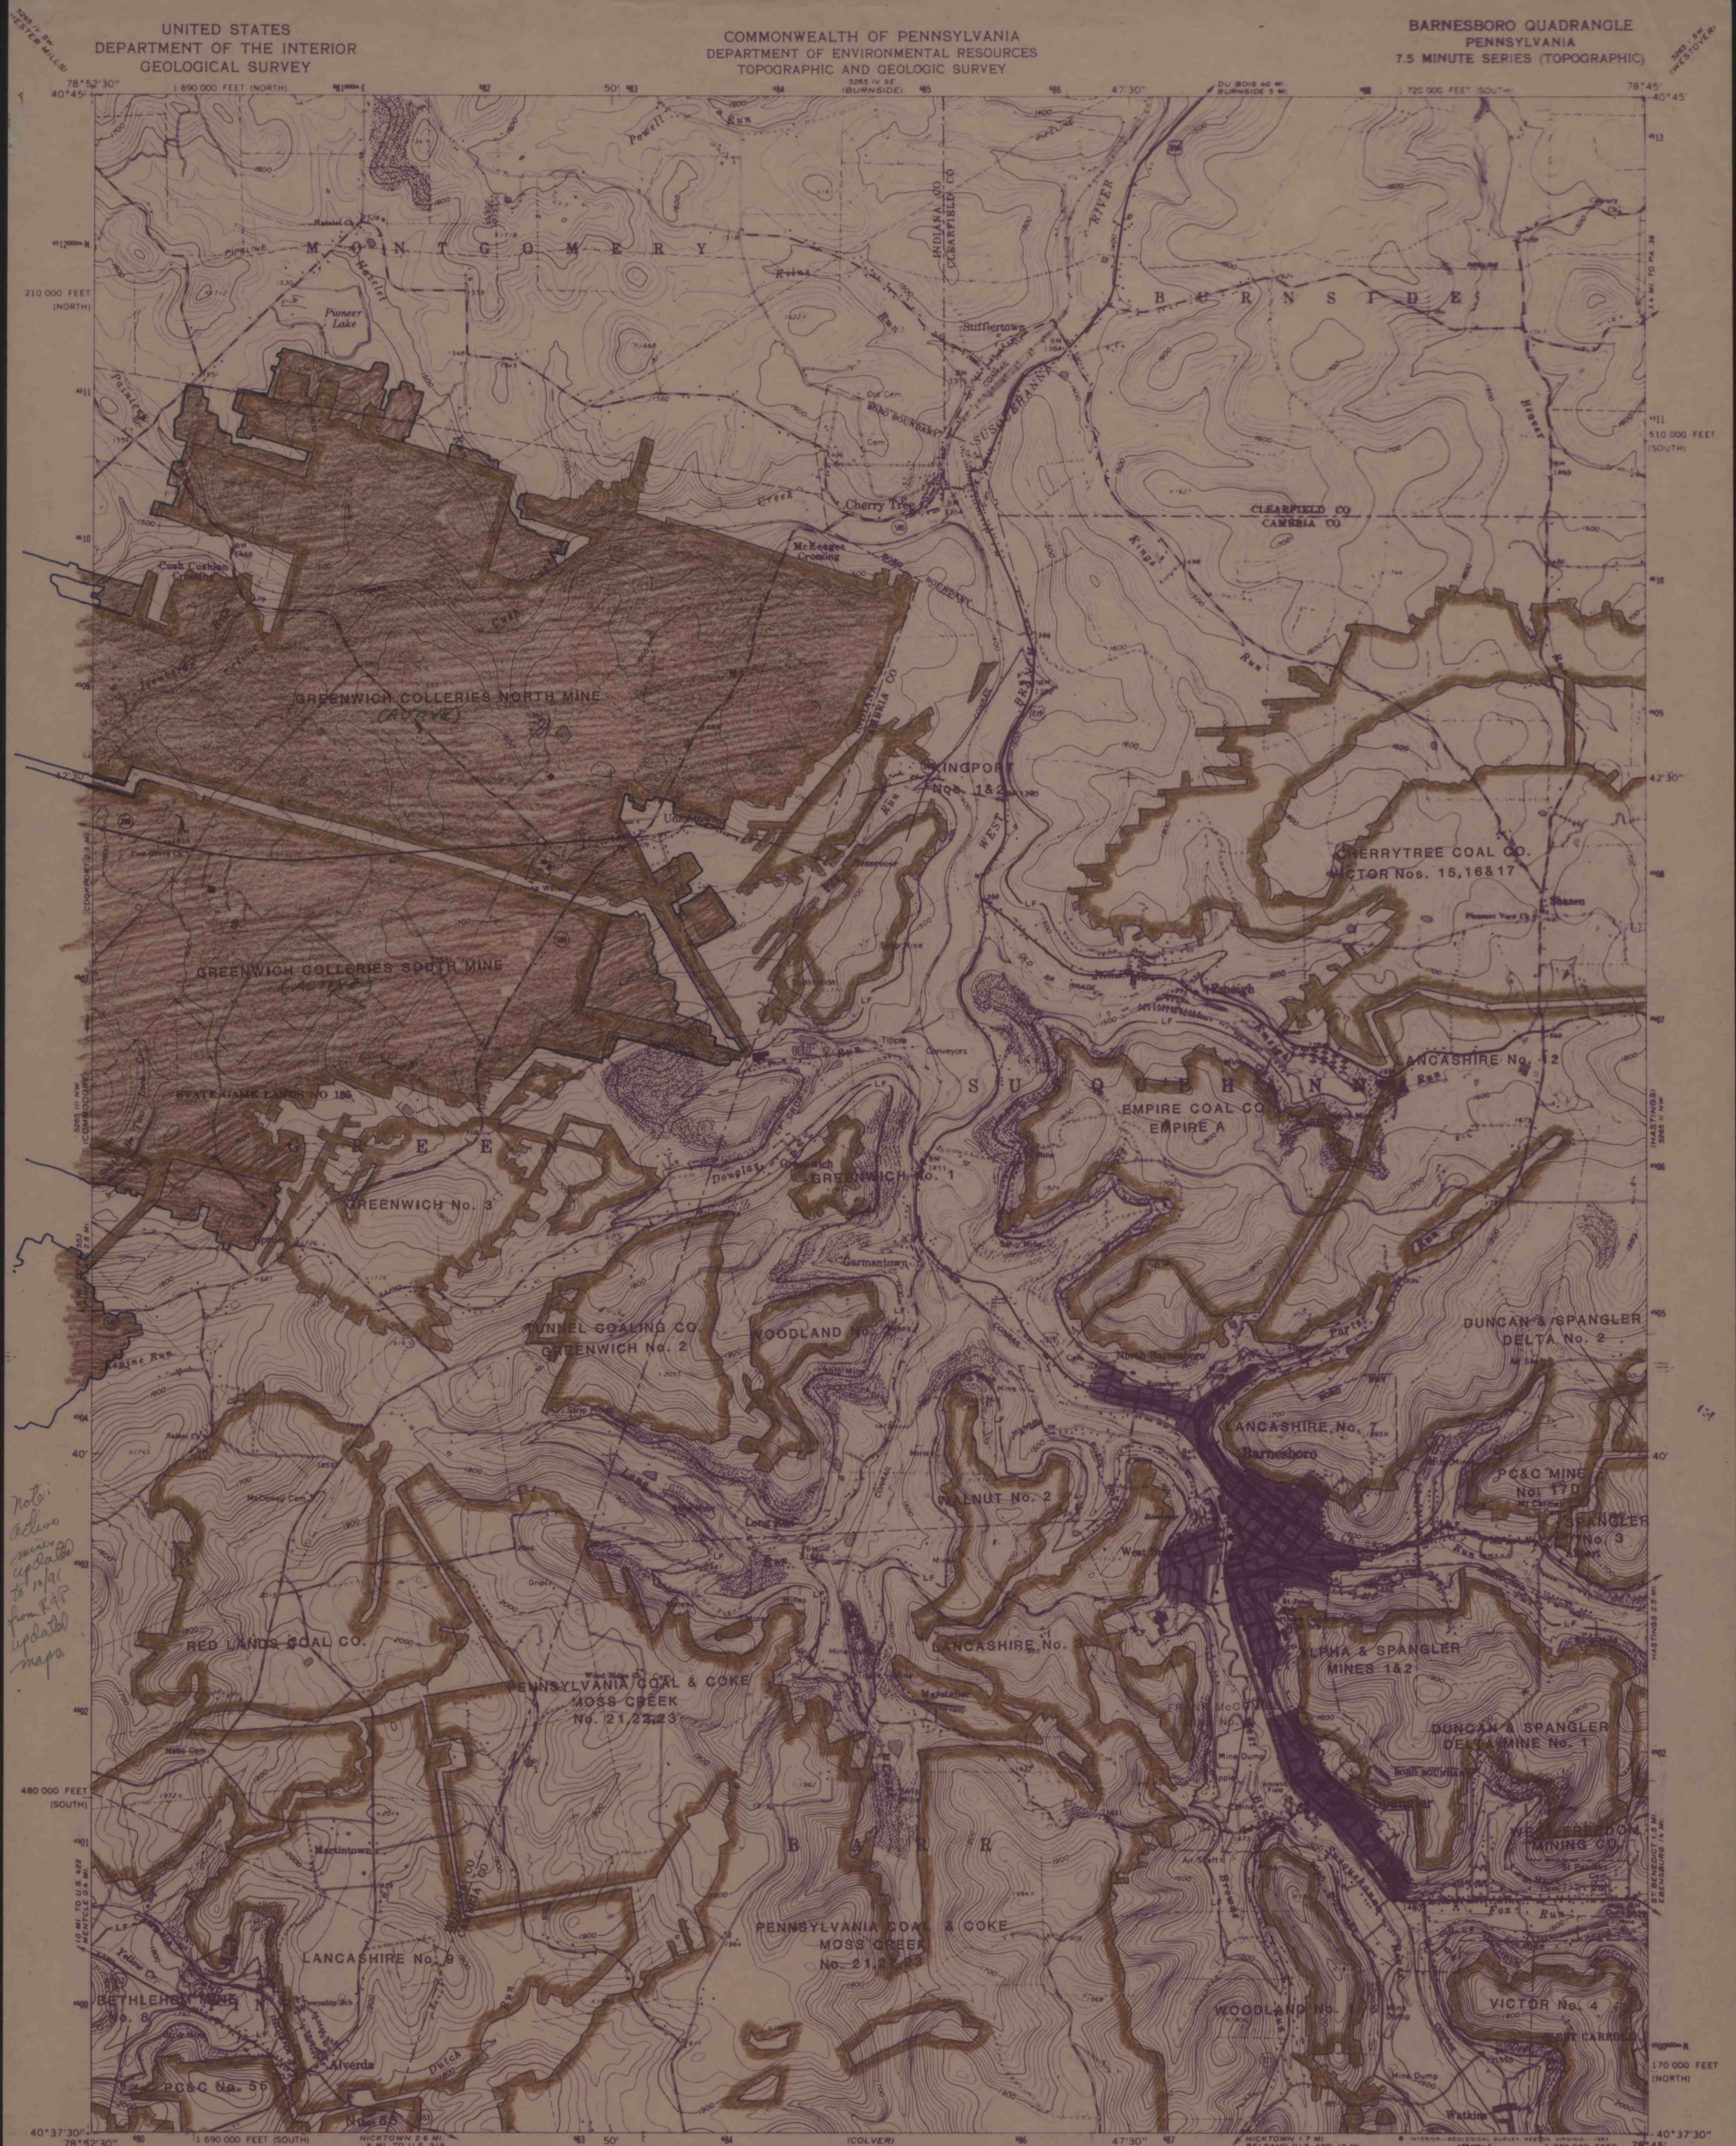

Notes:
Active
mines
updated
from 1941
updated
maps

Mapped, edited, and published by the Geological Survey

Control by USGS and NOS/NOAA

Topography by photogrammetric methods from aerial photographs taken 1958. Field checked in 1961


Polyconic projection. 10,000-foot grid ticks based on Pennsylvania coordinate system, south and north zones 1000-meter Universal Transverse Mercator grid ticks, zone 17, shown in blue. 1927 North American Datum. To place on the predicted North American Datum 1983 move the projection lines 4 meters south and 21 meters west as shown by dashed corner ticks

Fine red dashed lines indicate selected fence and field lines where generally visible on aerial photographs. This information is unchecked

Red tint indicates areas in which only landmark buildings are shown

There may be private inholdings within the boundaries of the National or State reservations shown on this map

IMAPS # 20972

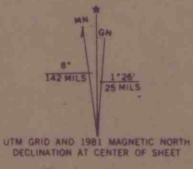

SCALE 1:24,000

CONTOUR INTERVAL 20 FEET

NATIONAL GEODETIC VERTICAL DATUM OF 1929

UTM GRID AND 1981 MAGNETIC NORTH DECLINATION AT CENTER OF SHEET

THIS MAP COMPLIES WITH NATIONAL MAP ACCURACY STANDARDS FOR SALE BY U.S. GEOLOGICAL SURVEY, RESTON, VIRGINIA 22092

A FOLDER DESCRIBING TOPOGRAPHIC MAPS AND SYMBOLS IS AVAILABLE ON REQUEST

LOWER FREEPORT SEAM

Heavy-duty

Medium-duty

Light-duty

Unimproved dirt

U.S. Route

State Route

QUADRANGLE LOCATION

Revisions shown in purple compiled in cooperation with Commonwealth of Pennsylvania agencies from aerial photographs taken 1977 and other sources. This information not field checked. Map edited 1981

BARNESBORO, PA.

N4037.5—W7845/7.5

1961

PHOTOREVISED 1981

DNA 5265 III NE-SERIES 7831