


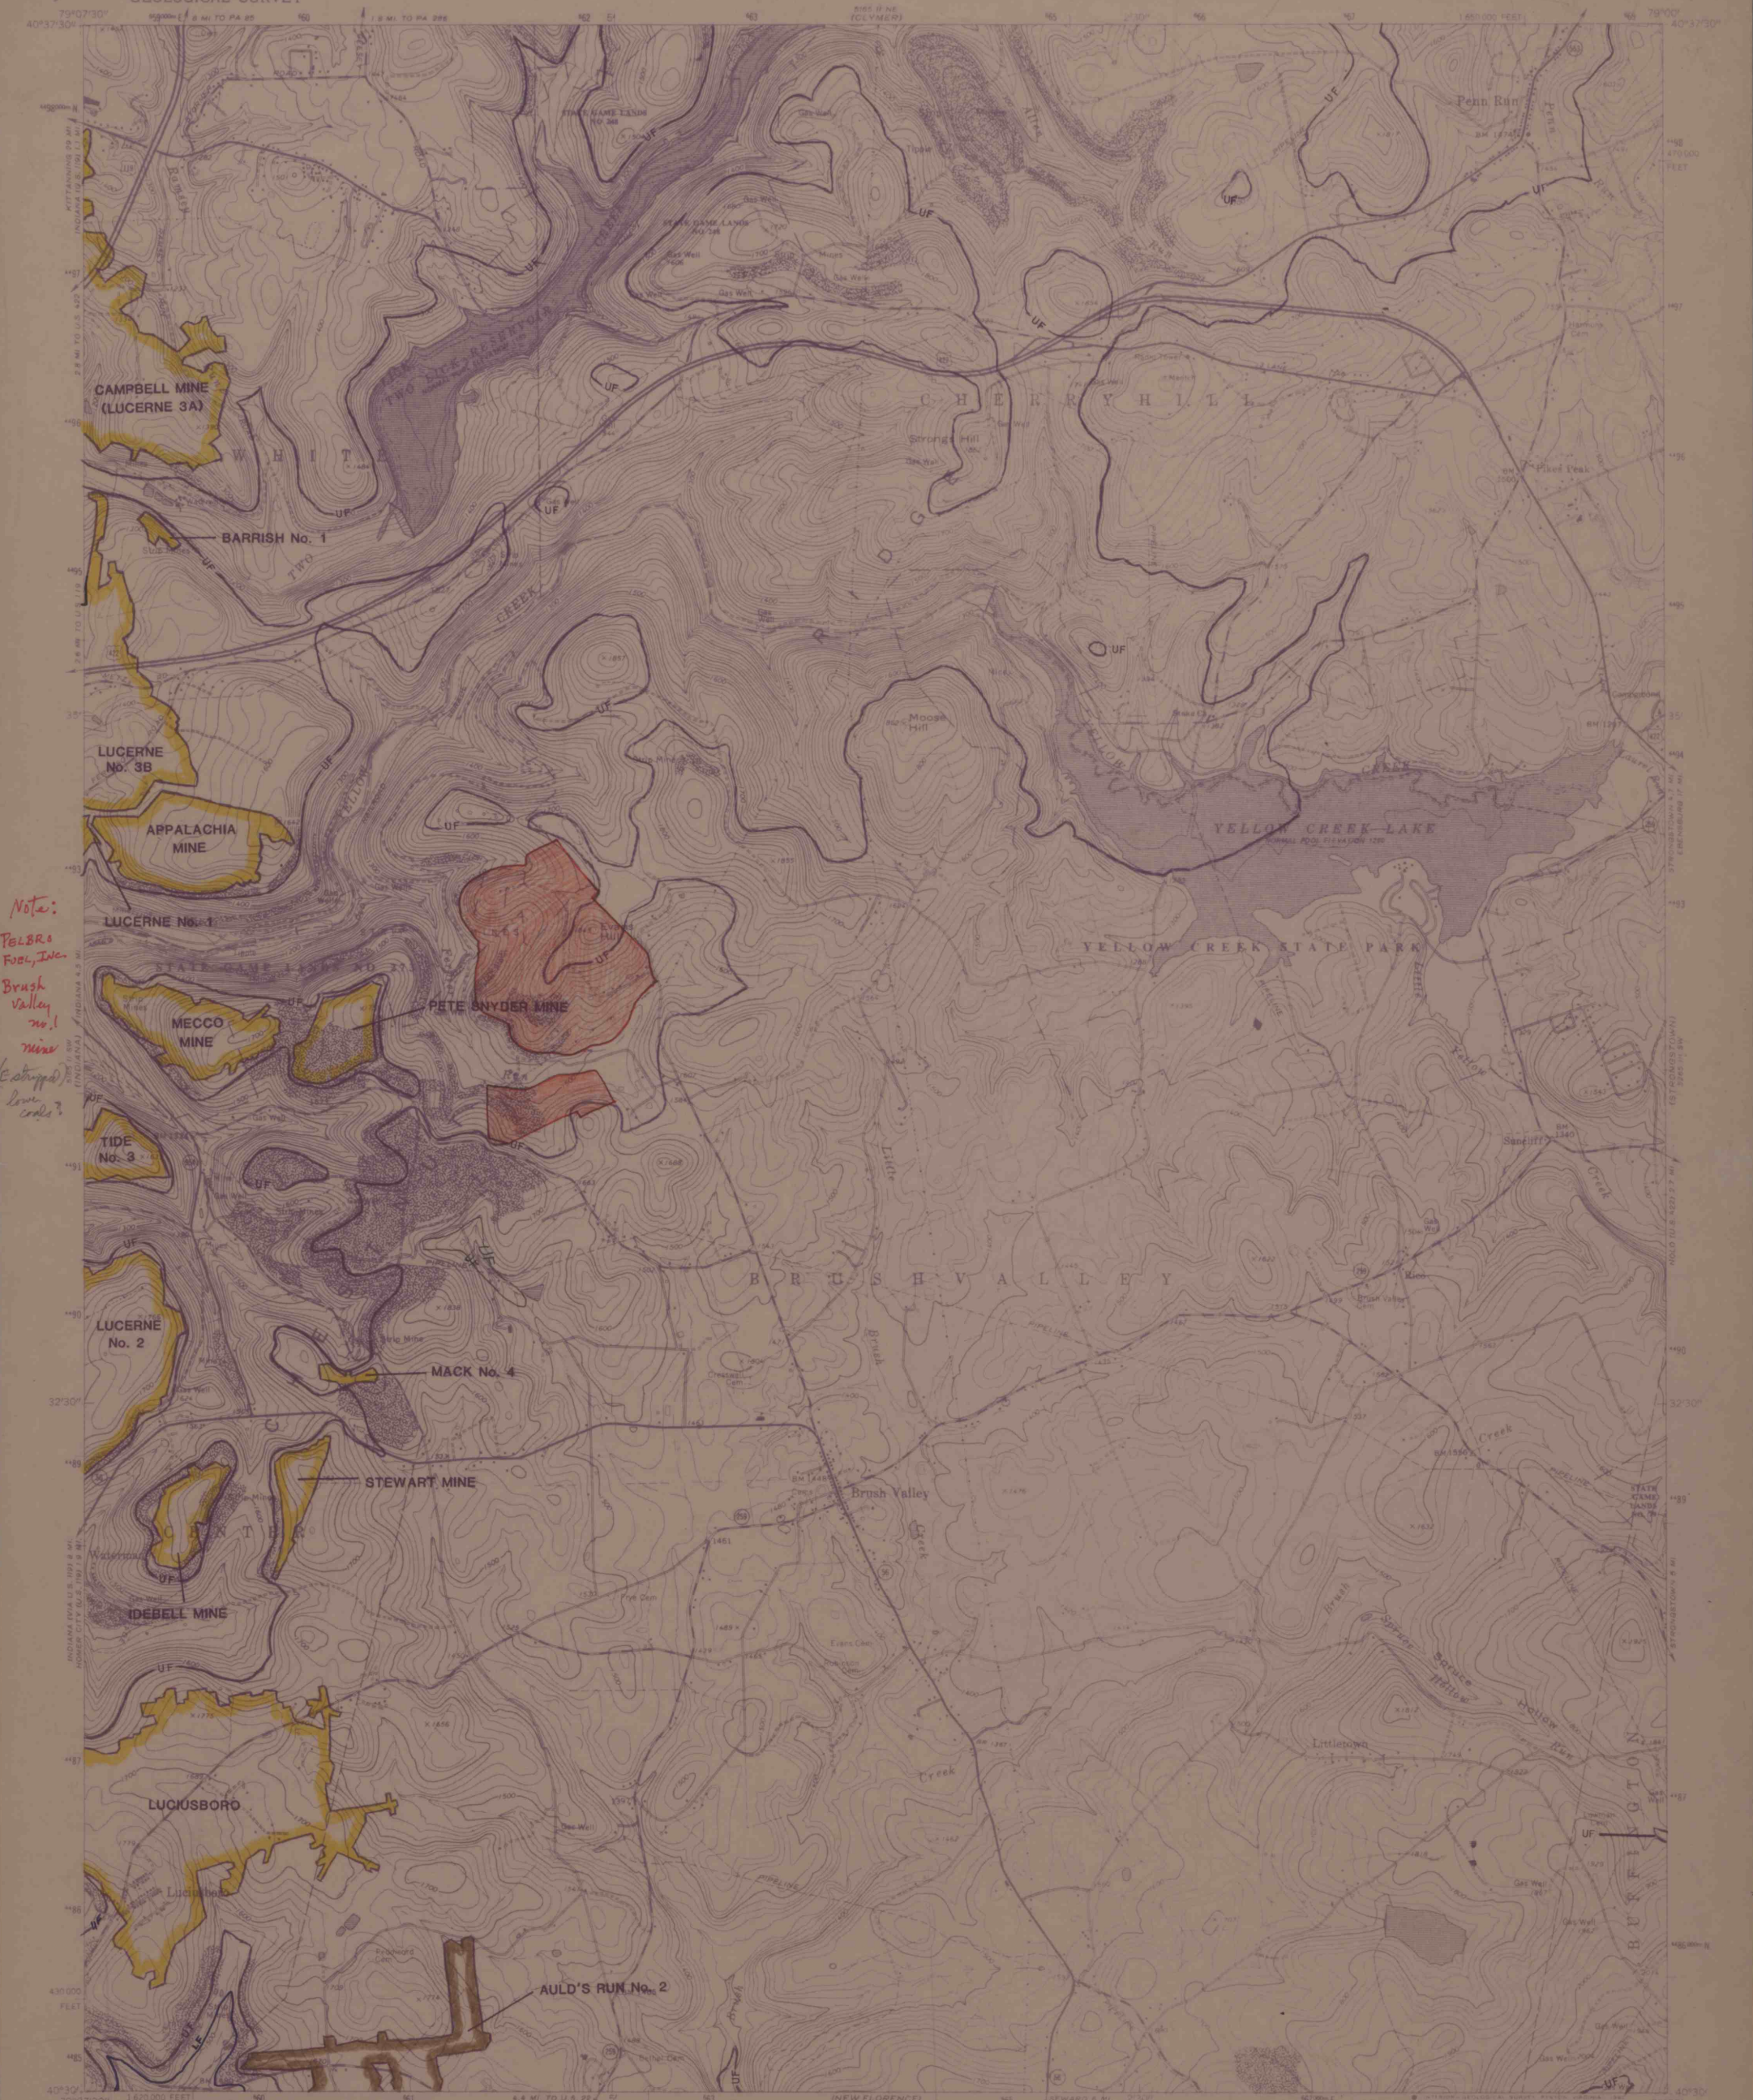

Note:
P&B
F&C, Inc.
Brush
Valley
no. 1
mine
(E. Stripp)
low
coals?

Mapped, edited, and published by the Geological Survey
Control by USGS and NOS/NOAA

Topography by photogrammetric methods from aerial
photographs taken 1961. Field checked 1963

Polyconic projection, 10,000-foot grid ticks based on Pennsylvania
coordinate system, 5000 zone. 1000-meter Universal Transverse
Mercator grid ticks, zone 17, shown in blue. 1927 North American
Datum. To place on predicted North American Datum 1983 move the
projection lines 4 meters south and 21 meters west as shown by
dashed corner ticks

Fine red dashed lines indicate selected fence and field lines where
generally visible on aerial photographs. This information is unchecked
There may be private inholdings within the boundaries of
the National or State reservations shown on this map

Revisions shown in purple and woodland shaded in cooperation with
Commonwealth of Pennsylvania agencies from aerial photographs taken 1977
and other sources. This information not field checked. Map edited 1981

UTM GRID AND 1983 MAGNETIC NORTH
DECLINATION AT CENTER OF SHEET

THIS MAP COMPLIES WITH NATIONAL MAP ACCURACY STANDARDS
FOR SALE BY U.S. GEOLOGICAL SURVEY, RESTON, VIRGINIA 22092
A FOLDER DESCRIBING TOPOGRAPHIC MAPS AND SYMBOLS IS AVAILABLE ON REQUEST

UPPER AND LOWER FREEPORT SEAMS

UPPER FREEPORT
LOWER FREEPORT

ROAD CLASSIFICATION
Heavy duty
Light duty
Unimproved dirt
U.S. Route
State Route

BRUSH VALLEY, PA.

N4030-W7900/7.5

1963
PHOTOREVISED 1981
DMA 5185 U/58-SERIES 1981

IMAPS#20979