



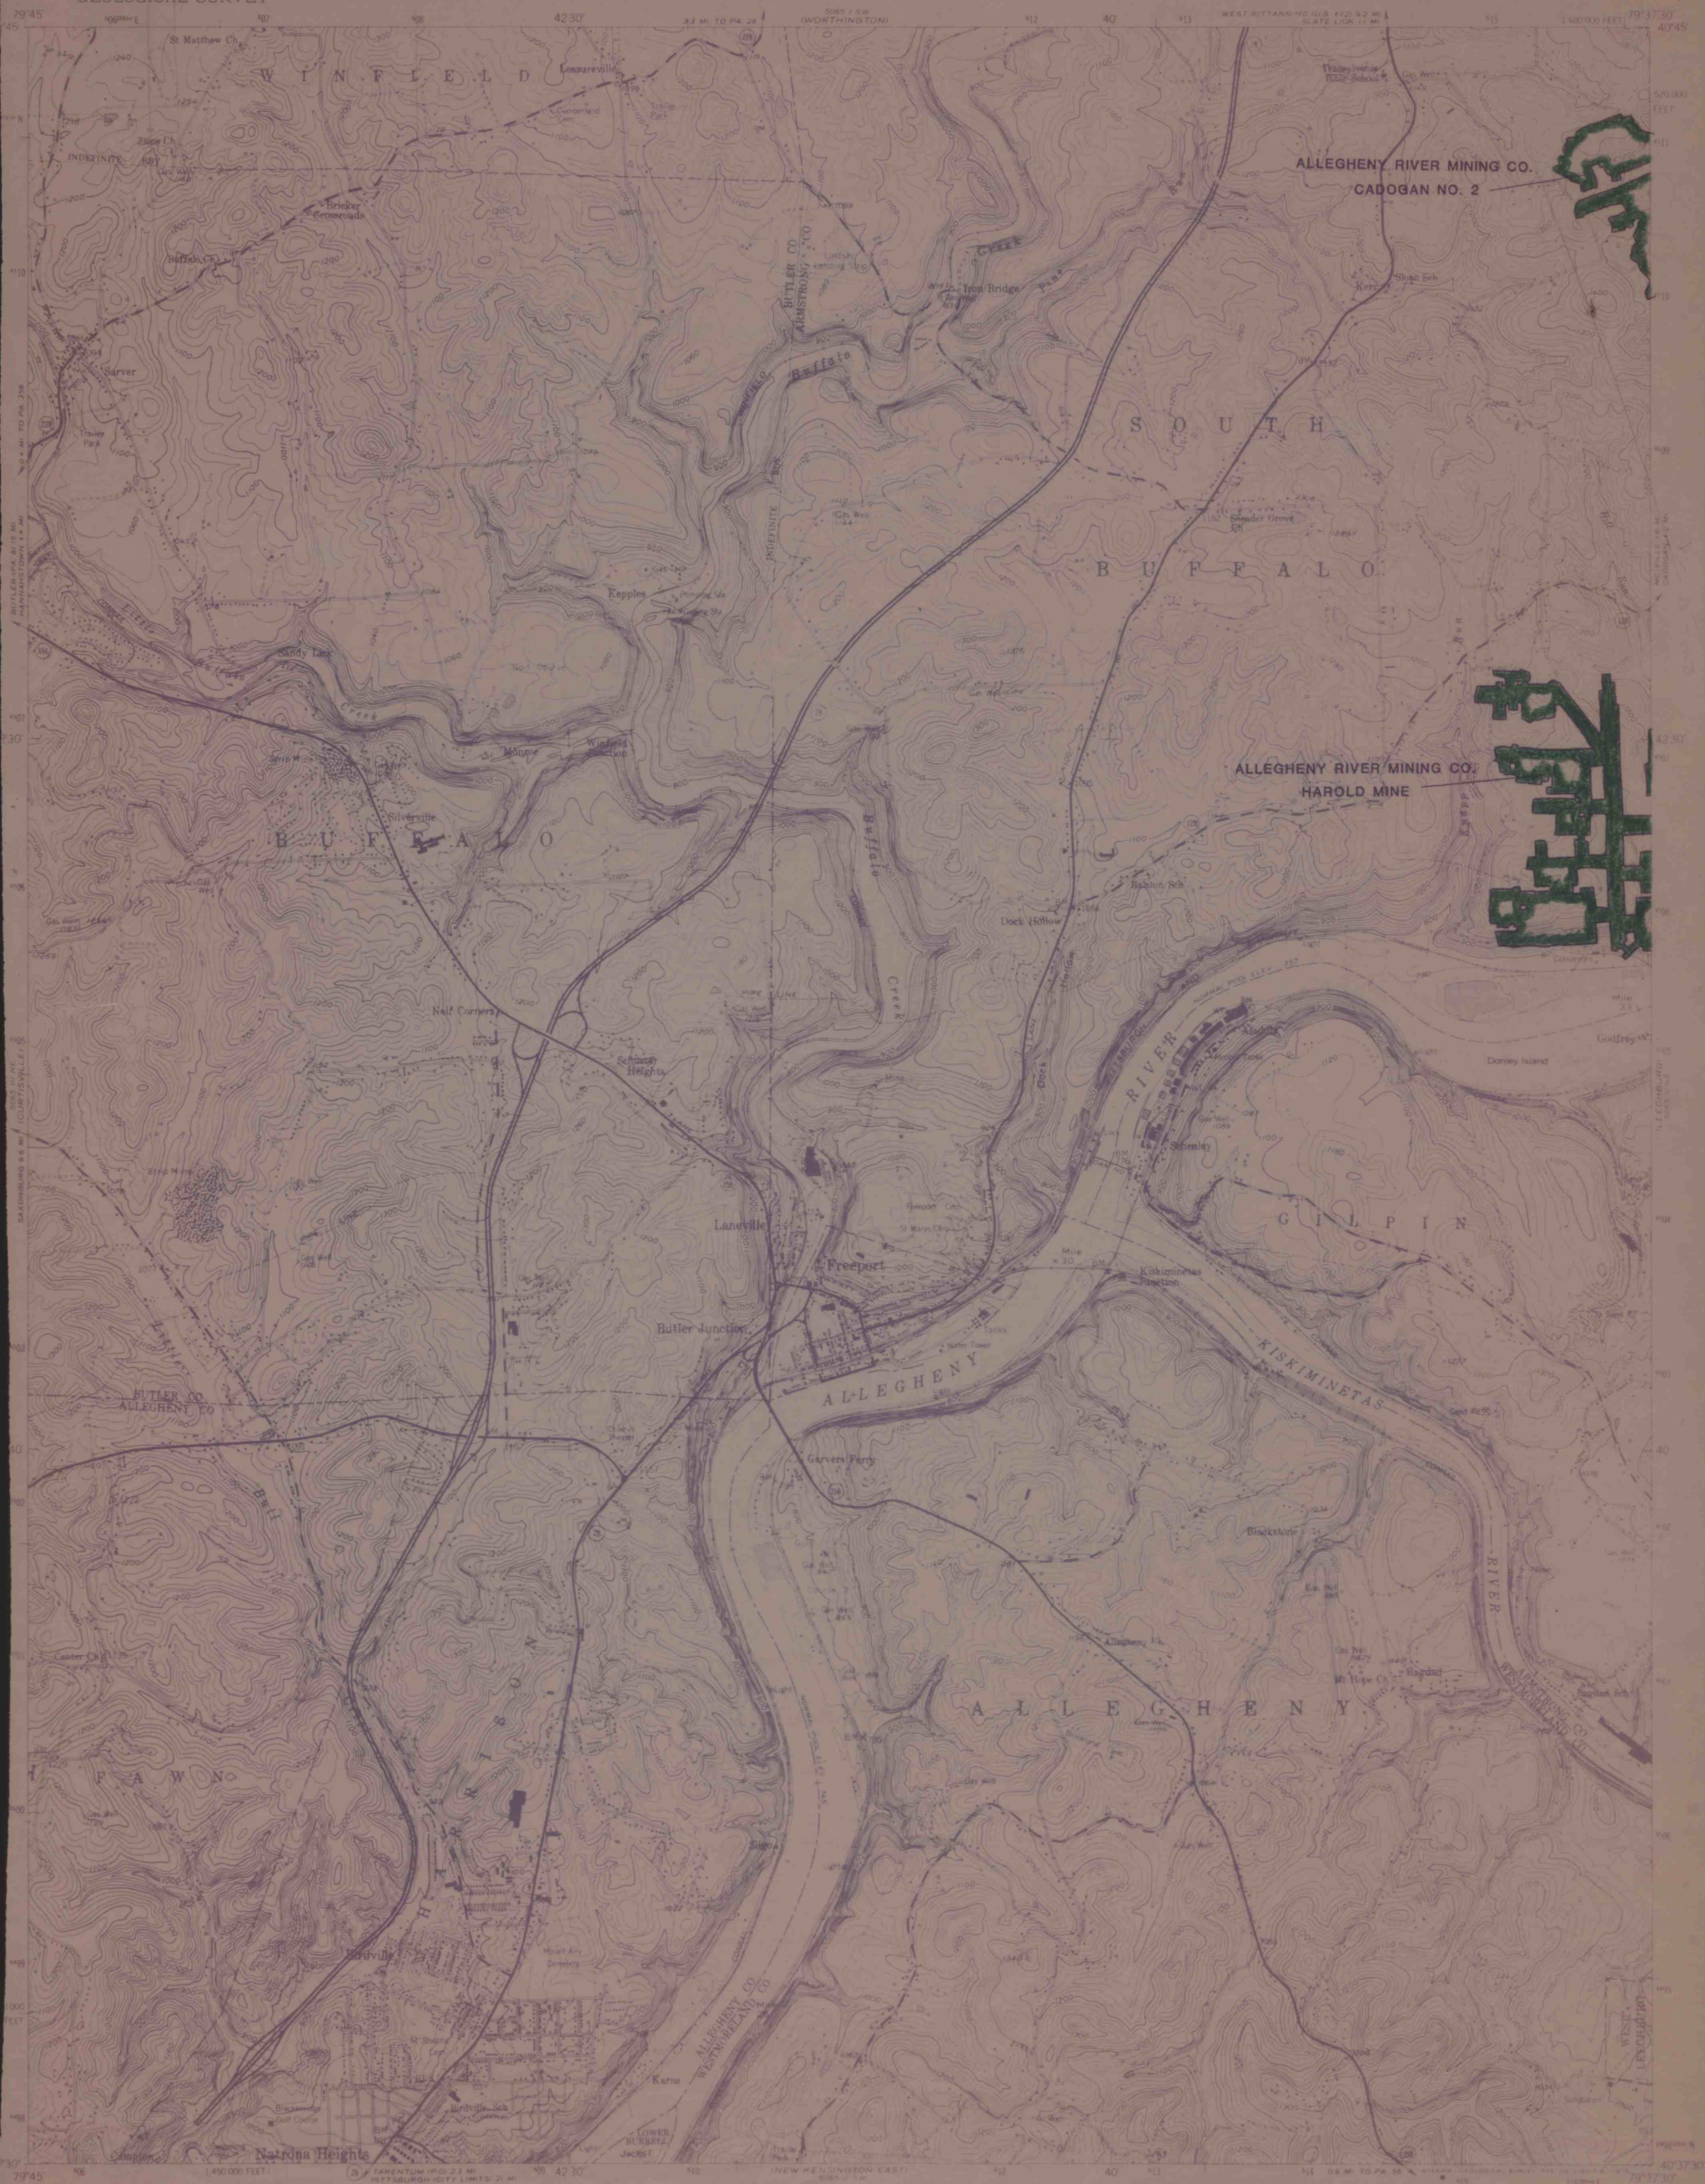


Mapped, edited, and published by the Geological Survey
Control by USGS and USC&GS
Topography from aerial photographs by multiplex methods
Aerial photographs taken 1952. Field check 1953
Polyconic projection - 1927 North American datum
10,000-foot grid based on Pennsylvania coordinate system, south zone
1000-meter Universal Transverse Mercator grid ticks, zone 17
shown in blue
To place on the predicted North American Datum 1983
move the projection lines 4 meters south and
19 meters west as shown by dashed corner ticks
Red tint indicates areas in which only landmark buildings
are shown
Revisions shown in purple compiled in cooperation with State of
Pennsylvania agencies from aerial photographs taken 1977 and other
source data. This information not field checked. Map edited 1979

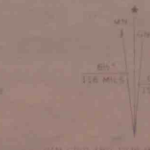

LOWER KITTANNING

ROAD CLASSIFICATION
Heavy duty ——— Light duty ———
Medium duty ——— Unimproved dirt ———
U.S. Route —○— State Route —○—

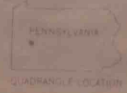

FREPORT, PA.

N4037 5 - W7937 5, 7, 5

1953
PHOTOREVISED 1979
AMS 5000 H.W. SERIES 735

IMAPS# 20987