




Note:
Original
10/9/91
McNally
E mine
is actually
part of
Friel
LF mine.

Actual mine
compiled
to 10/9/91
from RFP
maps.
Includes
Florence #2,
Florence #2D,
Heshbon D
mines.

Mapped, edited, and published by the Geological Survey
Control by USGS and USC&GS
Topography by photogrammetric methods from aerial photographs
taken 1962. Field checked 1964
Polyconic projection. 1927 North American datum
10,000-foot grid based on Pennsylvania coordinate system, south zone
1000-meter Universal Transverse Mercator grid ticks, zone 17,
shown in blue
Fine red dashed lines indicate selected fence and field lines where
generally visible on aerial photographs. Information is unchecked
Revisions shown in purple compiled in cooperation with
State of Pennsylvania agencies from aerial photographs
taken 1973. This information not field checked

IMAPS# 21000

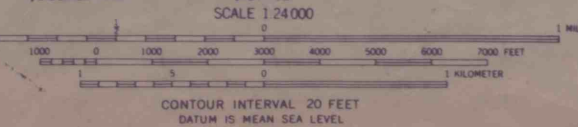

ROAD CLASSIFICATION
Heavy-duty ——— Light-duty ———
Medium-duty ——— Unimproved dirt ———
U.S. Route ——— State Route ———

UPPER FREEPORT NEW FLORENCE, PA.
LOWER FREEPORT
UPPER KITTANNING
N4022.5-W7900/7.5
1964
PHOTOREVISED 1973

290-00-015