


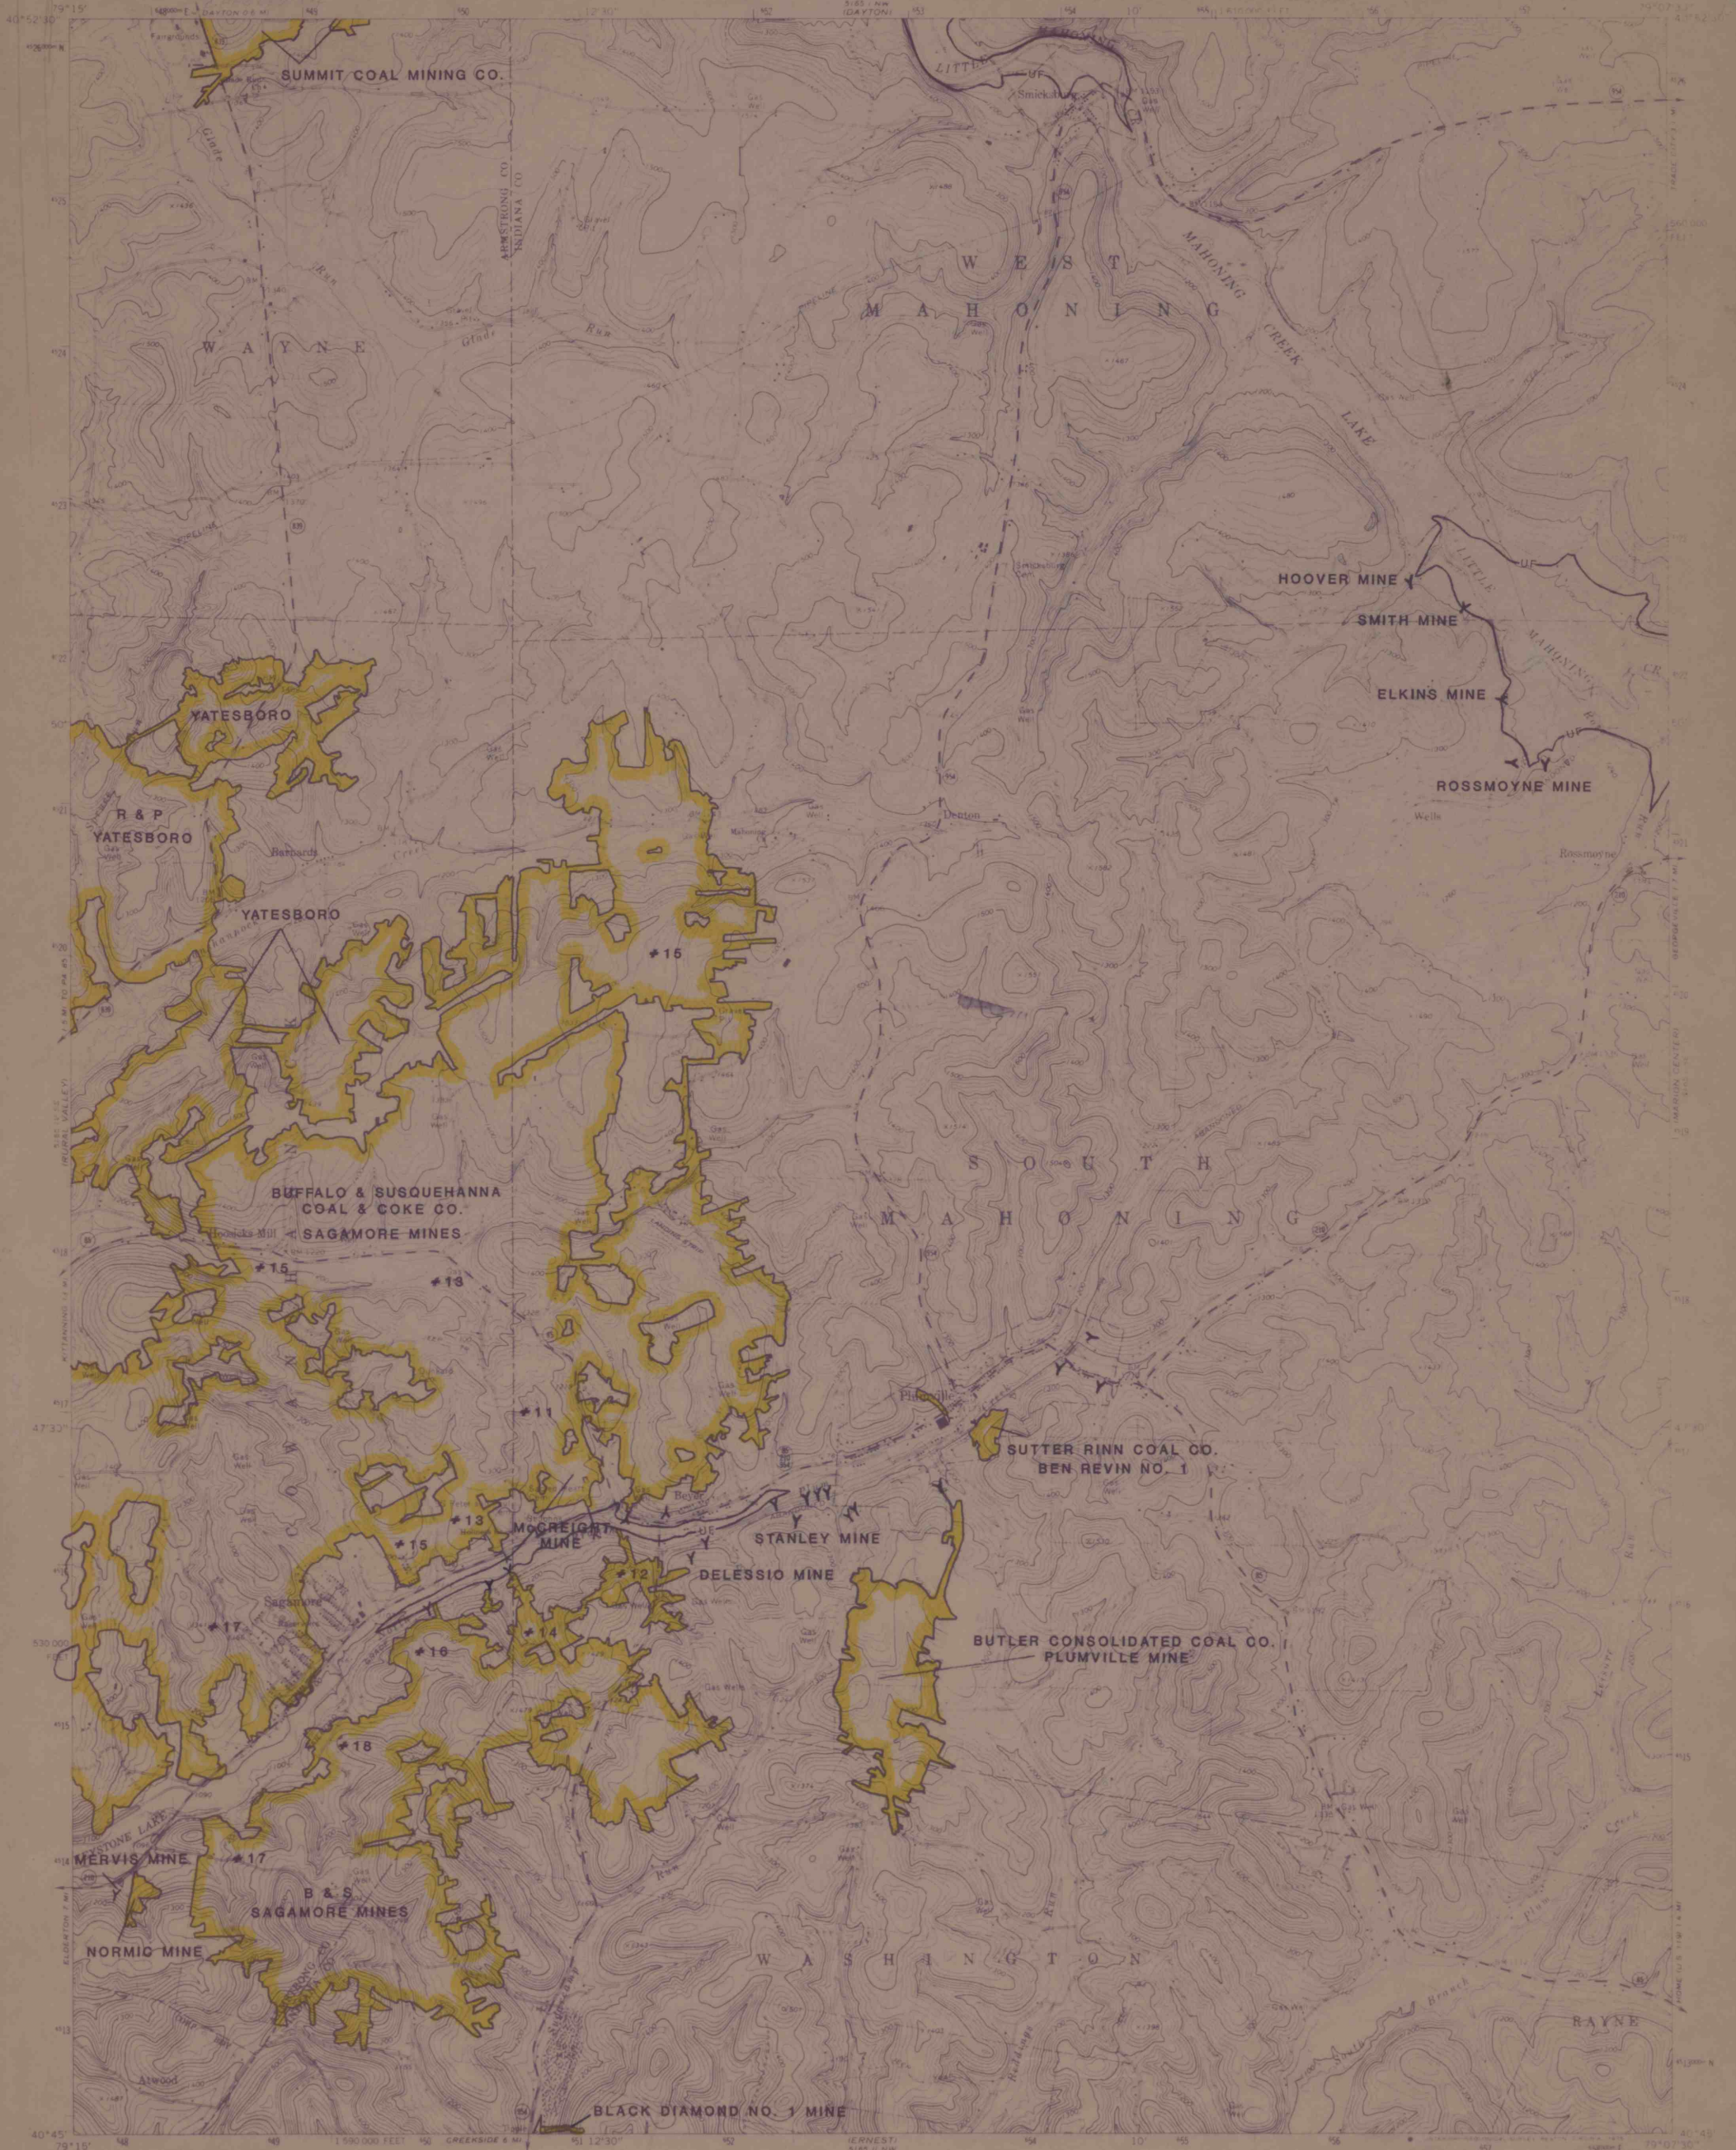

Mapped, edited, and published by the Geological Survey

Control by USGS, USCGS, and USCE

Topography by photogrammetric methods from aerial photographs taken 1967. Field checked 1968

Polyconic projection. 1927 North American datum. 10,000-foot grid based on Pennsylvania coordinate system, south zone. 1000-meter Universal Transverse Mercator grid ticks, zone 17, shown in blue.

Fine red dashed lines indicate selected fence and field lines where generally visible on aerial photographs. This information is uncheckered.

Area covered by dashed light blue pattern is subject to recheck. Information is uncheckered.

Map scale shown in feet and kilometers. 1 inch = 1 mile. 1 centimeter = 100 meters.

IMAPS#21003

SCALE 1:24,000

1 000 0 1000 2000 3000 4000 5000 6000 7000 8000 9000 10000 FEET

1 000 0 1000 2000 3000 4000 5000 6000 7000 8000 9000 10000 METERS

CONTOUR INTERVAL 20 FEET
NATIONAL GEODETIC VERTICAL DATUM OF 1989

UPPER FREEPORT

ROAD CLASSIFICATION
Secondary highway, all weather
Light duty road, all weather
Improved surface
Unimproved road, fair or dry
weather
State Route

PLUMVILLE, PA.

THIS MAP COMPILED WITH NATIONAL MAP ACTUATION STANDARDS
FOR SALE BY U.S. GEOLOGICAL SURVEY, RESTON, VIRGINIA 20192
A FOLDER OF TOPOGRAPHIC MAPS AND SYMBOLS IS AVAILABLE ON REQUEST