


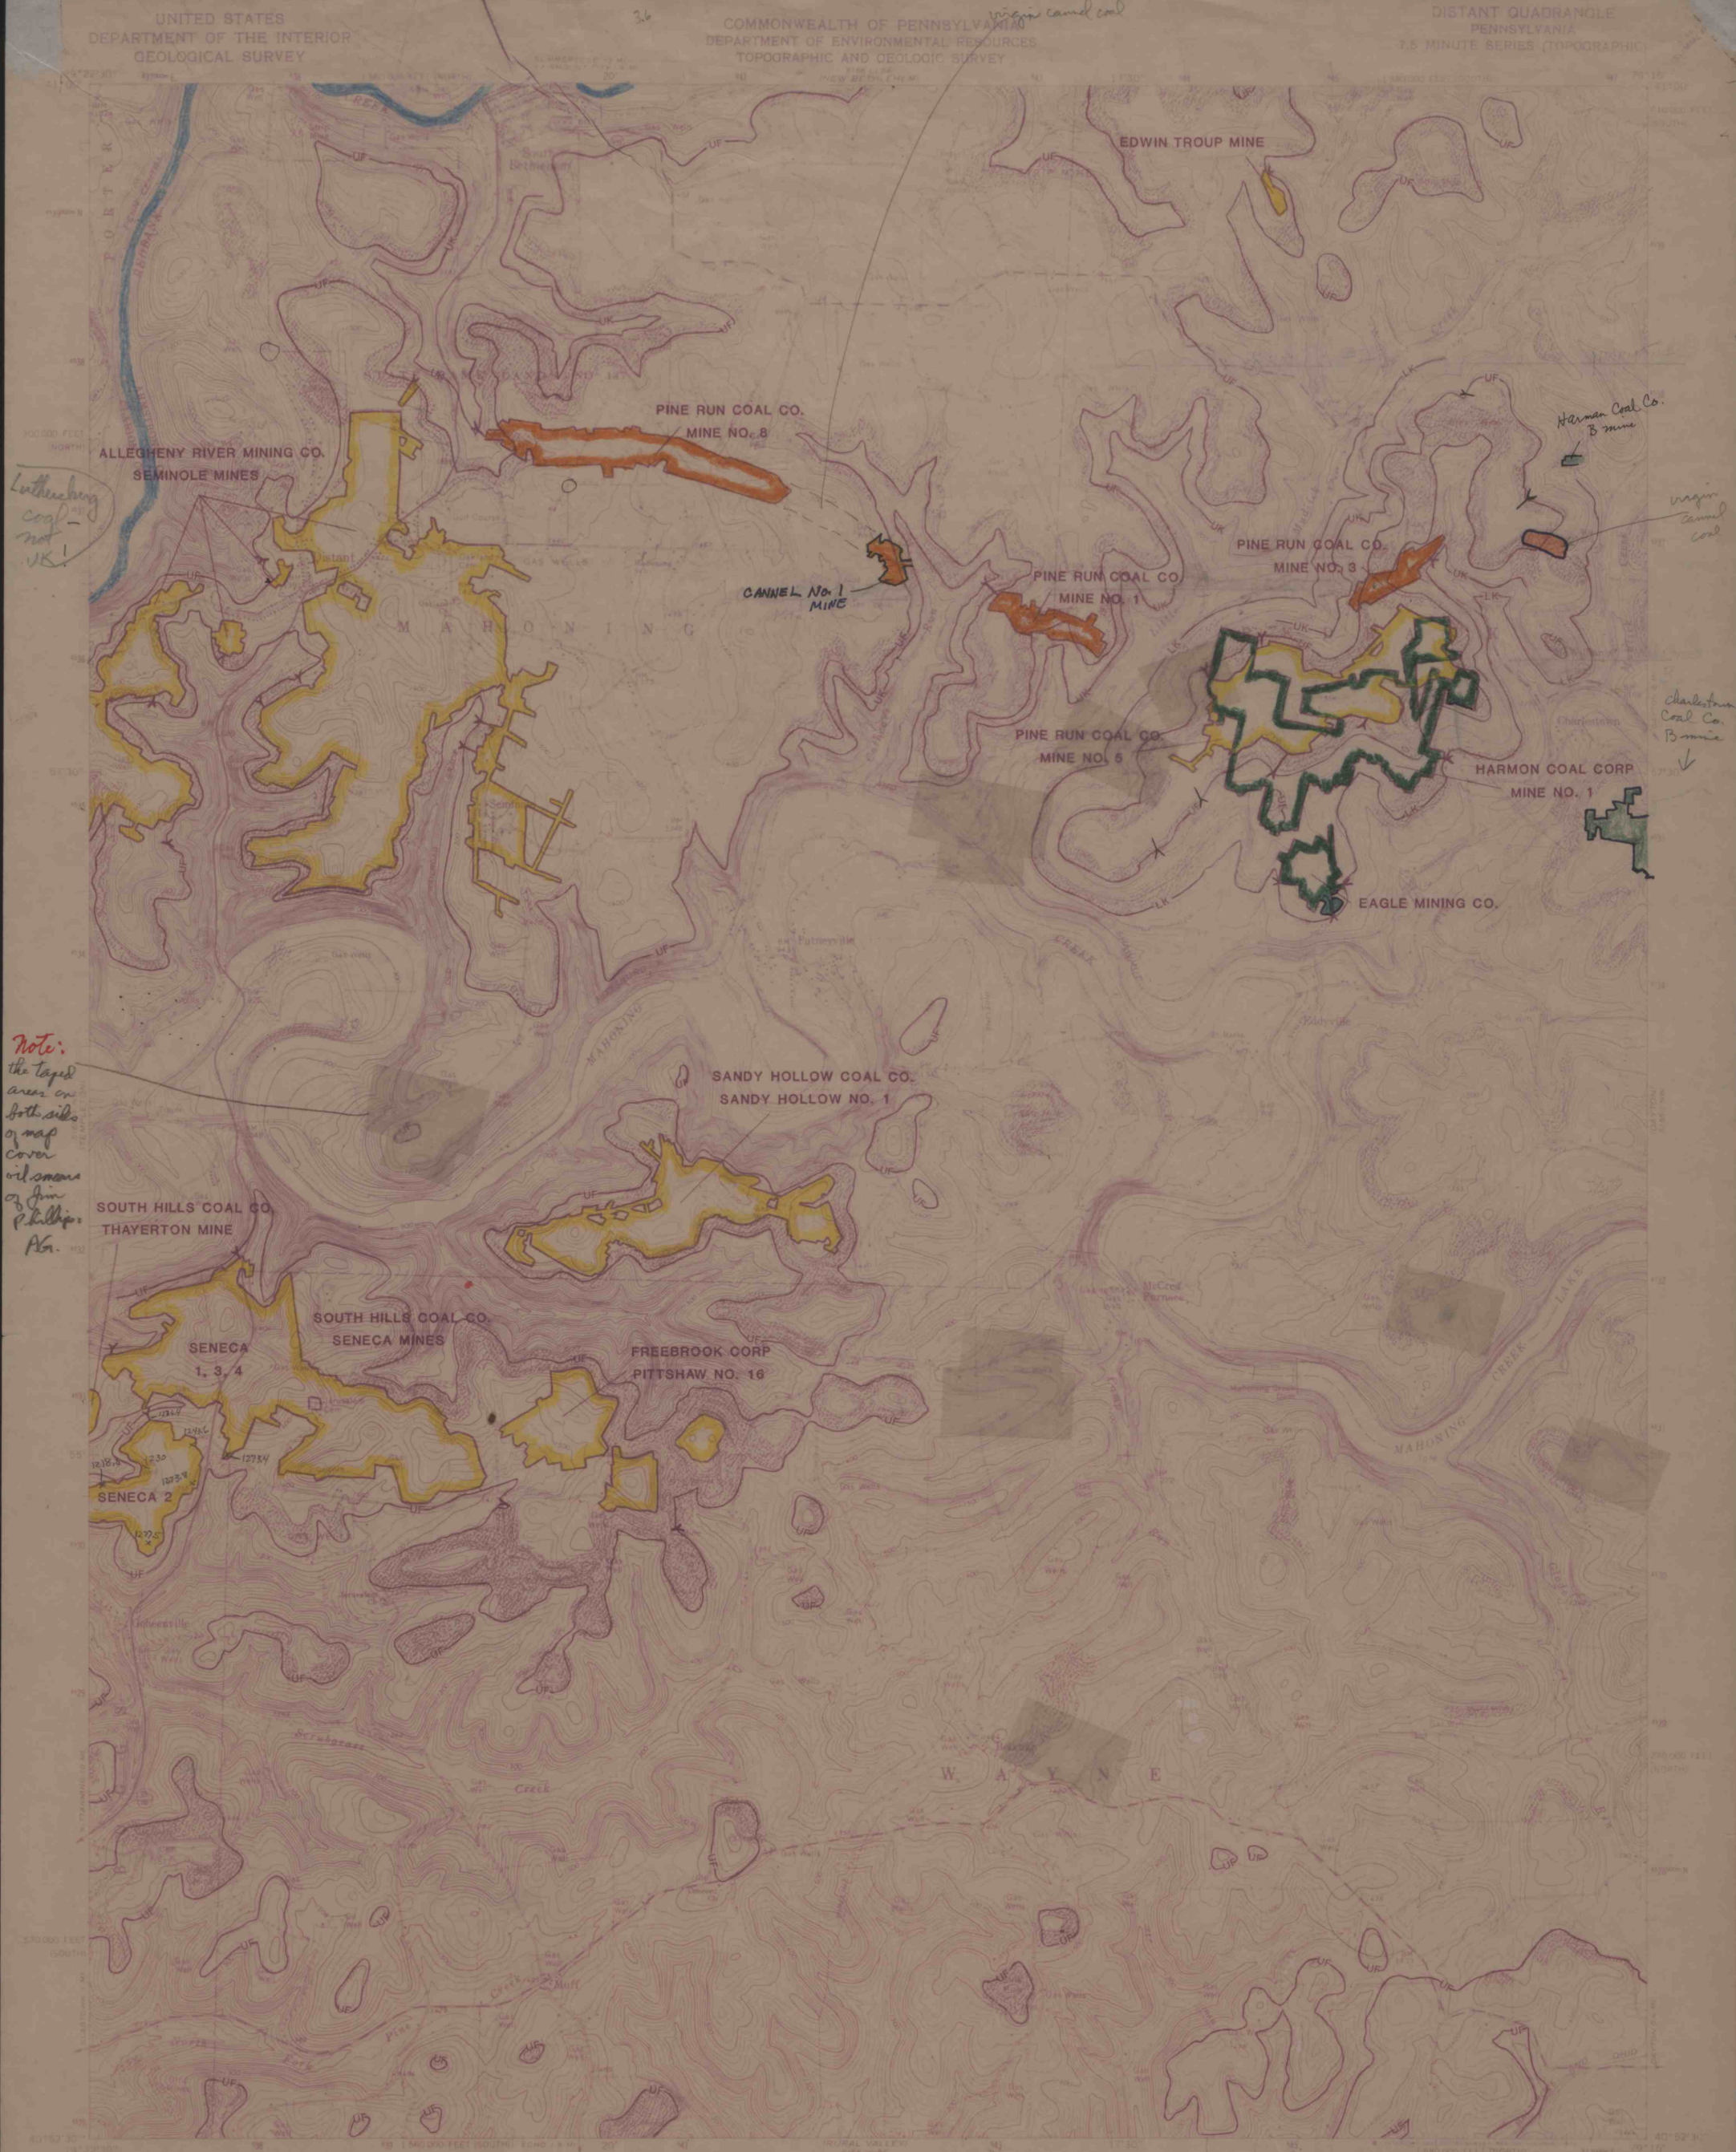

Note:
the taped
areas on
both sides
of map
cover
oil seams
of Jim
Phillips
AG.

Luthenberg
coal
not
UK!