



Note:
the taped
area on both
sides of road
cover the
old stream
in
Phillip
Ala

updated
A.L. Light Special
Francis No. 5 E
mine
7/97
Ala

Mapped, edited, and published by the Geological Survey

Control by USGS and NOS/NOAA

Topography by photogrammetric methods from aerial

photographs taken 1967. Field checked 1968

Polyconic projection, 10,000-foot grid ticks based on

Pennsylvania coordinate system, north and south zones

1000-meter Universal Transverse Mercator grid ticks,

zone 17, shown in blue. 1927 North American Datum

To place on the predicted North American Datum 1983

move the projection lines 4 meters south and



21 meters west as shown by dashed corner ticks

Fine red dashed lines indicate selected fence and field

lines where generally visible on aerial photographs.

This information is unchecked

1 MAPS # 21015

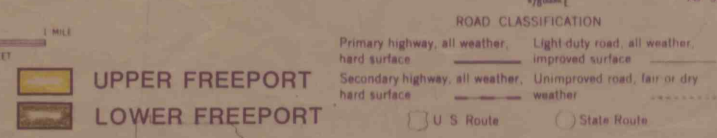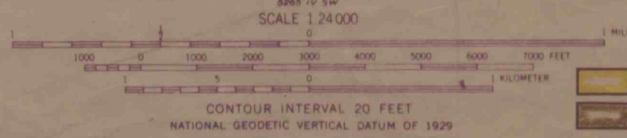

Revisions shown in purple compiled in cooperation with
Commonwealth of Pennsylvania agencies from aerial
photographs taken 1977 and other sources. This
information not field checked. Map edited 1981

PUNXSUTAWNEY, PA.
N4052 5--W7852 5/7 5
1968
PHOTOREVISED 1981
DMA 5265 IVNW SERIES VBS1