


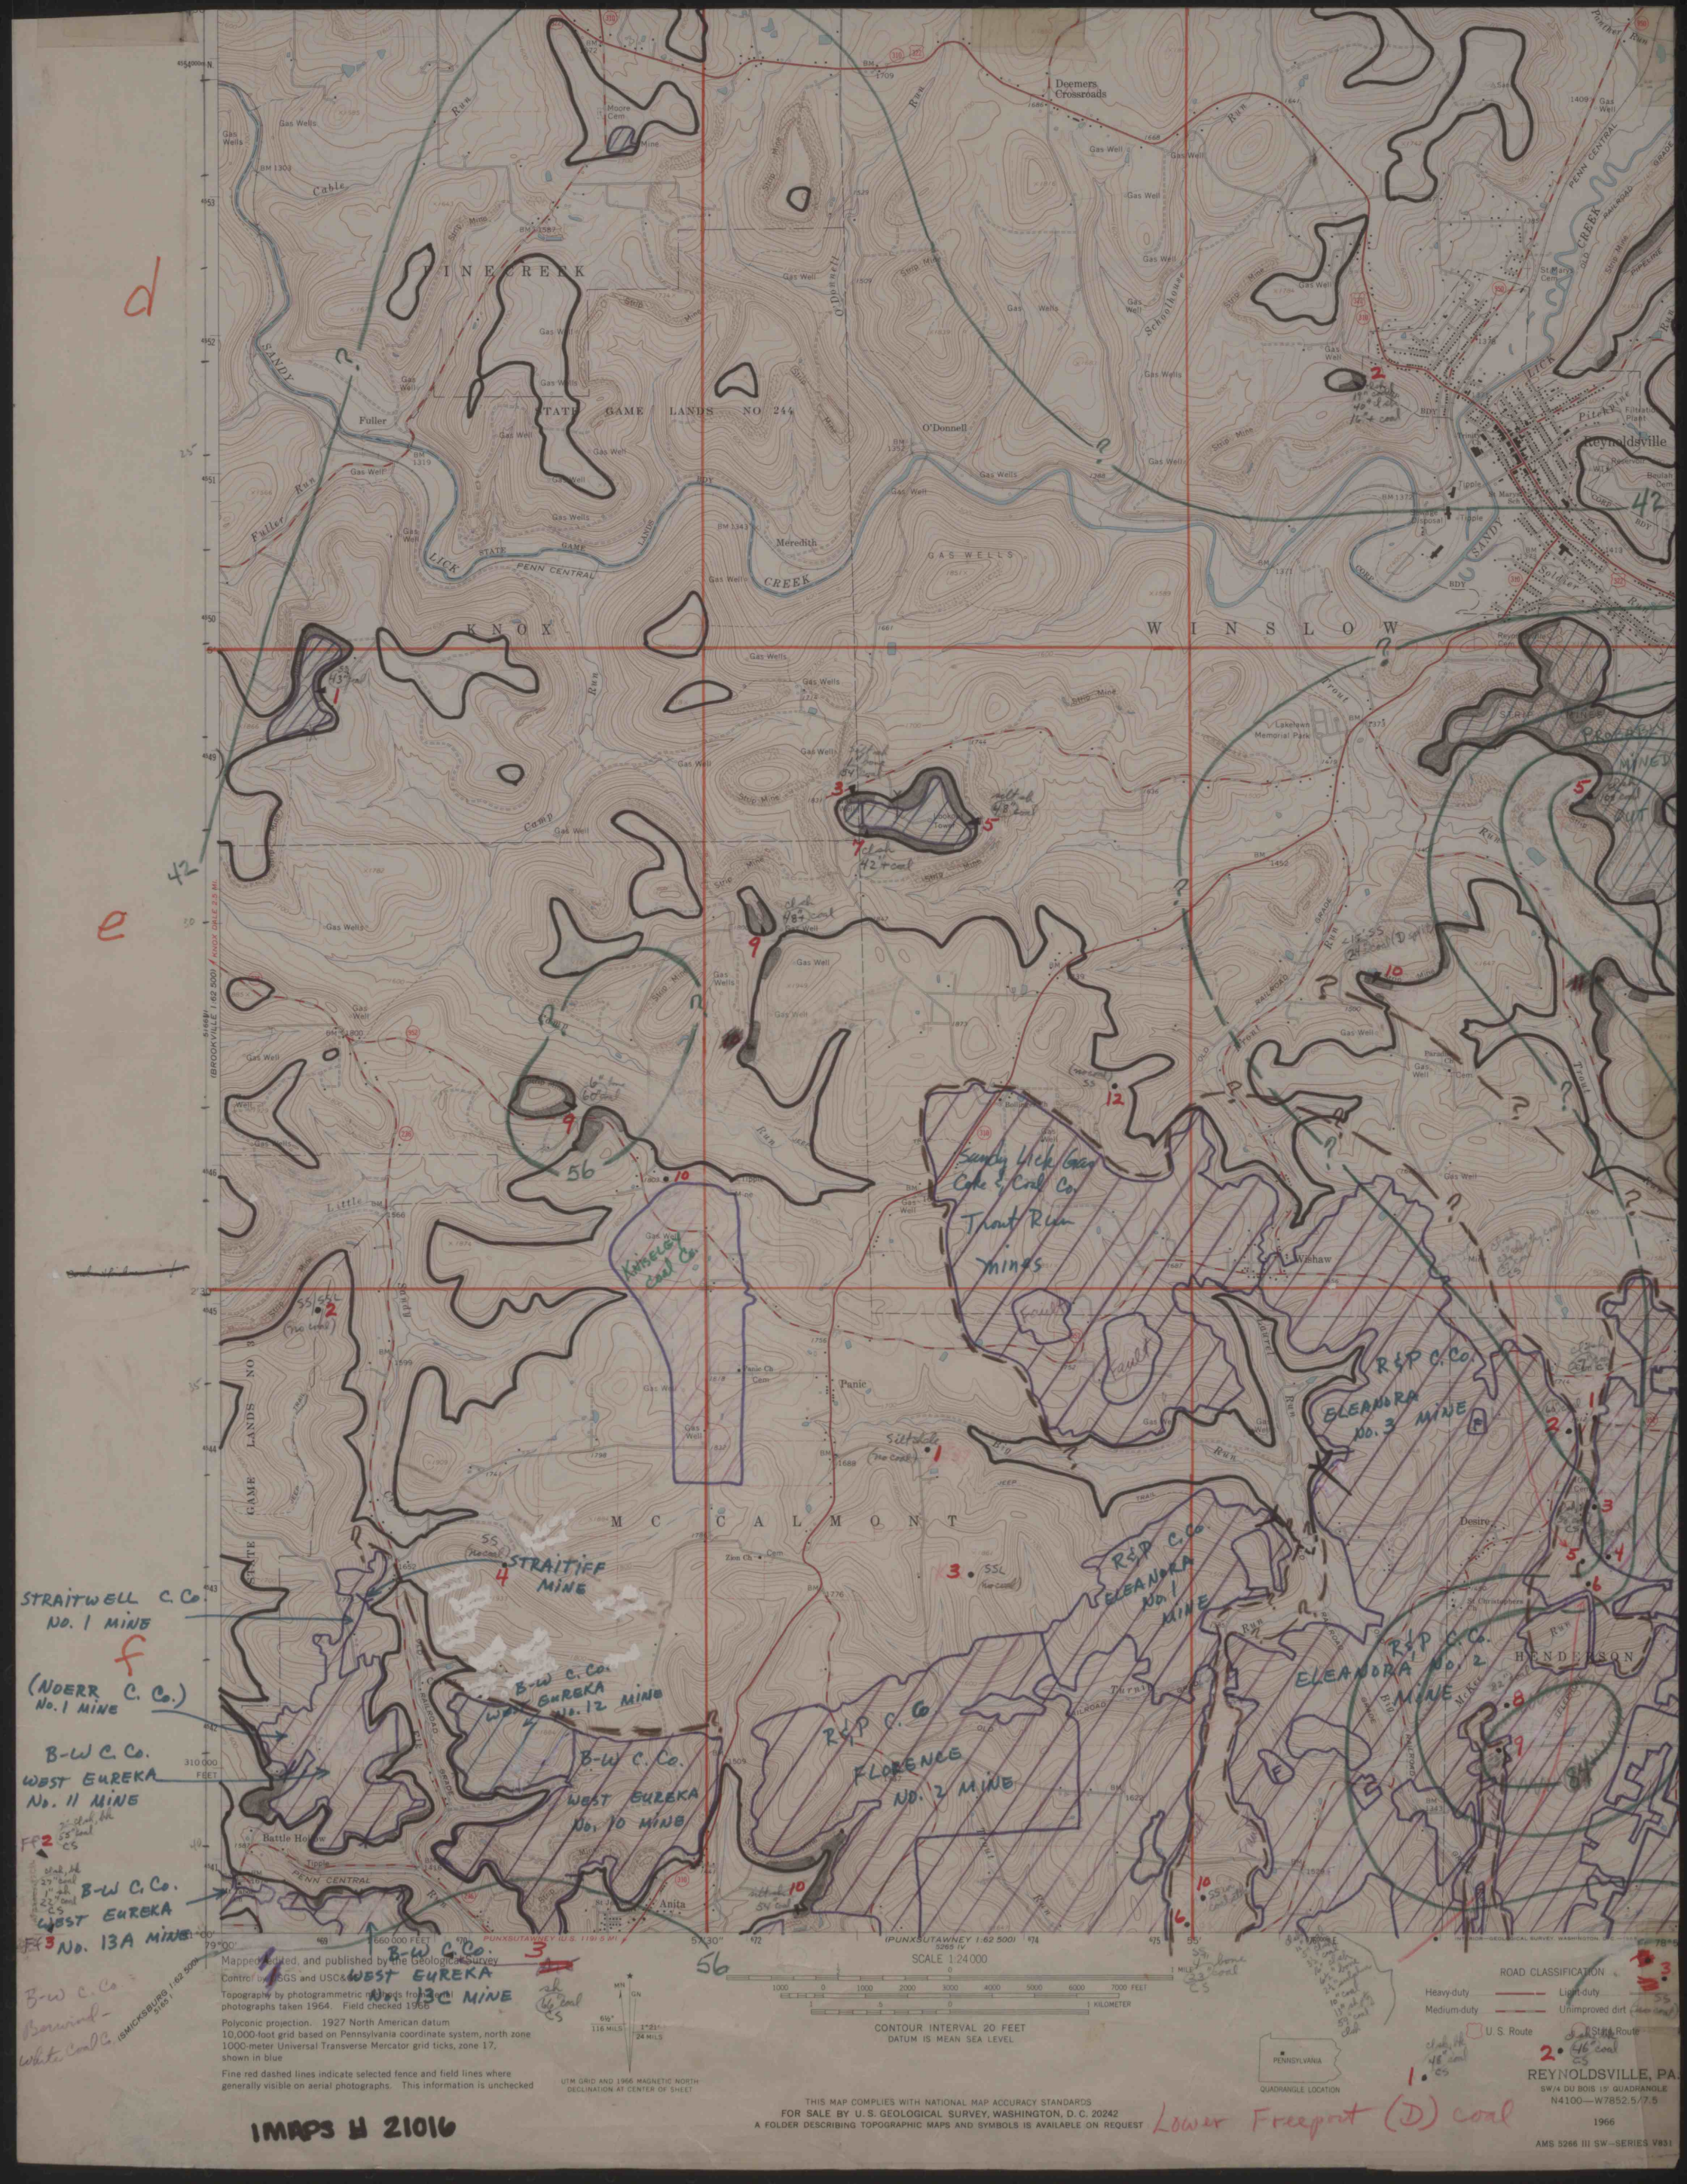

STRAITWELL C. Co.
NO. 1 MINE
(NOERR C. Co.)
No. 1 MINE
B-W C. Co.
WEST EUREKA
No. 11 MINE
B-W C. Co.
WEST EUREKA
No. 13A MINE

B-W C. Co.
Bourne-
White Coal Co.

Map published and published by the Geological Survey
Control by USGS and USGS
Topography by photogrammetric methods from aerial
photographs taken 1964. Field checked 1965
Polyconic projection. 1927 North American datum
10,000-foot grid based on Pennsylvania coordinate system, north zone
1000-meter Universal Transverse Mercator grid ticks, zone 17,
shown in blue
Fine red dashed lines indicate selected fence and field lines where
generally visible on aerial photographs. This information is unchecked

UTM GRID AND 1966 MAGNETIC NORTH
DECLINATION AT CENTER OF SHEET

SCALE 1:24,000
CONTOUR INTERVAL 20 FEET
DATUM IS MEAN SEA LEVEL

ROAD CLASSIFICATION
Heavy-duty
Medium-duty
Light-duty
Unimproved dirt

U.S. Route
State Route

REYNOLDSVILLE, PA.
SW/4 DU BOIS 15' QUADANGLE
N4100-W7852.5/7.5

1966
AMS 5266 III SW-SERIES V831

IMPS H 21016

THIS MAP COMPLIES WITH NATIONAL MAP ACCURACY STANDARDS
FOR SALE BY U.S. GEOLOGICAL SURVEY, WASHINGTON, D.C. 20242
A FOLDER DESCRIBING TOPOGRAPHIC MAPS AND SYMBOLS IS AVAILABLE ON REQUEST

Lower Freeport (D) coal