

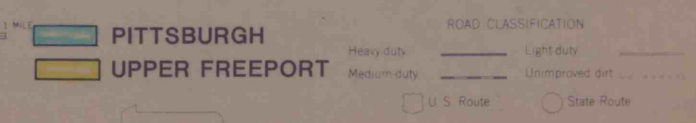


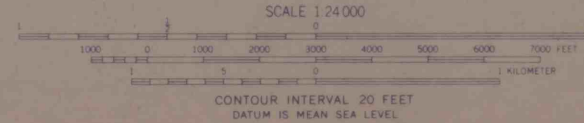

Notes:
Boundaries of
old tunnelton
and marion
mines in
Ind. County
updated
10/91
A.G.

Mapped, edited, and published by the Geological Survey
Control by USGS, USC&GS, and USCE
Topography by photogrammetric methods from aerial photographs
taken 1962. Field checked 1964.
Polyconic projection. 1927 North American datum
10,000-foot grid based on Pennsylvania coordinate system, south zone
1000-meter Universal Transverse Mercator grid ticks,
zone 17, shown in blue.
Fine red dashed lines indicate selected fence and field lines where
generally visible on aerial photographs. This information is unchecked.
U. S. Reservation boundary from maps by U. S. Corps of Engineers
Area covered by dashed light-blue pattern is subject to
controlled inundation.

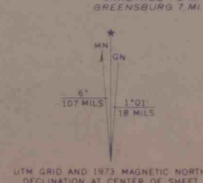

THIS MAP COMPLIES WITH NATIONAL MAP ACCURACY STANDARDS
FOR SALE BY U. S. GEOLOGICAL SURVEY, WASHINGTON, D. C. 20242
A FOLDER DESCRIBING TOPOGRAPHIC MAPS AND SYMBOLS IS AVAILABLE ON REQUEST

Revisions shown in purple compiled in cooperation with
State of Pennsylvania agencies from aerial photographs
taken 1973. This information not field checked.

IMAPS # 21021

SALTSBURG, PA.
N4022 5—W7922 5/7.5
1964
PHOTOREVISED 1973
AMS 5164 IV NW—SERIES W831