


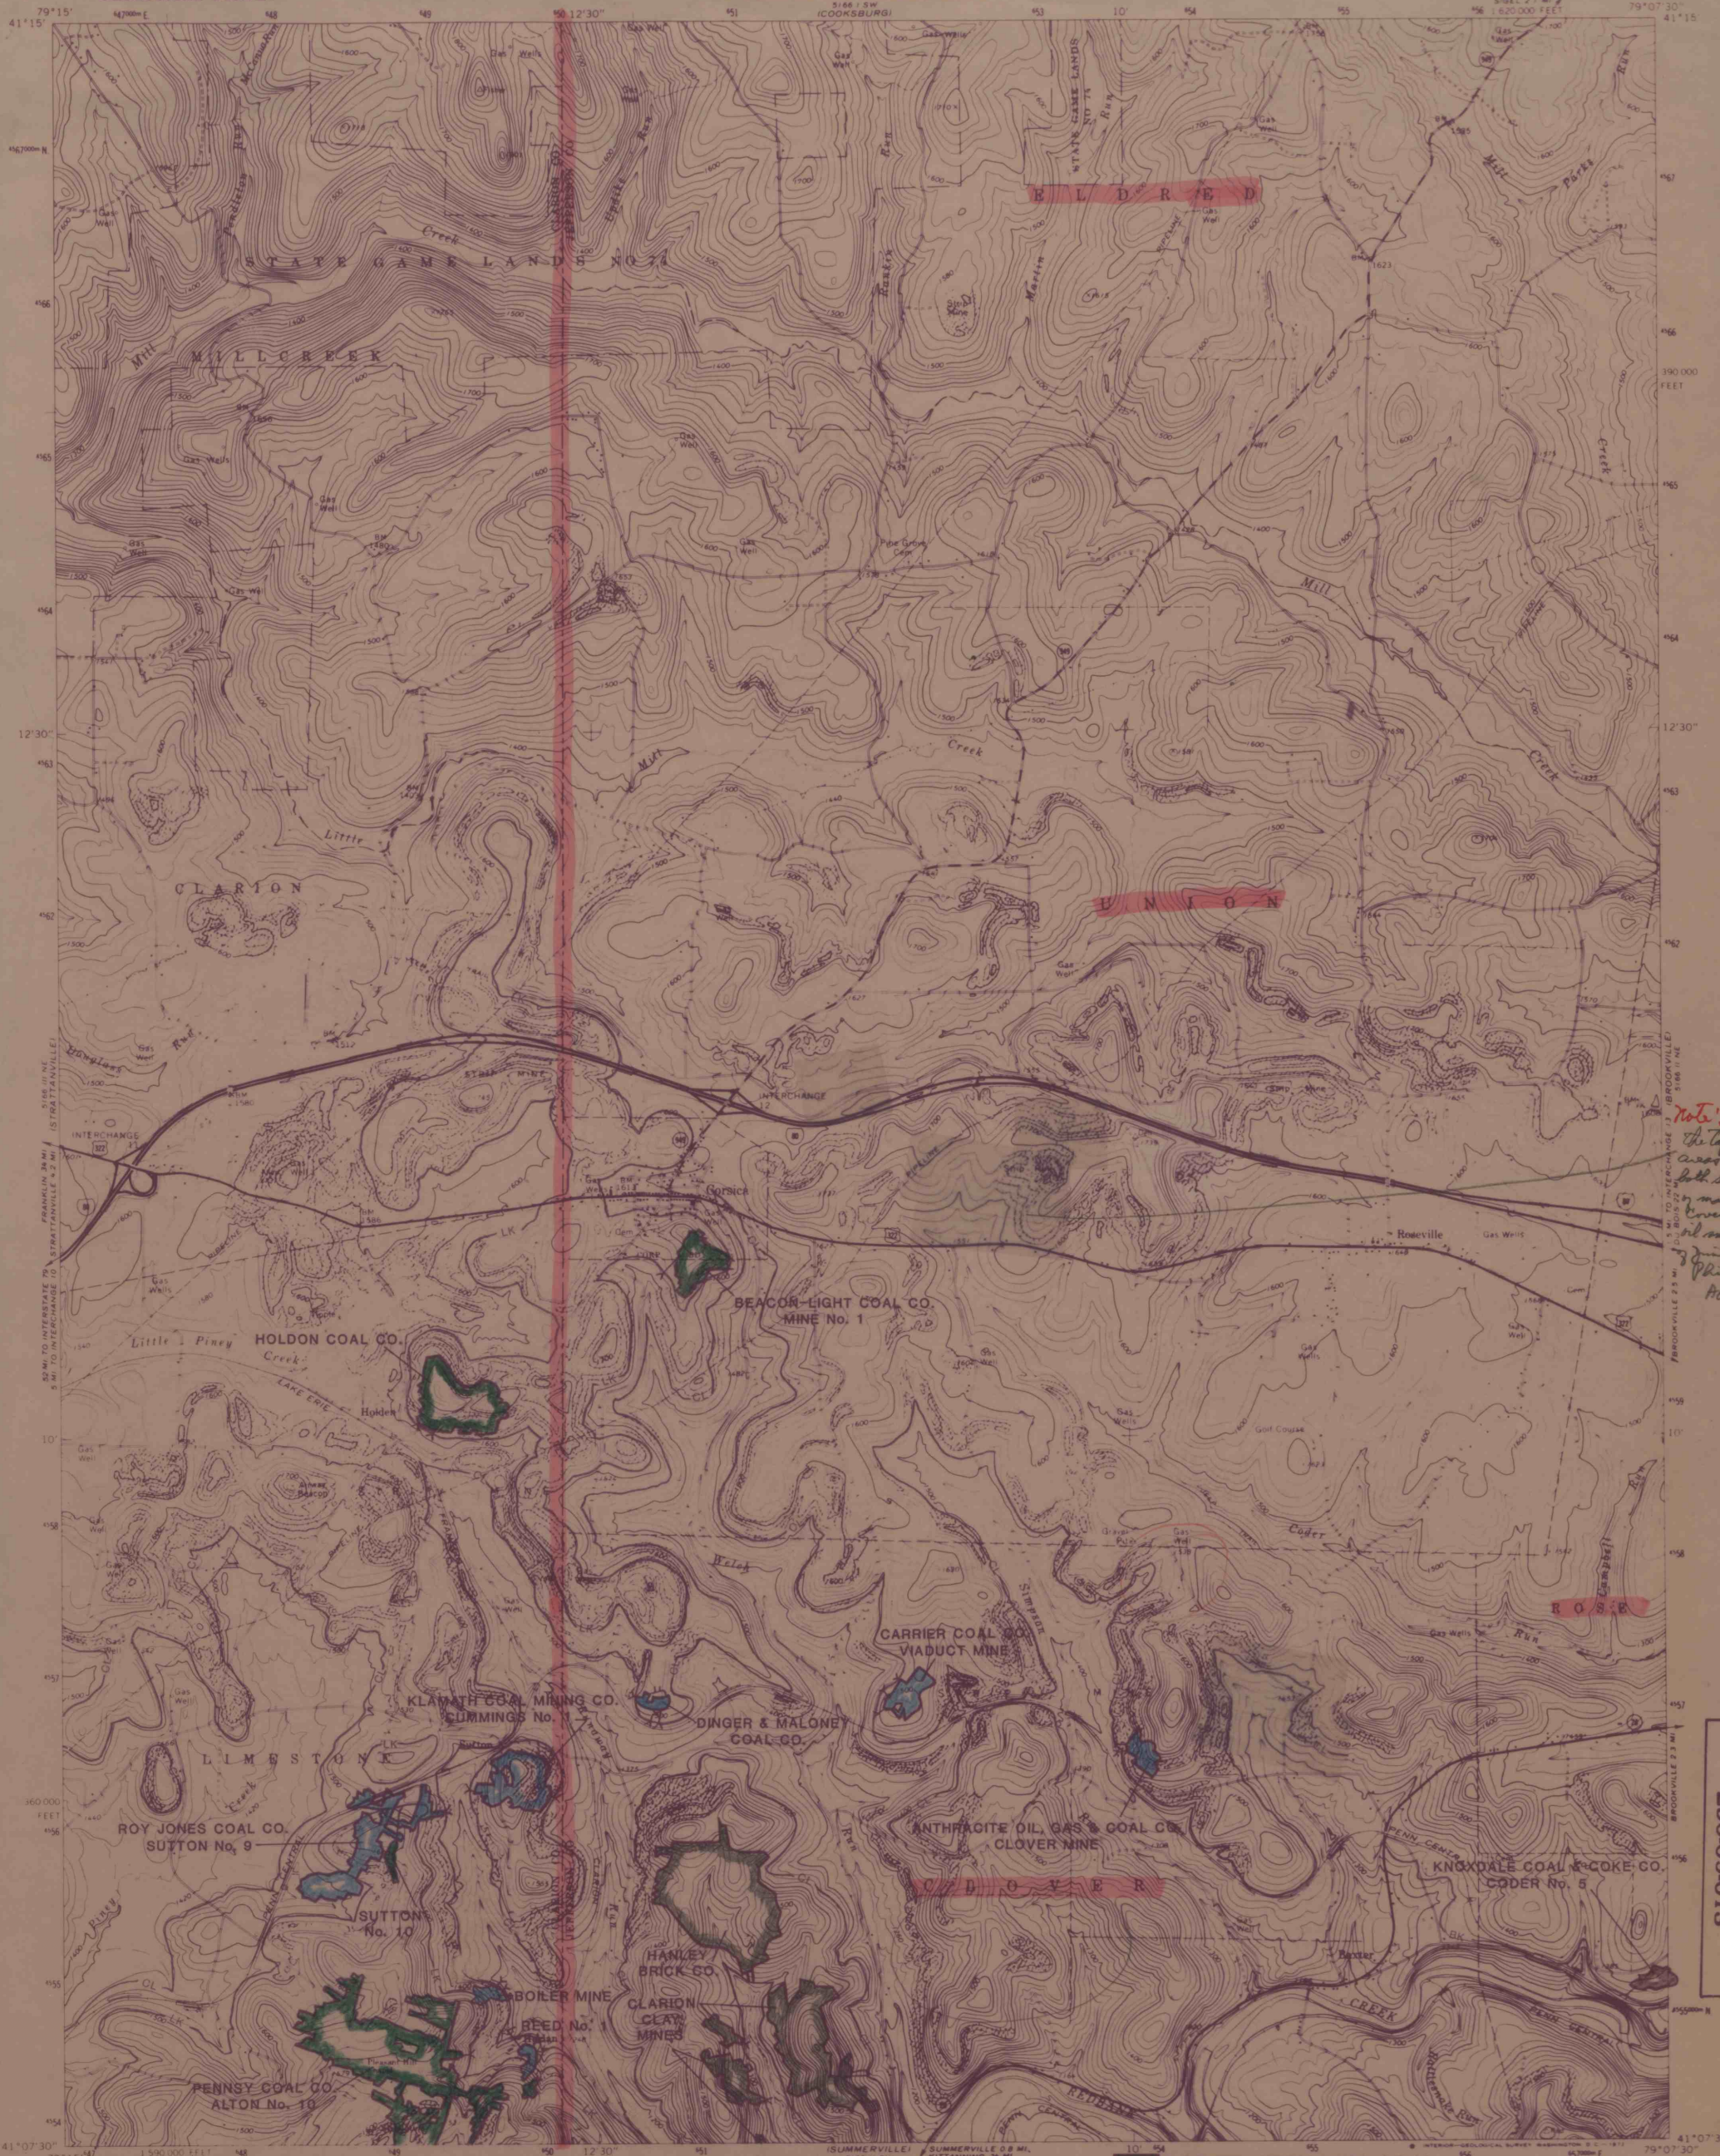

Note:
The top of
areas on
both sides
of map
are
Phillips
H6

Authorization
290-00-015

Mapped, edited, and published by the Geological Survey,
Control by USGS and USCGS
Topography by photogrammetric methods from aerial
photographs taken 1967. Field checked 1969.
Polyconic projection. 1927 North American datum.
10,000-foot grid based on Pennsylvania coordinate system, north zone.
1000-meter Universal Transverse Mercator grid, zone 18,
shown in blue.
Fine red dashed lines indicate selected fence and field lines where
generally visible on aerial photographs. This information is on the
original map.

IMAPS # 21030



LOWER KITTANNING COAL	ROAD CLASSIFICATION
CLARION COAL	Primary highway, hard surface
CLARION CLAY	Secondary highway, hard surface
BROOKVILLE COAL	Unimproved road
	Interstate Route
	U S Route
	State Route

THIS MAP COMPLIES WITH NATIONAL MAP ACCURACY STANDARDS
FOR SALE BY U.S. GEOLOGICAL SURVEY, WASHINGTON, D.C. 20242
A FOLDER DESCRIBING TOPOGRAPHIC MAPS AND SYMBOLS IS AVAILABLE ON REQUEST

CORSICA, PA.
NW 1/4 BROOKVILLE 15 QUADRANGLE
N4107 5 - W7907 5: 7.5
1969

AMS 5188 II NW - SERIES V831