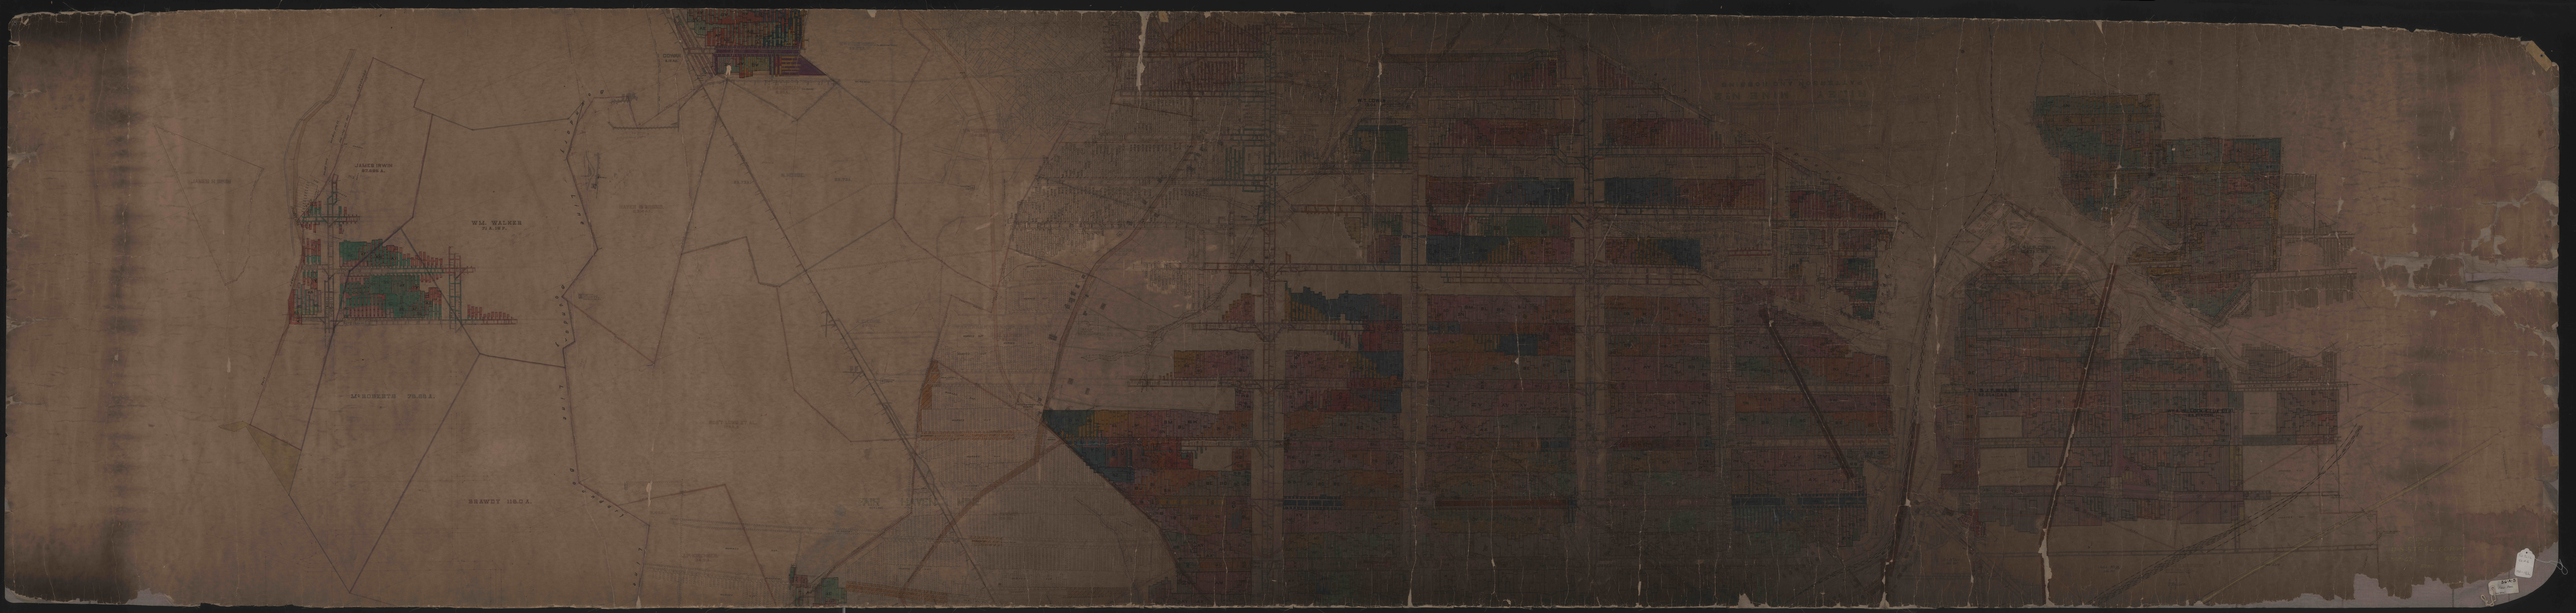
JAMES IRWIN
WM. WALKER
Mr ROBERTS 75.3/4 A.
BRAWBY 118 A.