


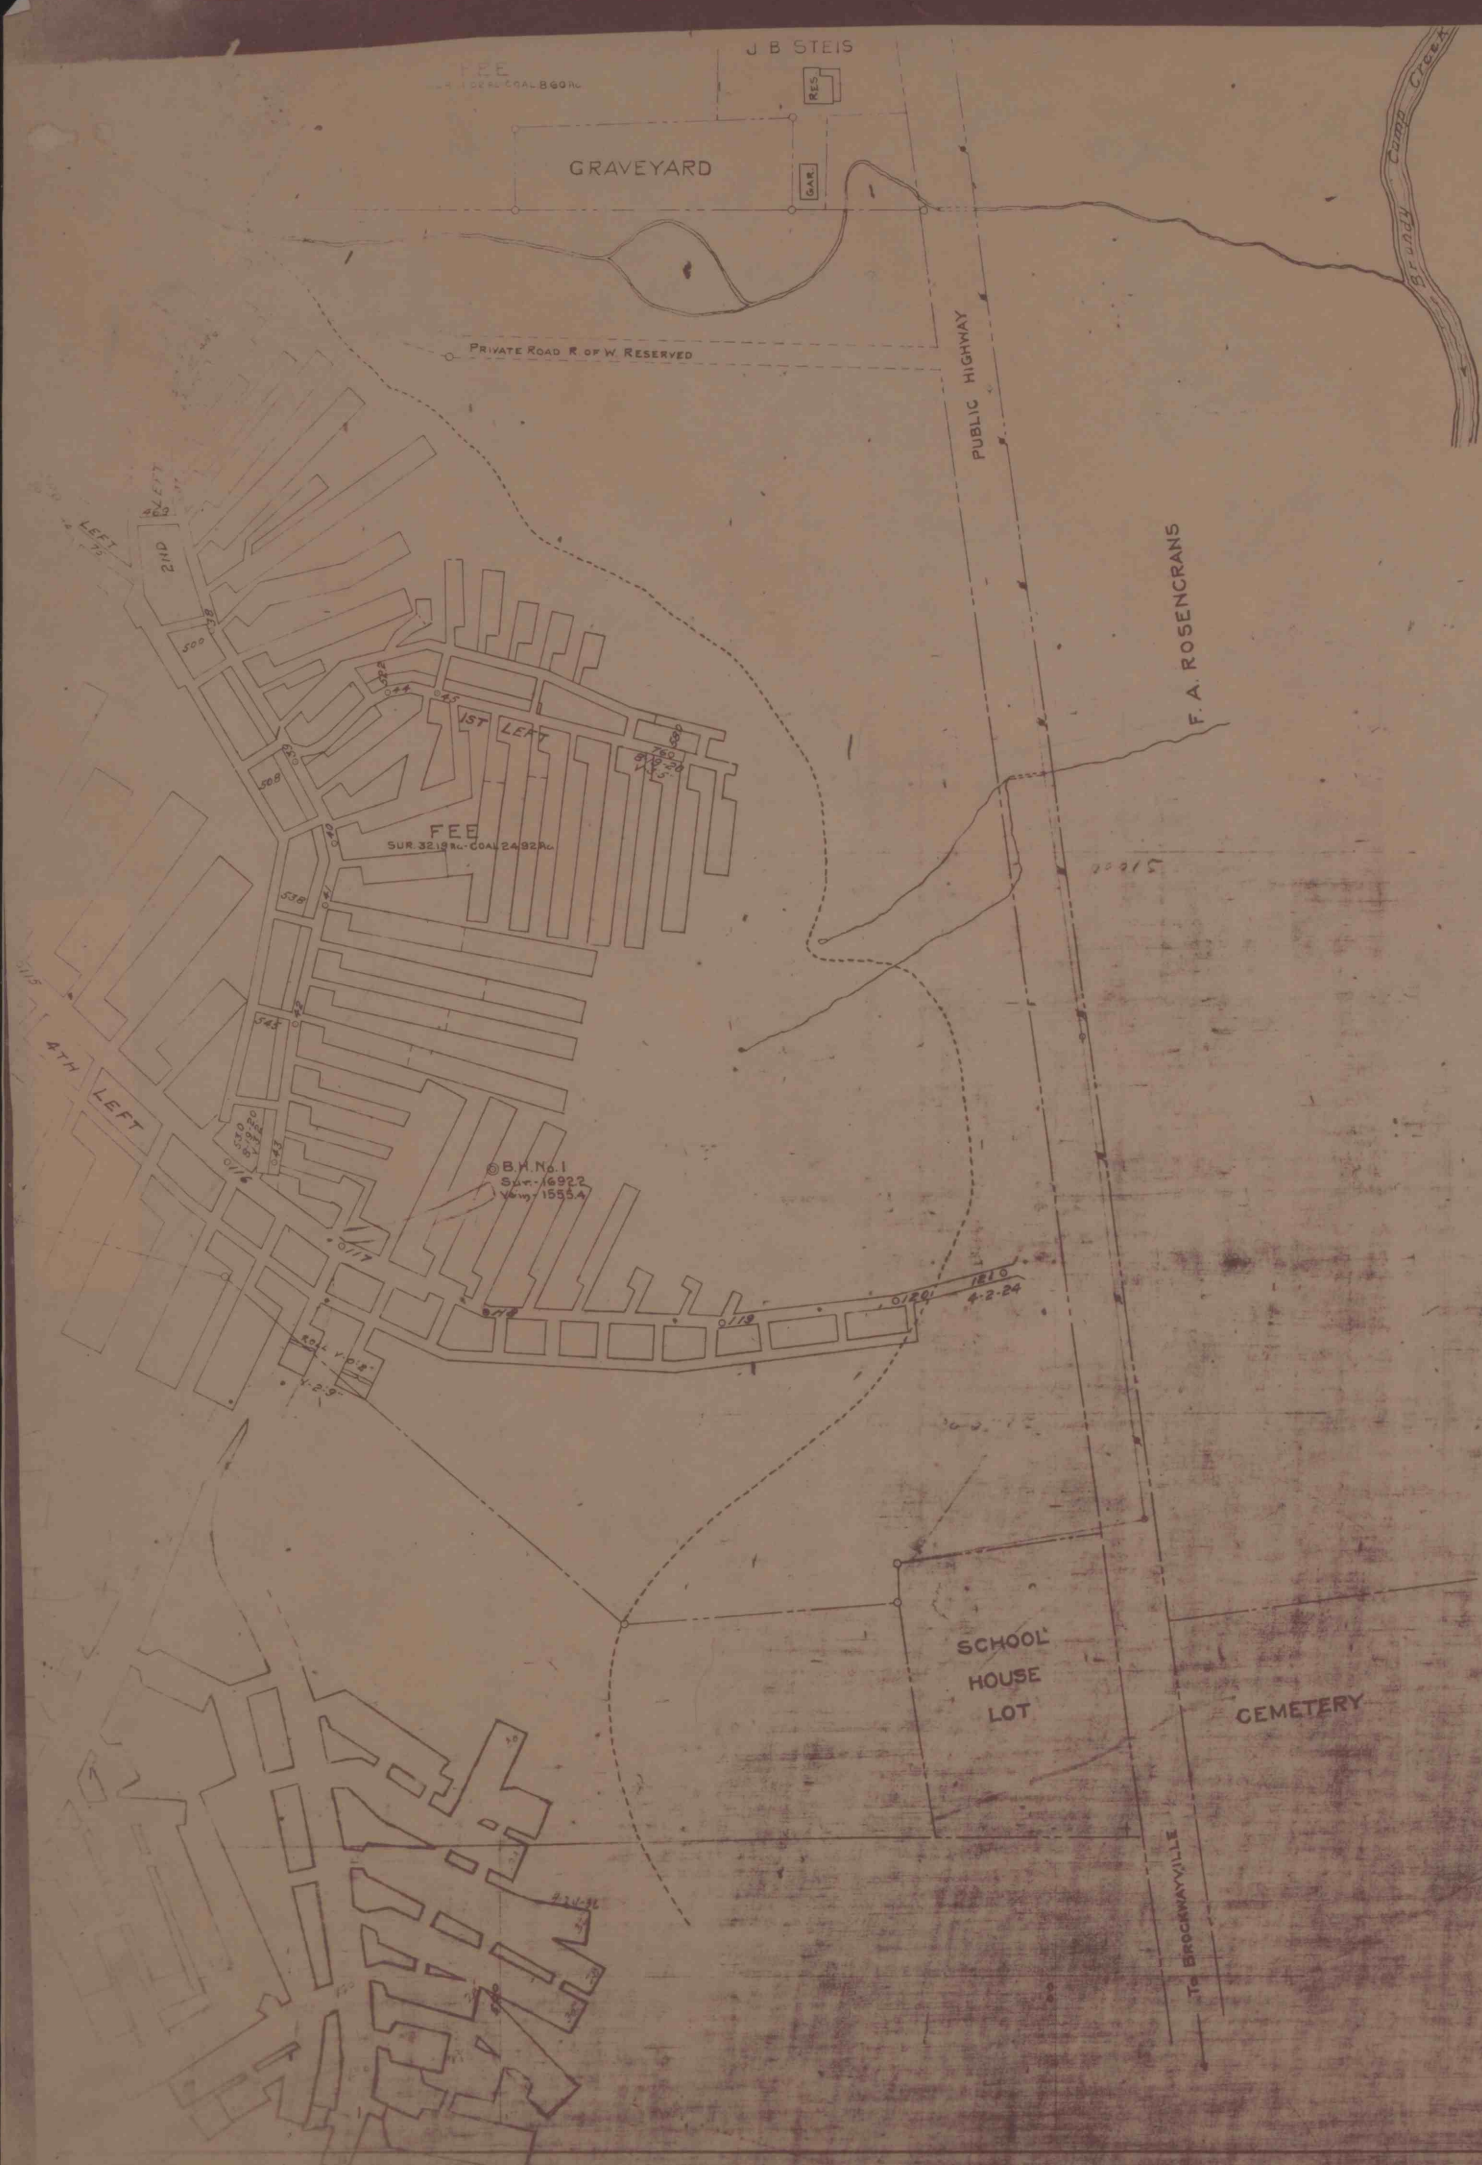

ELK MINE

ELK COAL COMPANY

ELBON-ELK CO. - PA.

SCALE: 1 IN. = 100 FT.

— LEGEND —

Property Lines	Telephone or Power Pole
Crop Lines	Overcast
Iron for Property Cor.	Door
Survey Survey	Regulator

SURVEY DATE

5-21-18 - 9-18-18 - 4-27-19 - 8-19-20.
12-26-22 - 4-2-24 - 8-19-24
FEB. 1925 -
3-27-29 - 2-18-30 - 7-10-30
10-29-30 - 2-24-31 - 4-23-31
11-2-37 - 4-8-38