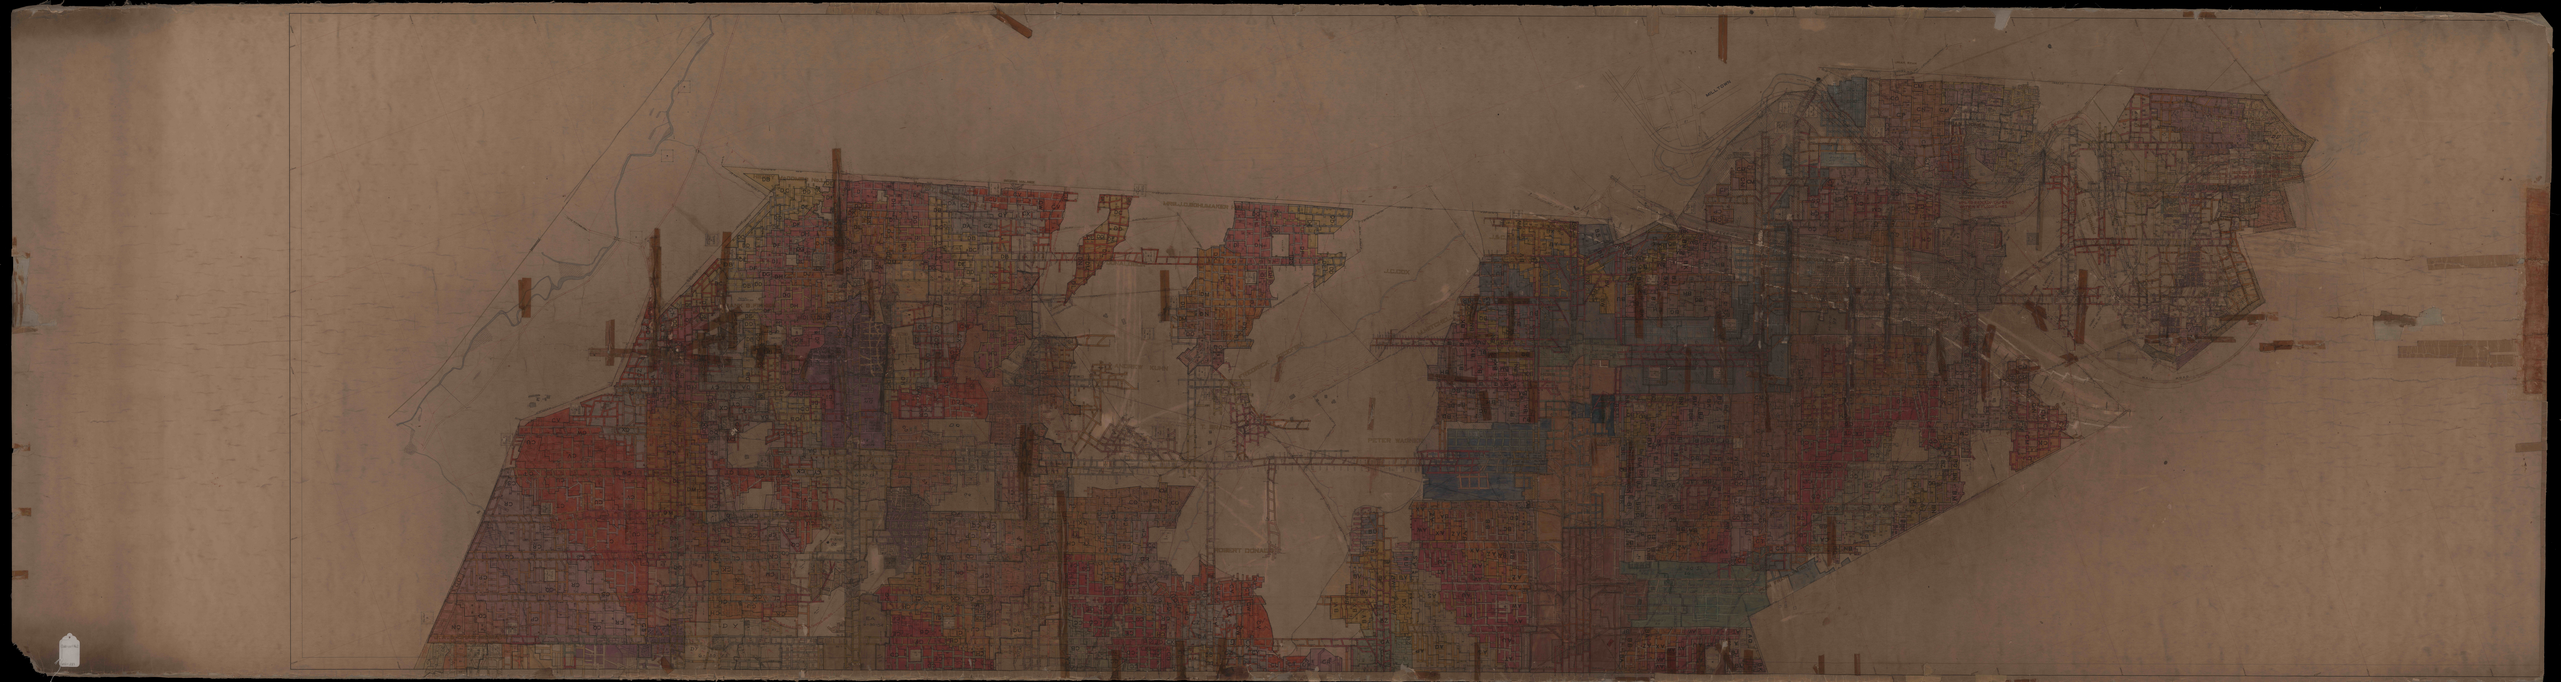

PETER MAIN
ROBERT DONALD
MILTON