


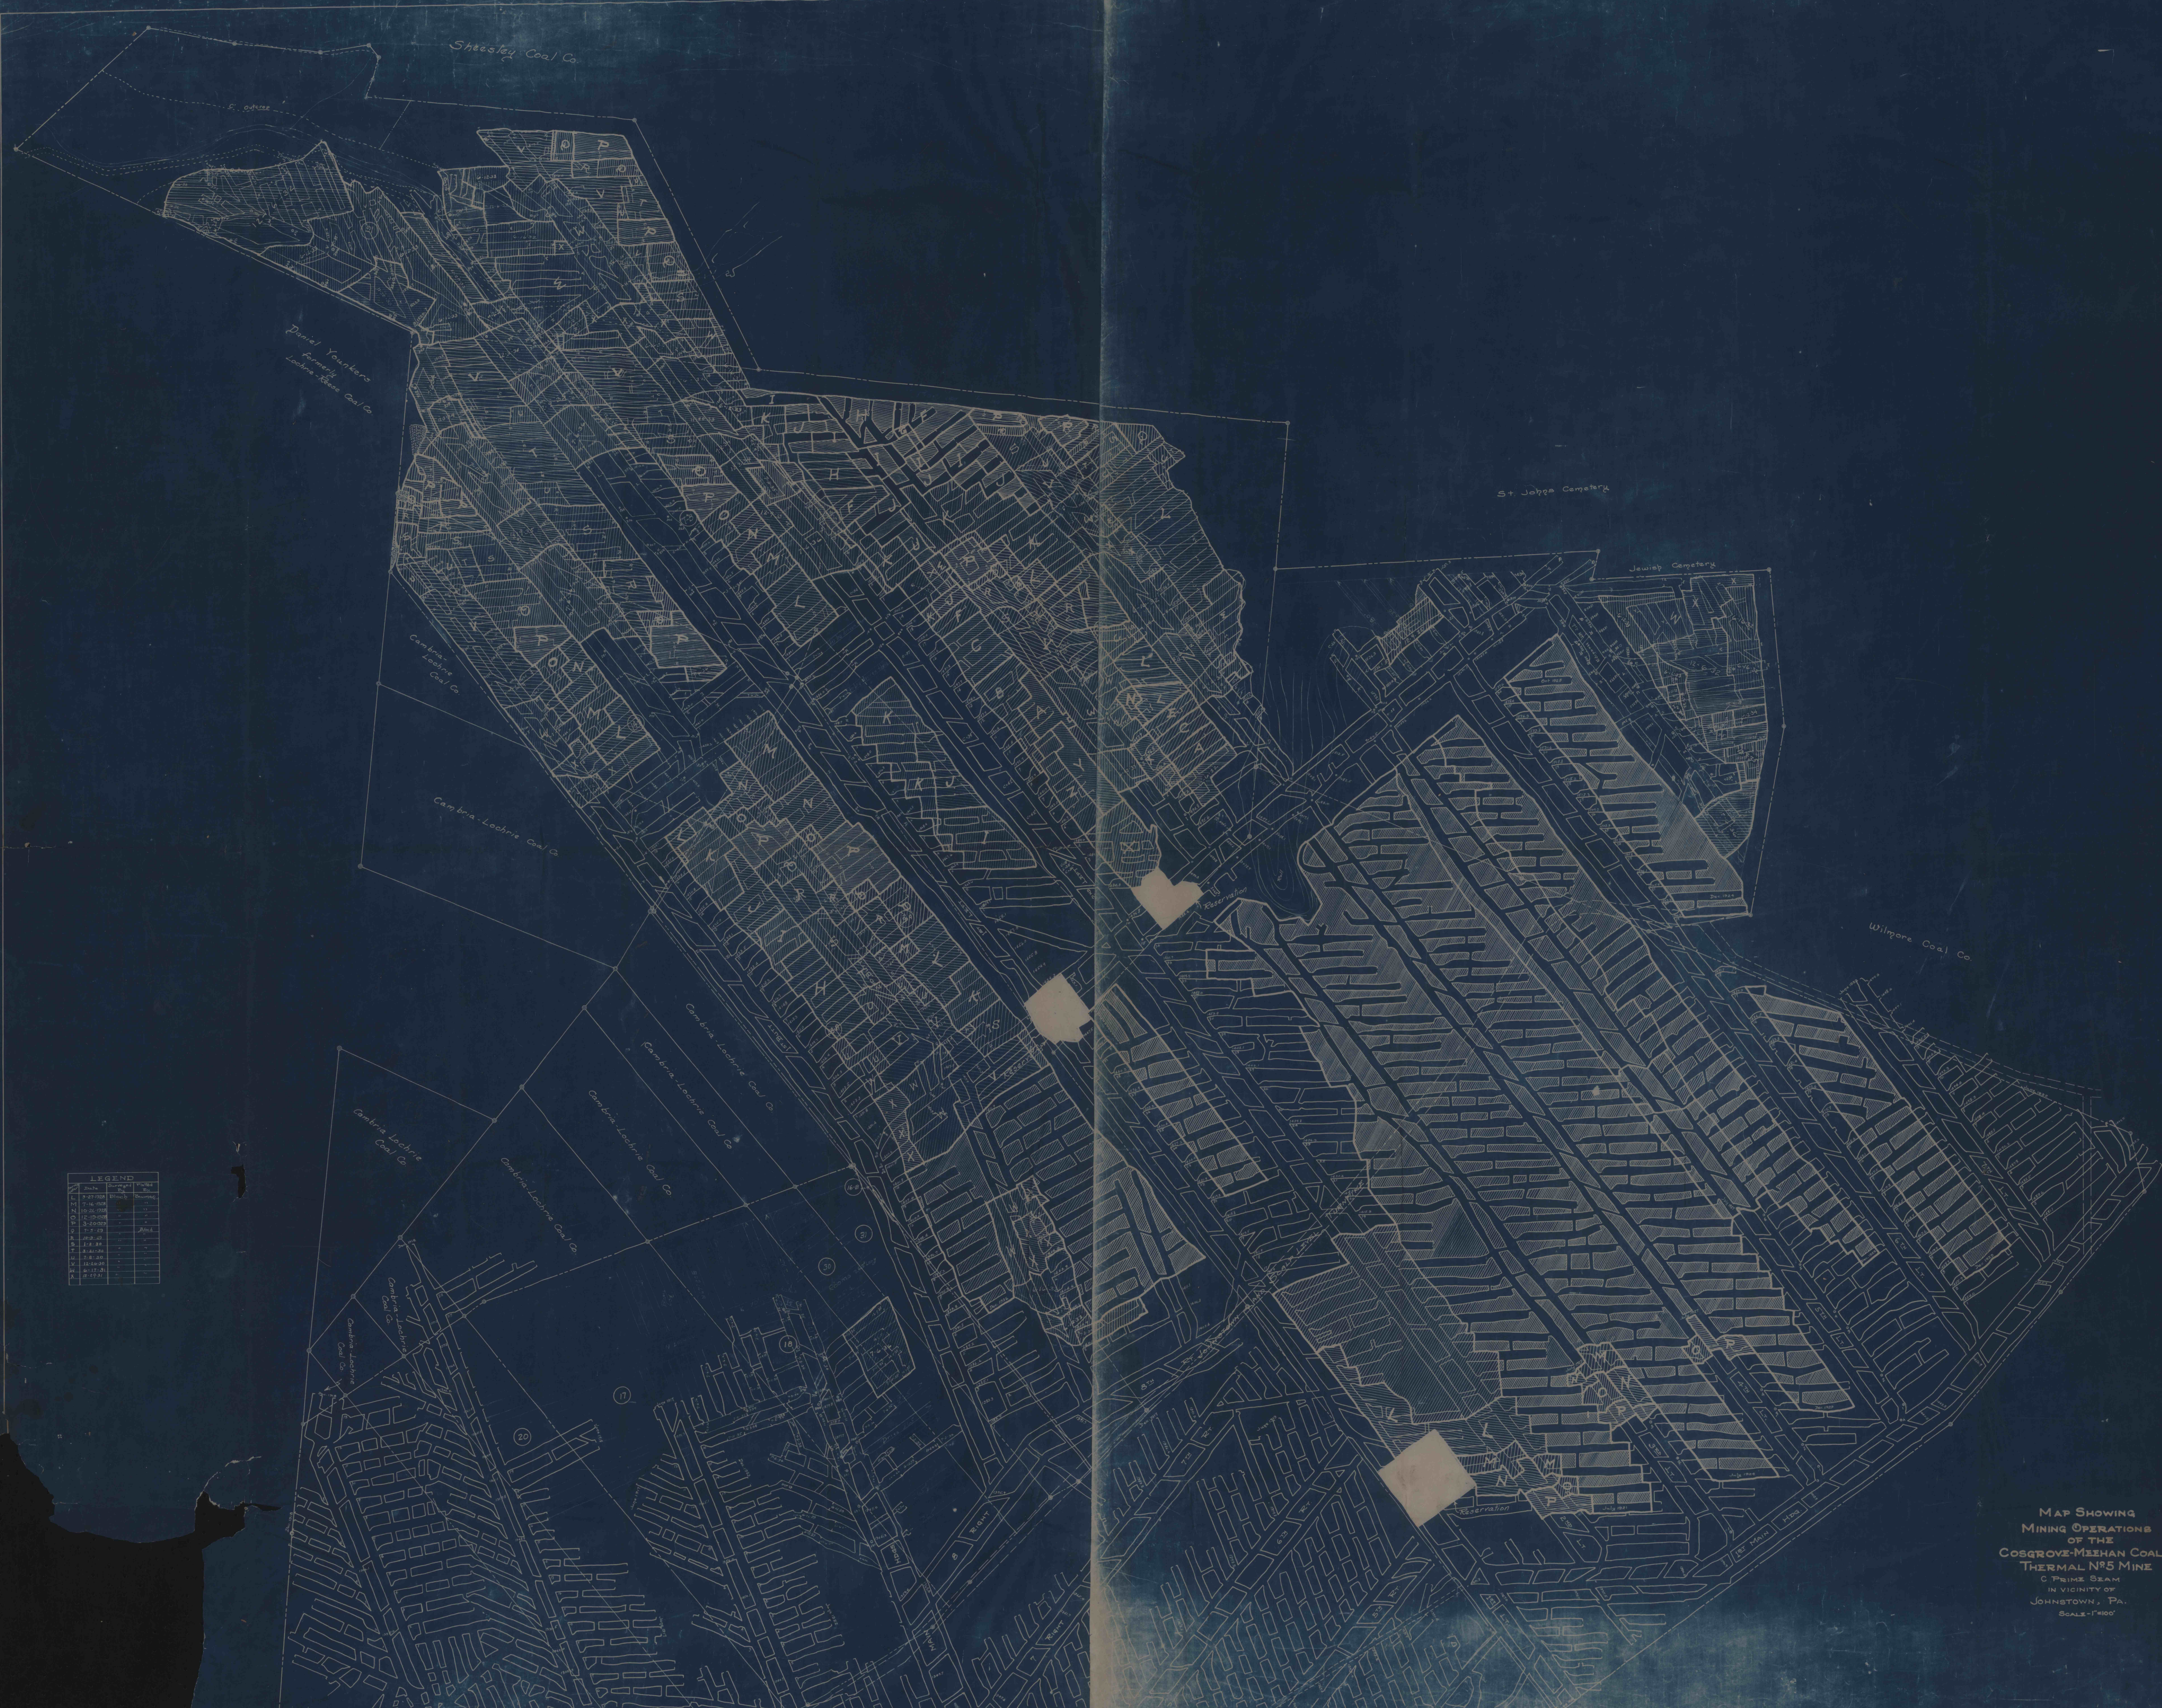

LEGEND			

MAP SHOWING
MINING OPERATIONS
OF THE
COSGROVE-MEEHAN COAL CO.
THERMAL No. 5 MINE
C PRIME SEAM
IN VICINITY OF
JOHNSTOWN, PA.
SCALE - 1" = 100'