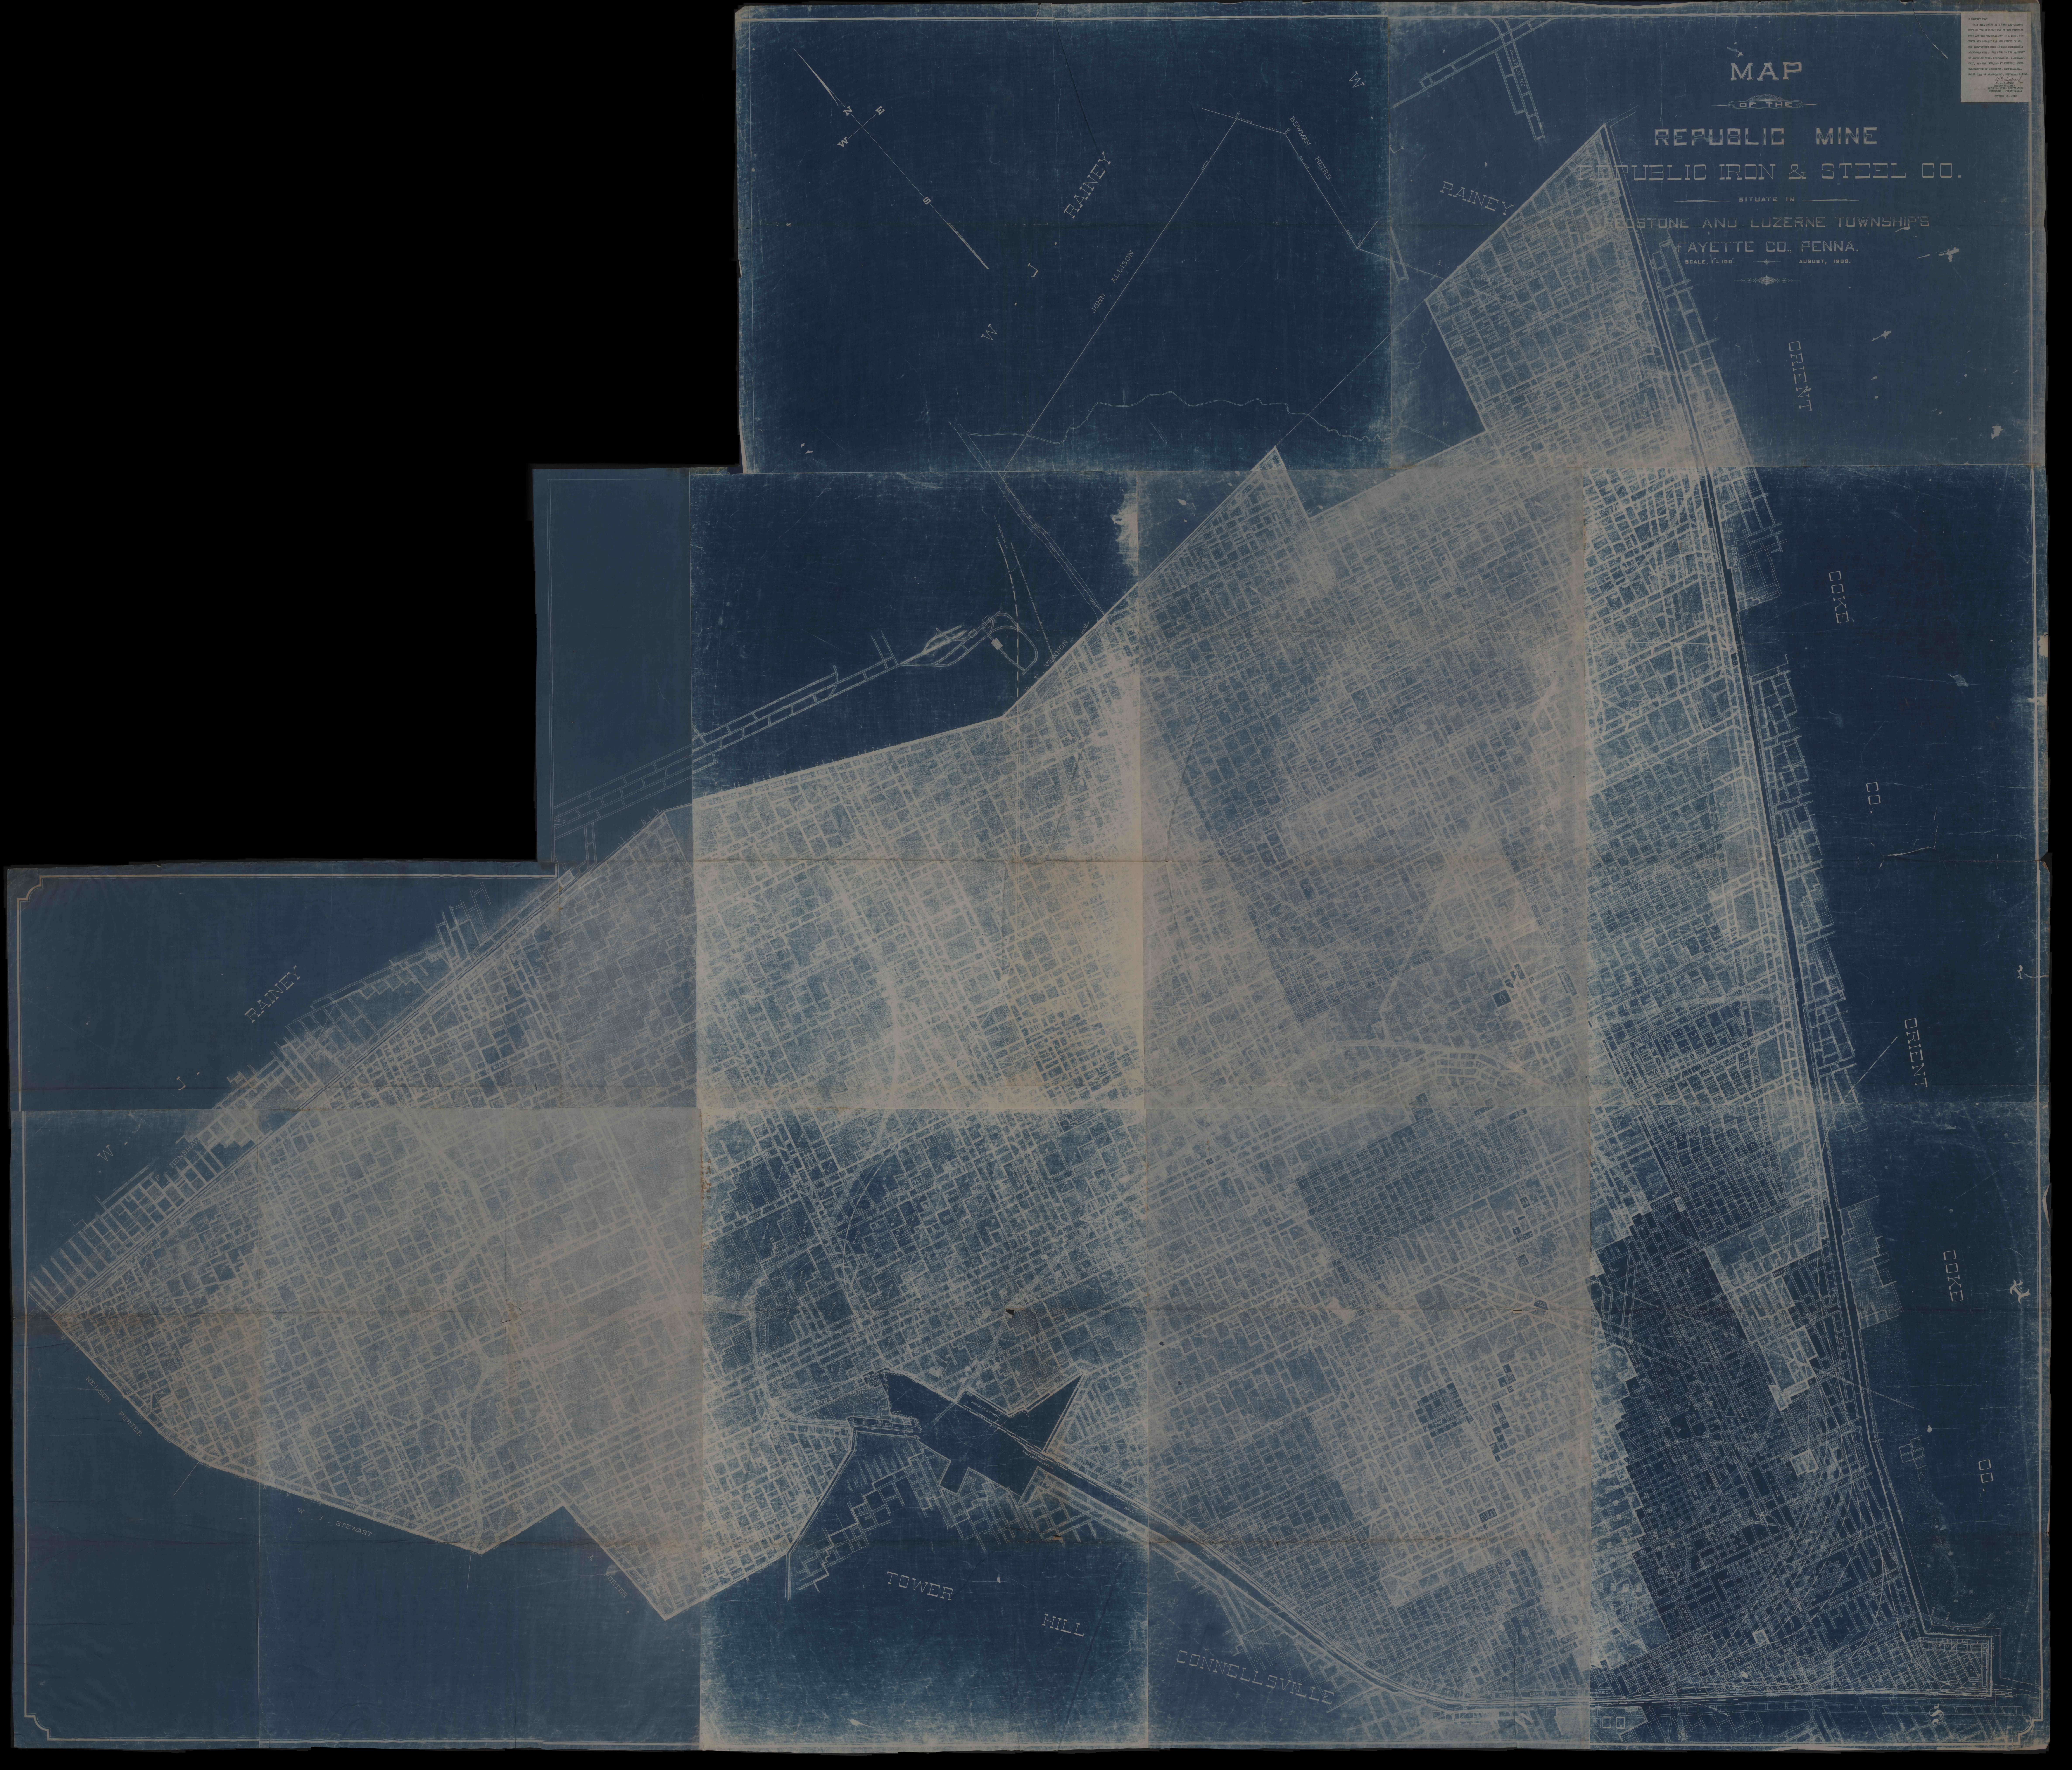
N
E
W
S
W. J. RAINEY
JOHN ALLISON
BOWMAN HEIRS
W. J. RAINEY
N. 4 FLAT RT.
RAINEY
P. F. VERNON
ORIENT COKE CO.
ORIENT COKE CO.
W. J. RAINEY
P. HENSHAW
NELSON PORTER
W. J. STEWART
A. PORTER
MOORE HEIRS
MERRITTSTOWN
MONONGAHELA RAIL ROAD
TOWER HILL
CONNELLSVILLE CO.
BUTT
NO. 2 BUTT

MAP

OF THE

REPUBLIC MINE

REPUBLIC IRON & STEEL CO.

SITUATE IN

REDSTONE AND LUZERNE TOWNSHIP'S

FAYETTE CO., PENNA.

SCALE, 1" = 100'. AUGUST, 1908.

I CERTIFY THAT

THIS BLUE PRINT IS A TRUE AND CORRECT COPY OF THE ORIGINAL MAP OF THE REPUBLIC MINE AND THE ORIGINAL MAP IS A TRUE, COMPLETE AND CORRECT MAP AND SURVEY OF ALL THE EXCAVATIONS MADE IN SAID PERMANENTLY ABANDONED MINE. THE MINE IS THE PROPERTY OF REPUBLIC STEEL CORPORATION, CLEVELAND, OHIO, AND WAS OPERATED BY REPUBLIC STEEL CORPORATION OF UNIONTOWN, PENNSYLVANIA, UNTIL TIME OF ABANDONMENT, SEPTEMBER 9, 1940.

W G Hippard
W. G. HIPPARD
MINING ENGINEER
REPUBLIC STEEL CORPORATION
UNIONTOWN, PENNSYLVANIA

OCTOBER 16, 1940

#2290
1-11-2000
CO