


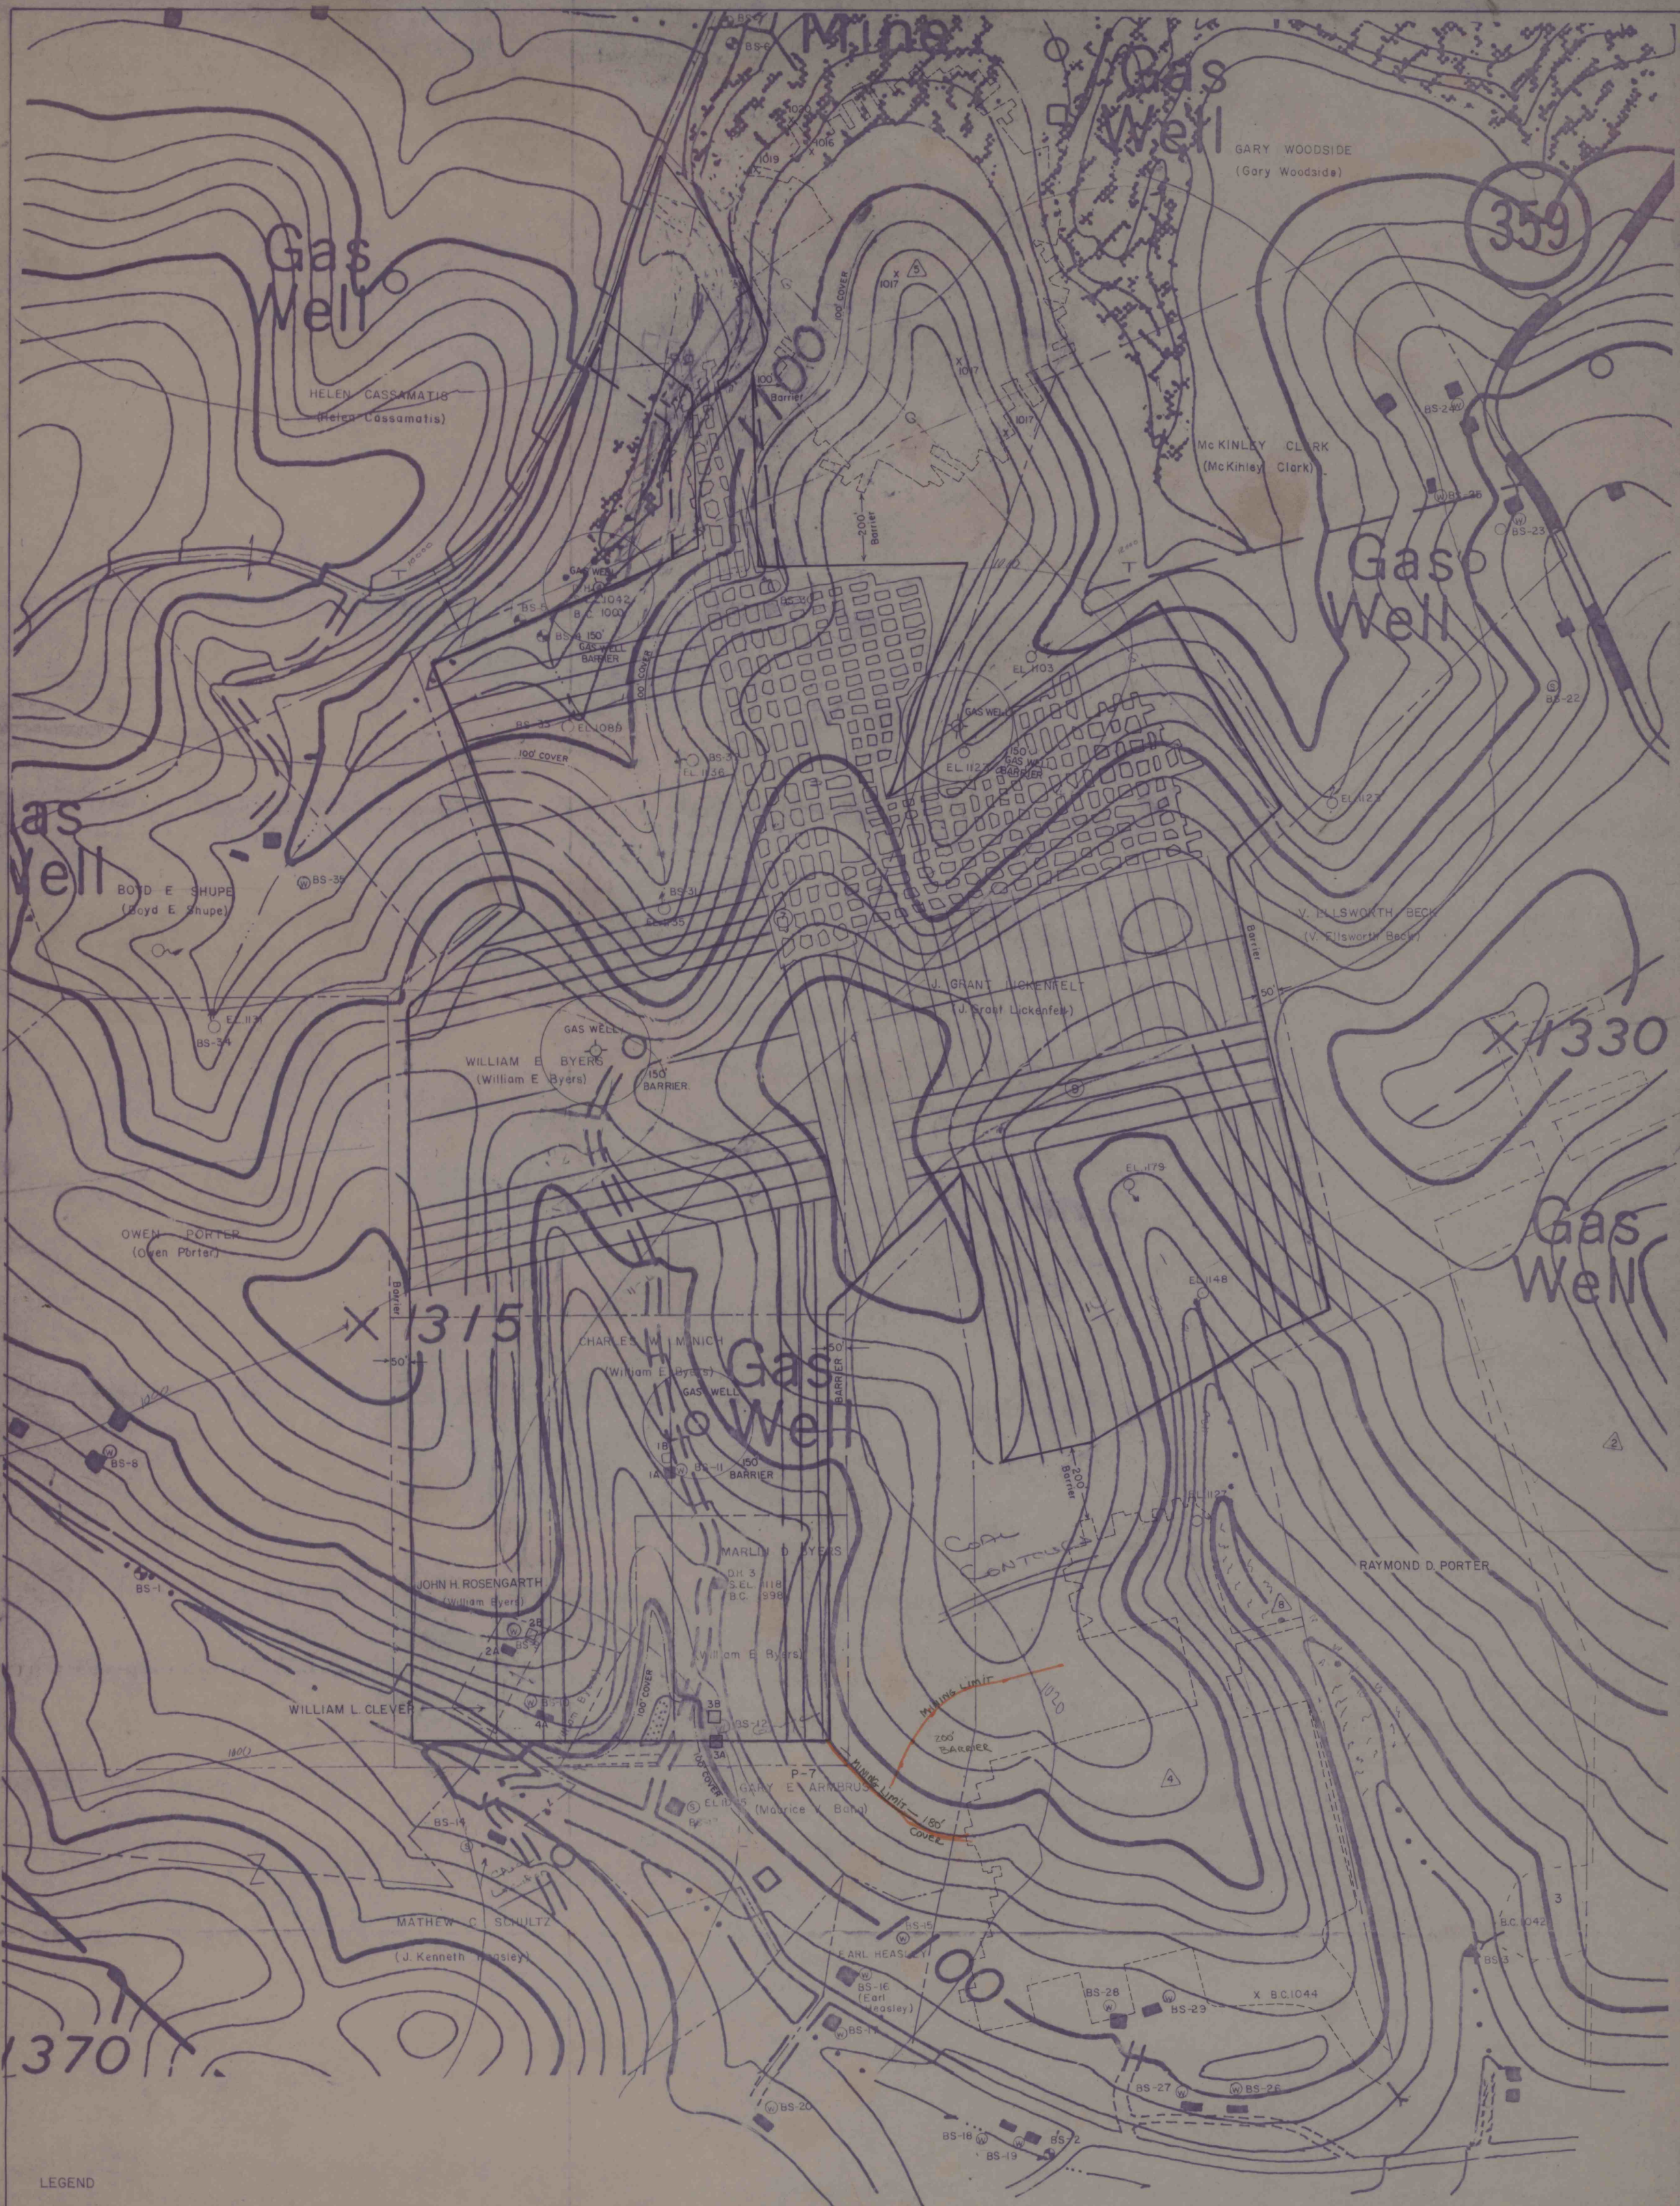

LEGEND

- | | | | |
|---------|--|-----|-------------------------------|
| --- | Property Line | ■ | Occupied Dwelling |
| --- | Permit Area & Subsidence Control Plan Boundary | □ | Other Buildings |
| --- | CORRECTED PERMIT AREA | ● | Drill Hole and Log Number |
| ○ | Spring | ● | Background Sample |
| | Coal Outcrop | ▲ | Proposed Monitoring Point |
| --- | Underground Mine | → | Direction of Groundwater Flow |
| --- | Surface Mine | ↑ | Strike and Dip |
| ○ | Water Well Private | --- | Existing Highwall |
| ○ | Spring Private Supply | △ | Adjacent Mine |
| ▲ | Mine Discharge | --- | AREA FOR SECONDARY MINING |
| OWNER | Surface Owner | | |
| (Owner) | Coal Owner | | |
| 01234 | Legislative Route | | |
| T123 | Township Road | | |

PROPOSED MINING PLAN

YEAR	1	2	3	4	5	6-10	11-15	16-20

6 MONTH PROJECTION

SCALE 1" = 200'

EXHIBIT 19.3

REVISED DATE
11/13/93

MINE DEVELOPMENT/SUBSIDENCE MAP	
PROJECT	TRIPLE K COAL COMPANY
FOR	TRIPLE K #1 MINE
LOCATION	BURRELL TOWNSHIP, ARMSTRONG CO.
	W.D. MOHNEY R.S. KITTANNING, PA.
DRAWN BY	JTS
DATE	2-24-93
SCALE	1" = 200'
DRAWING NO.	

IMAPS# 2110