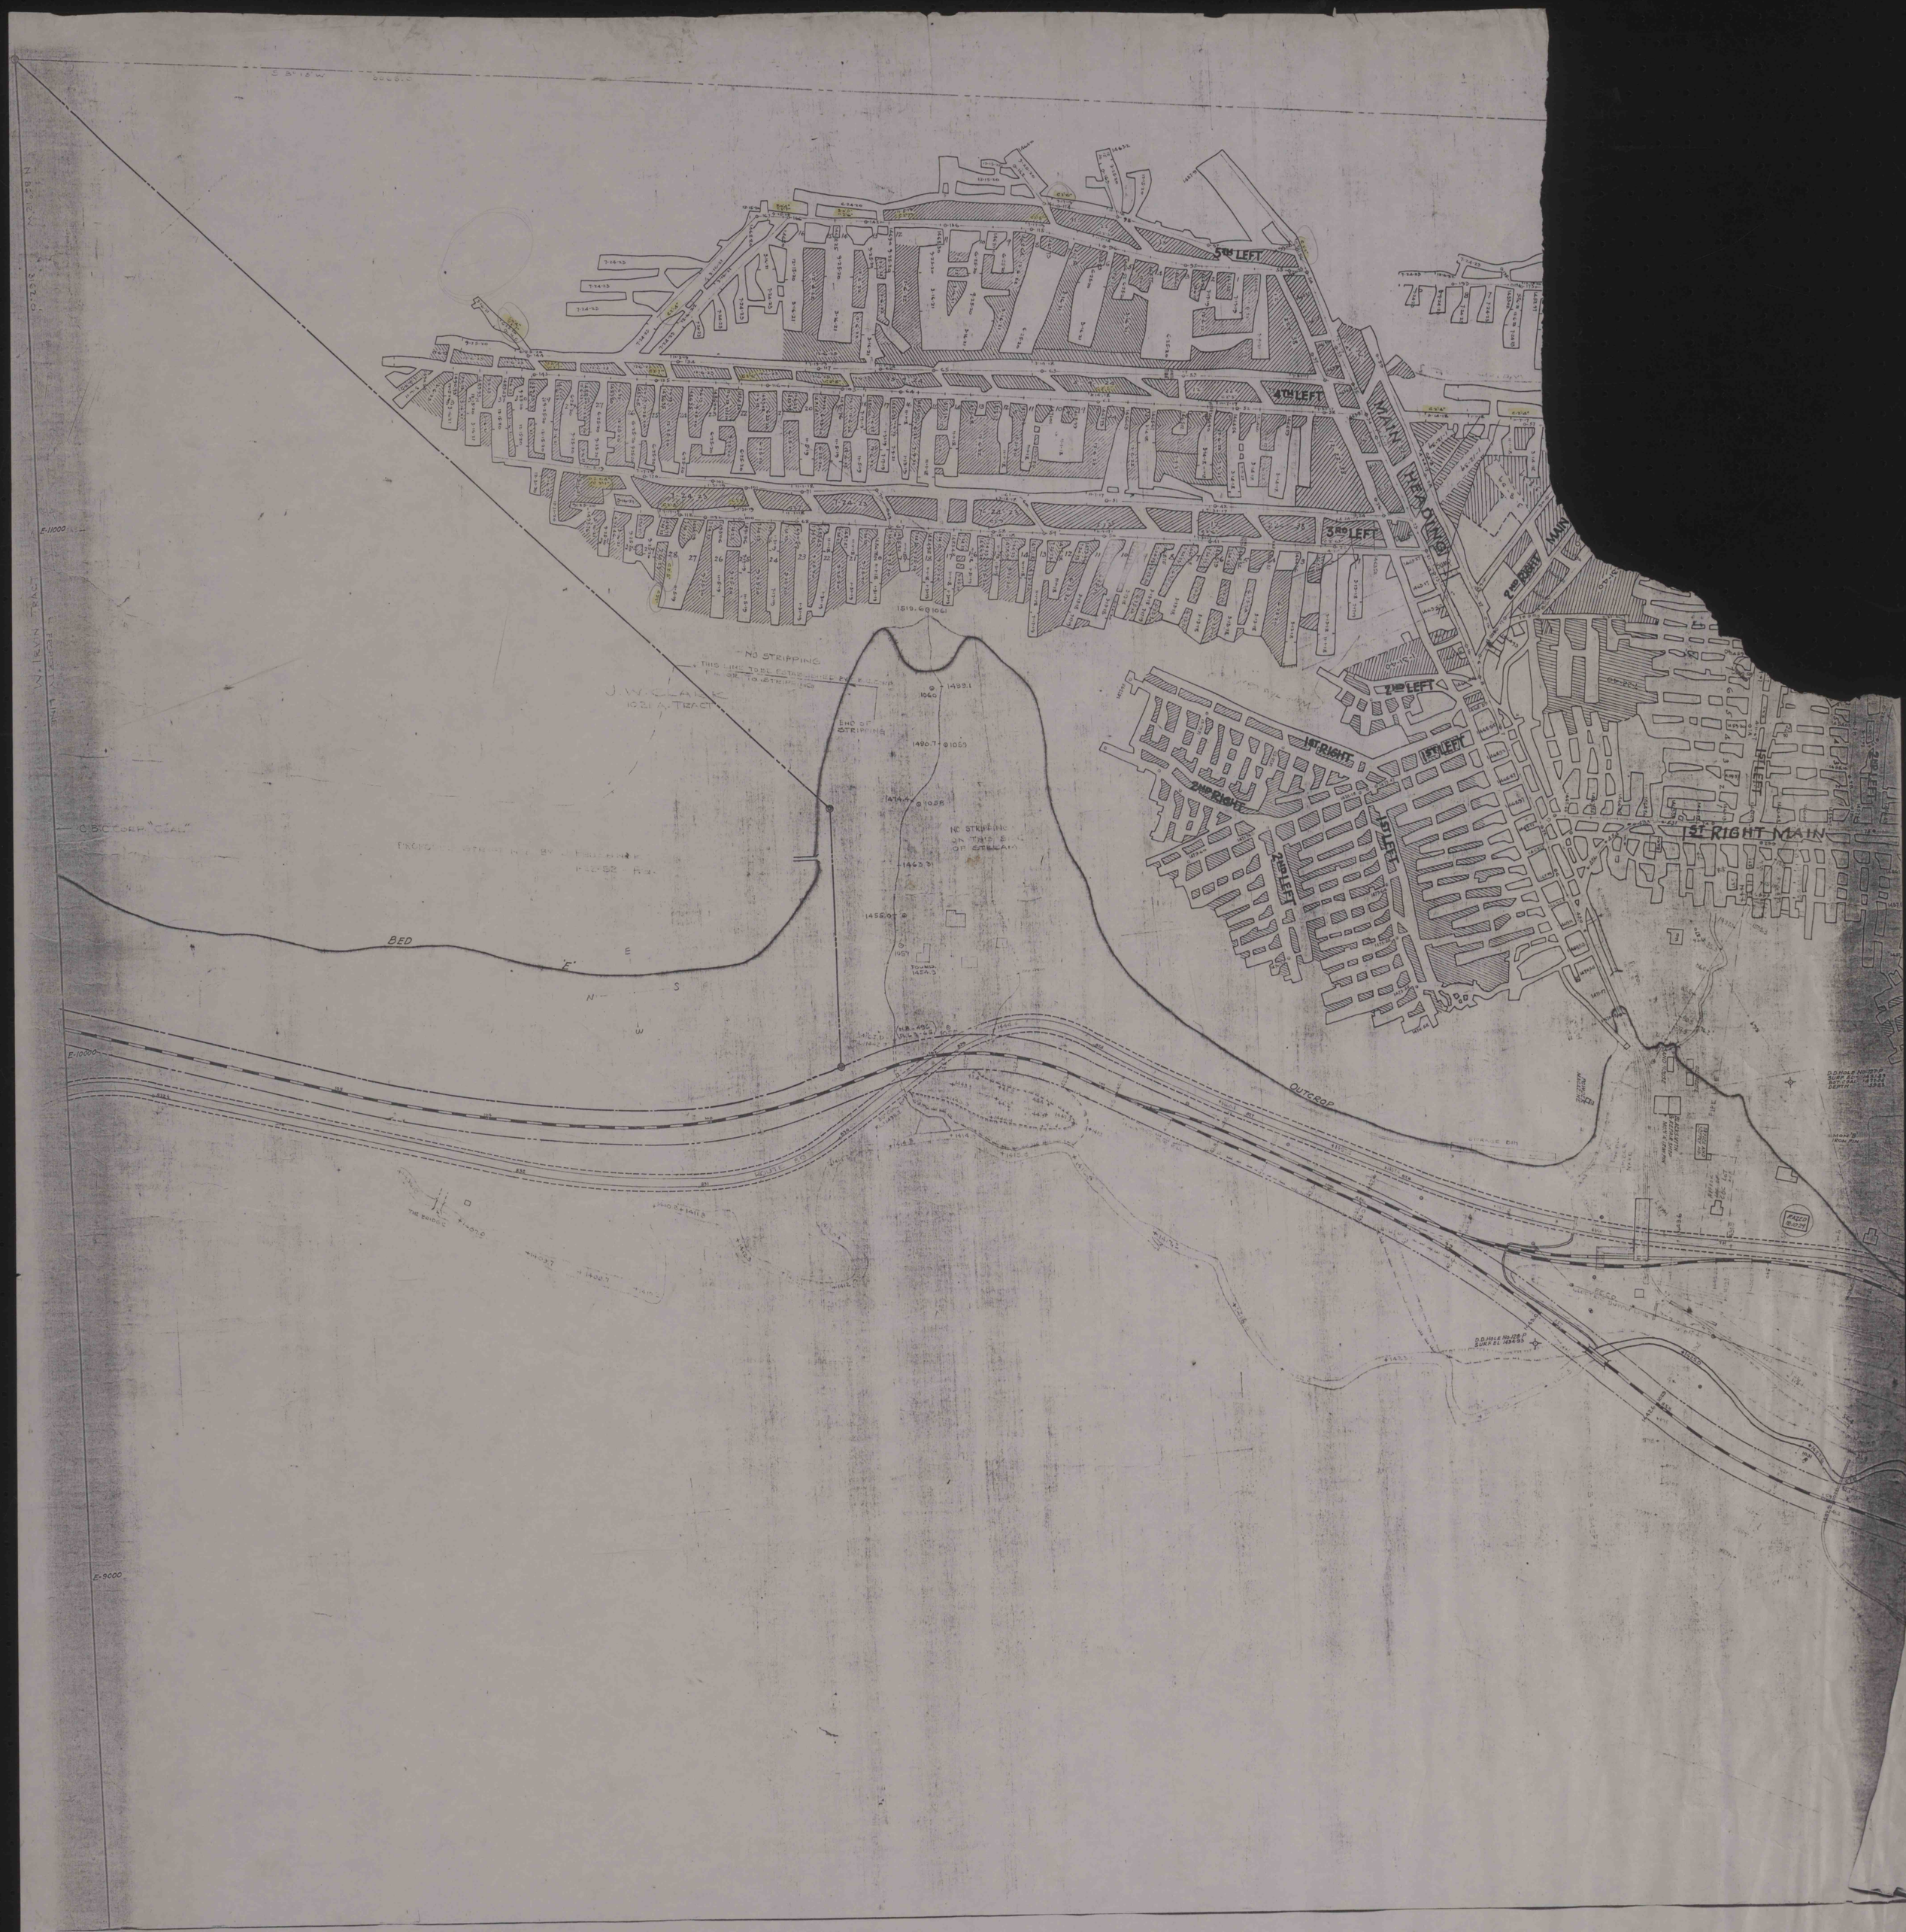
5TH LEFT
4TH LEFT
3RD LEFT
2ND LEFT
1ST LEFT
1ST RIGHT
2ND RIGHT
MAIN HEAD DRIFT
2ND RIGHT
1ST RIGHT MAIN
NO STRIPPING
END OF STRIPPING
J.W. CLARK
10.21 A. TRACT
C.B.C. CORP. "COAL"
BED
OUTCROP
E-11000
E-10000
E-9000

IMAPS # 21130