


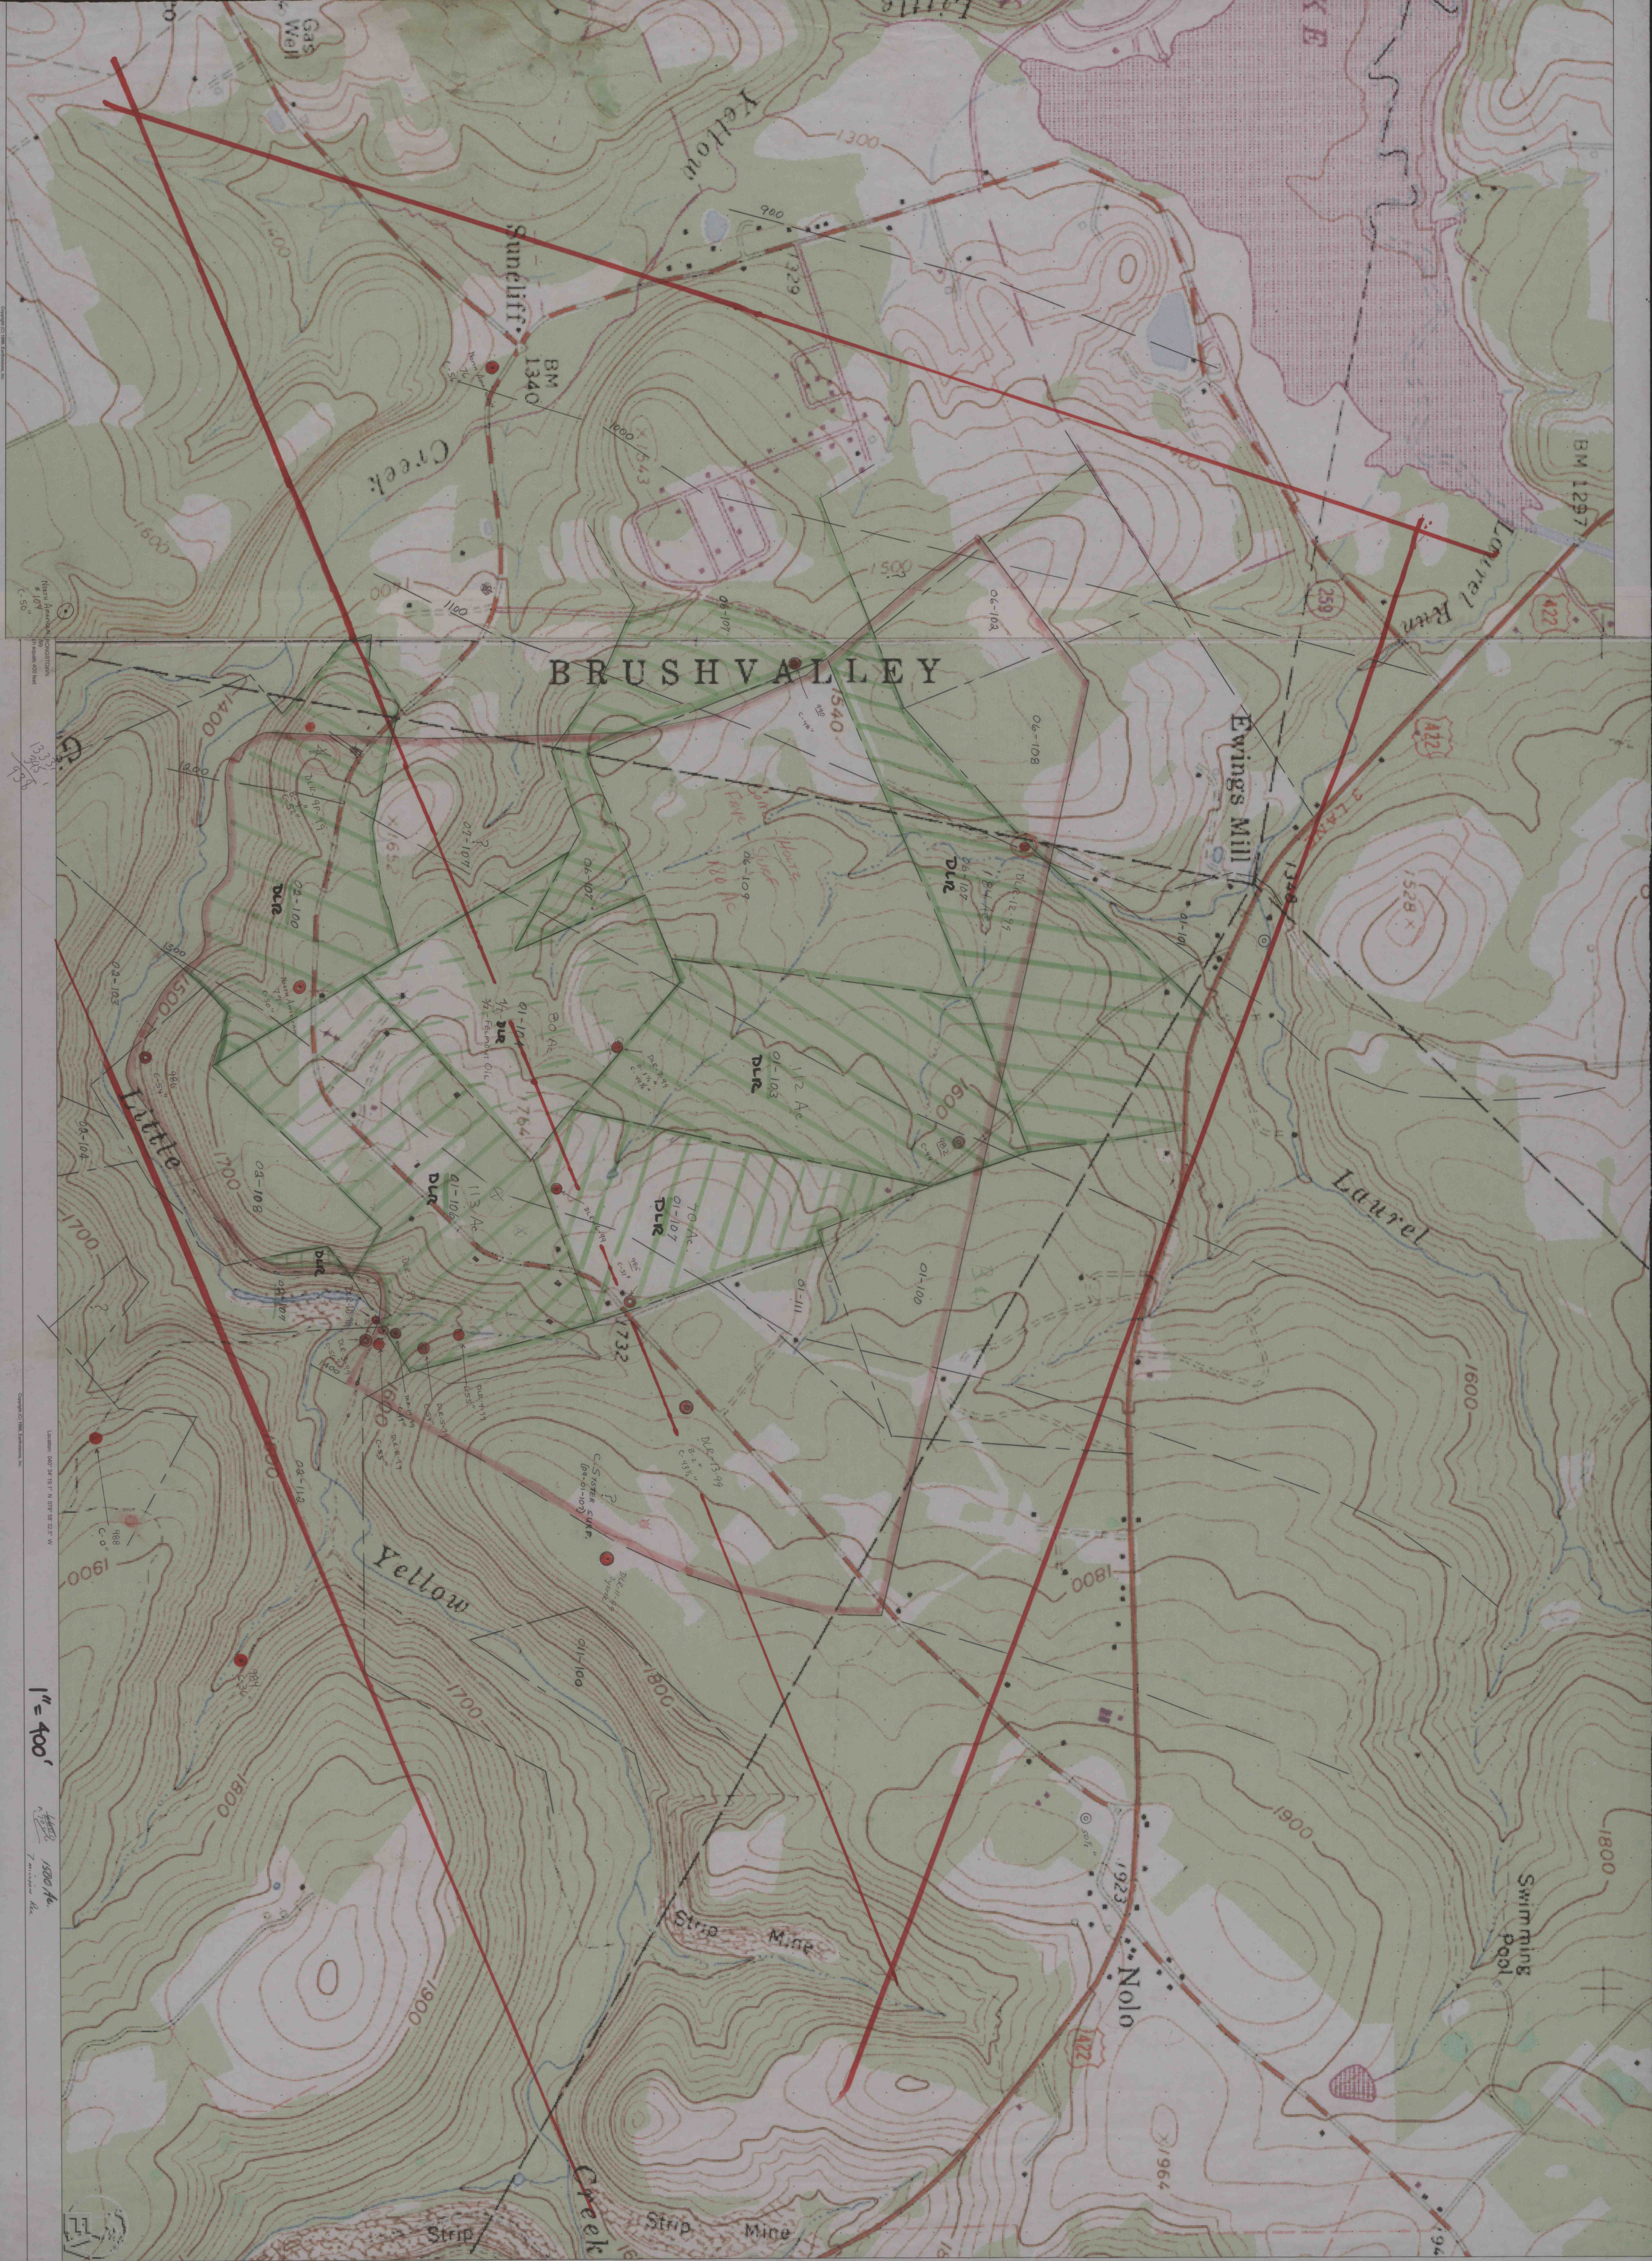

BRUSH VALLEY

Ewings Mill

Laurel

Nolo

Yellow

Strip Mine

Strip Mine

Creek

Suncliff

BM 1340

Creek

1" = 400'

1900 ft