


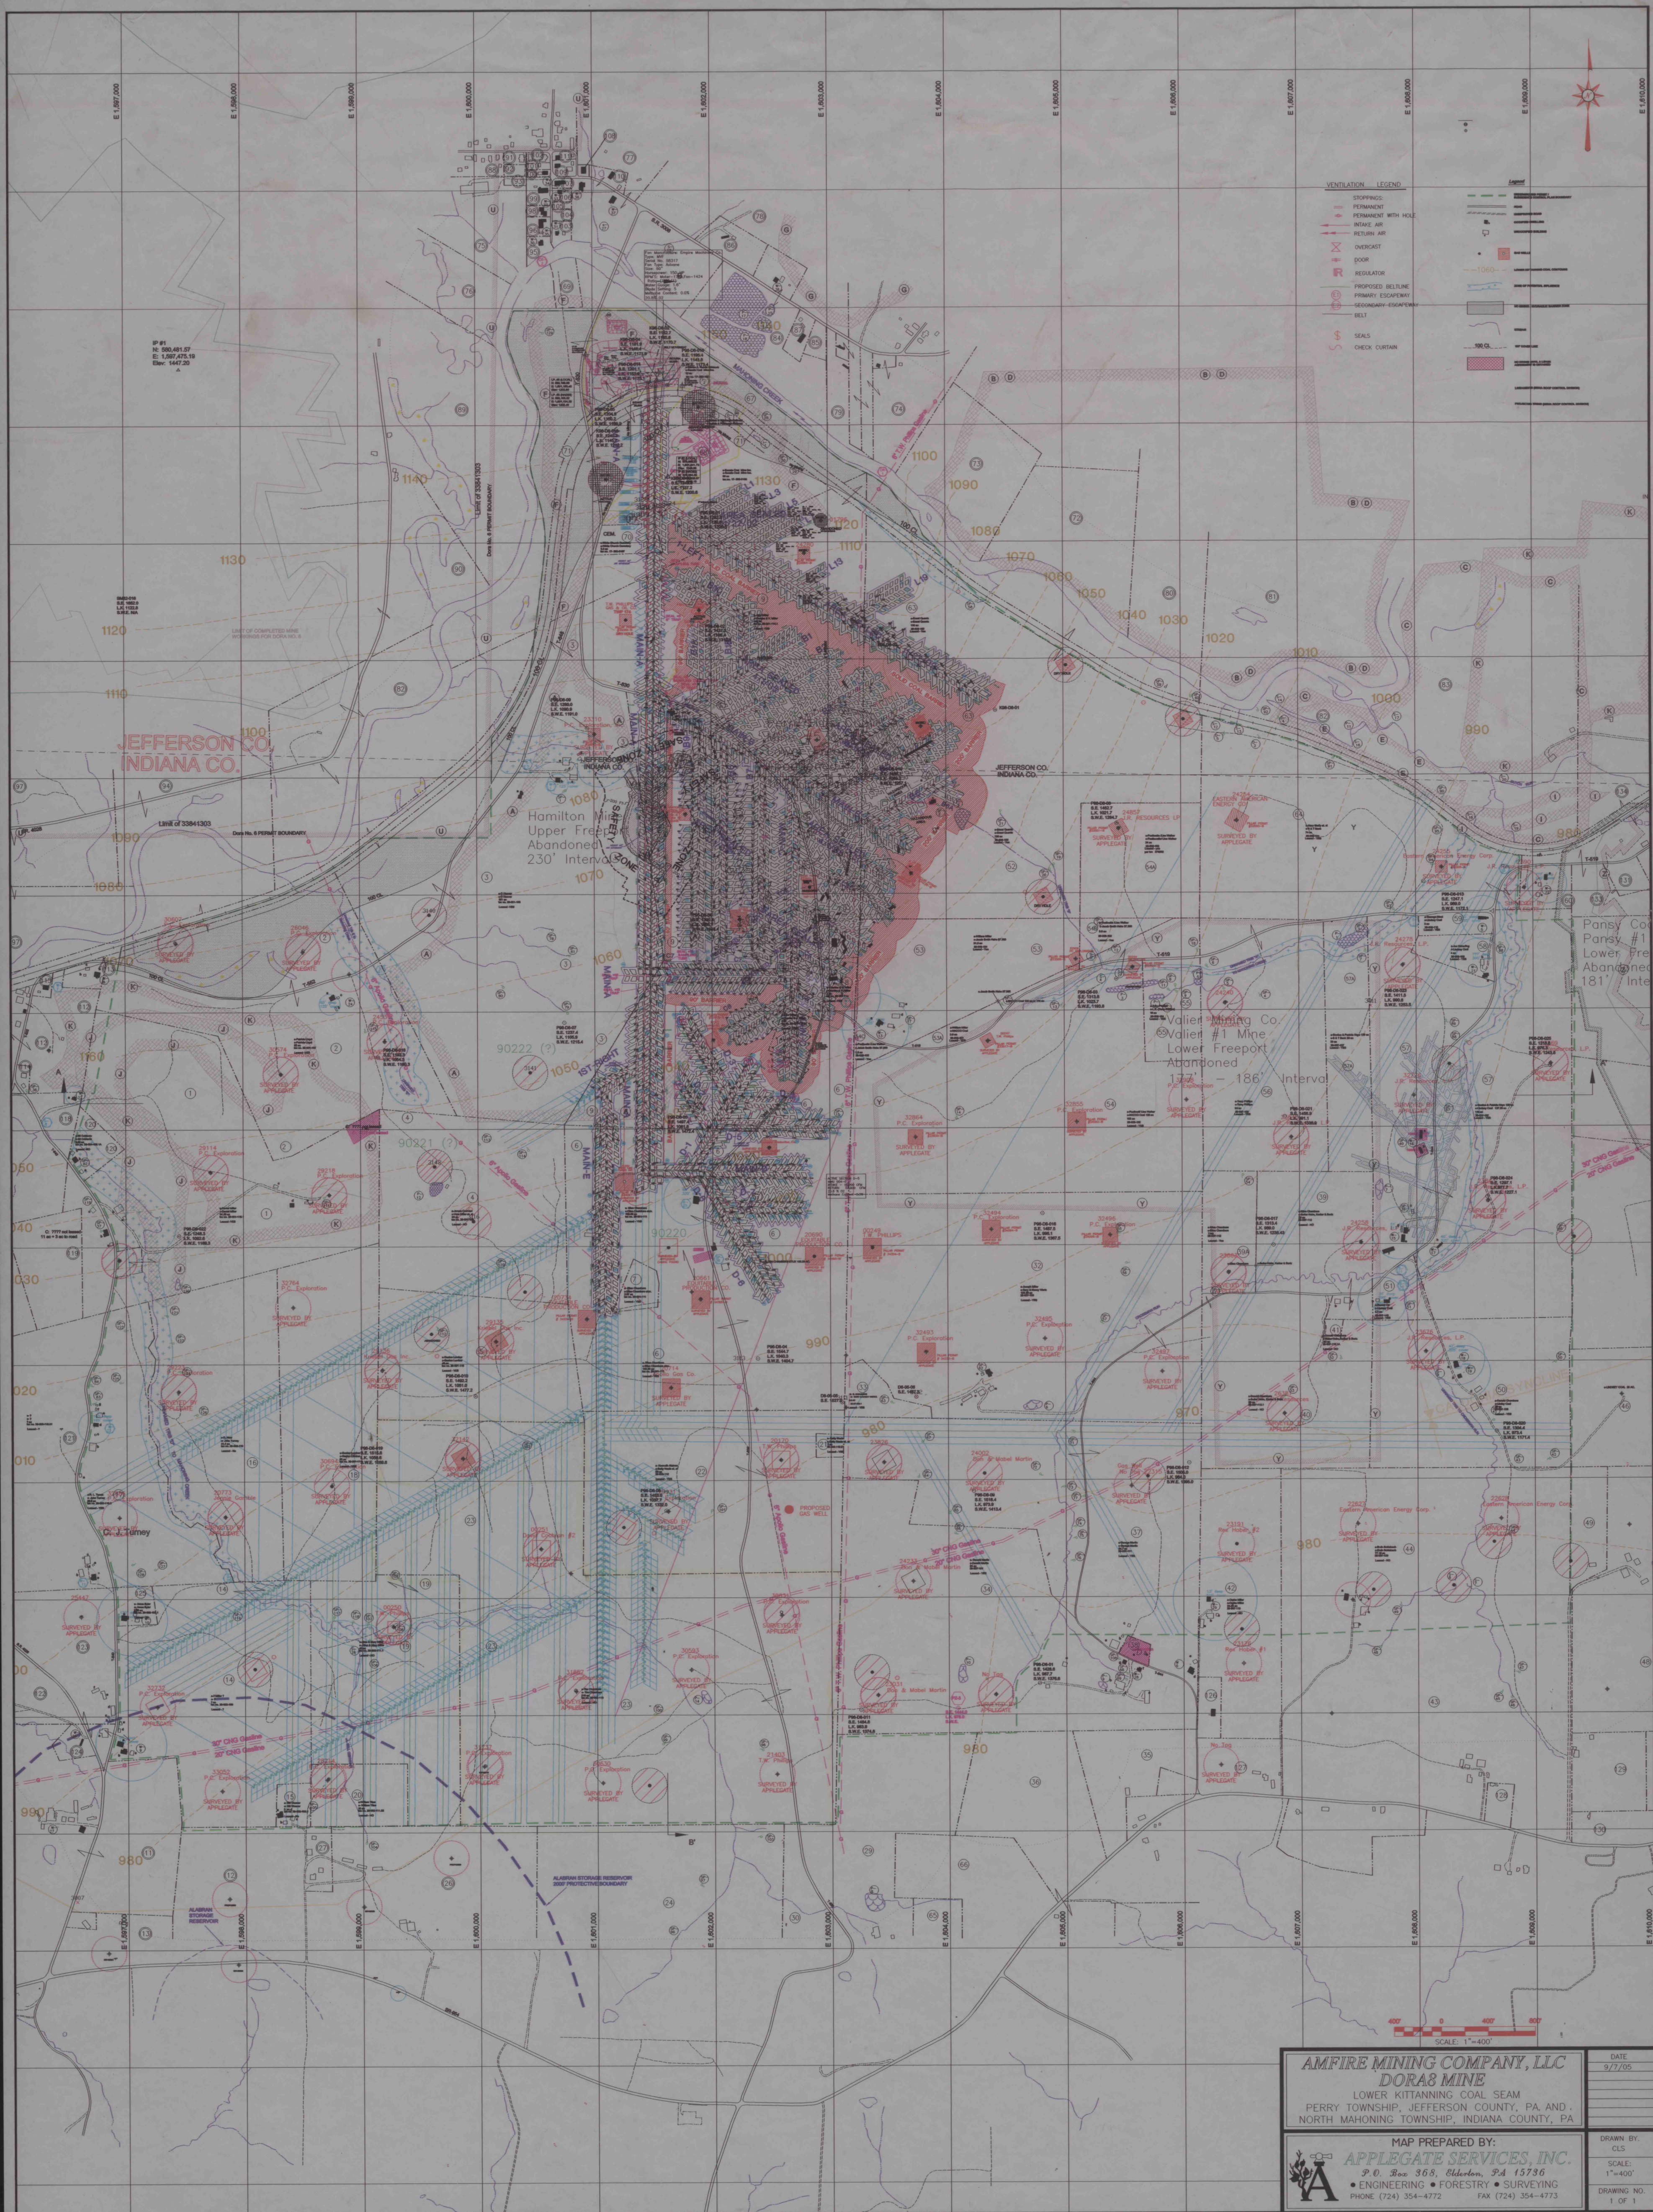

AMFIRE MINING COMPANY, LLC DORAS MINE LOWER KITANNING COAL SEAM PERRY TOWNSHIP, JEFFERSON COUNTY, PA AND NORTH MAHONING TOWNSHIP, INDIANA COUNTY, PA		DATE 9/7/05
MAP PREPARED BY: APPLAGATE SERVICES, INC. P.O. Box 368, Elderton, PA 15736 ENGINEERING • FORESTRY • SURVEYING PHONE (724) 354-4772 FAX (724) 354-4773		DRAWN BY: CLS SCALE: 1"=400' DRAWING NO. 1 OF 1

IMPS # 21146