


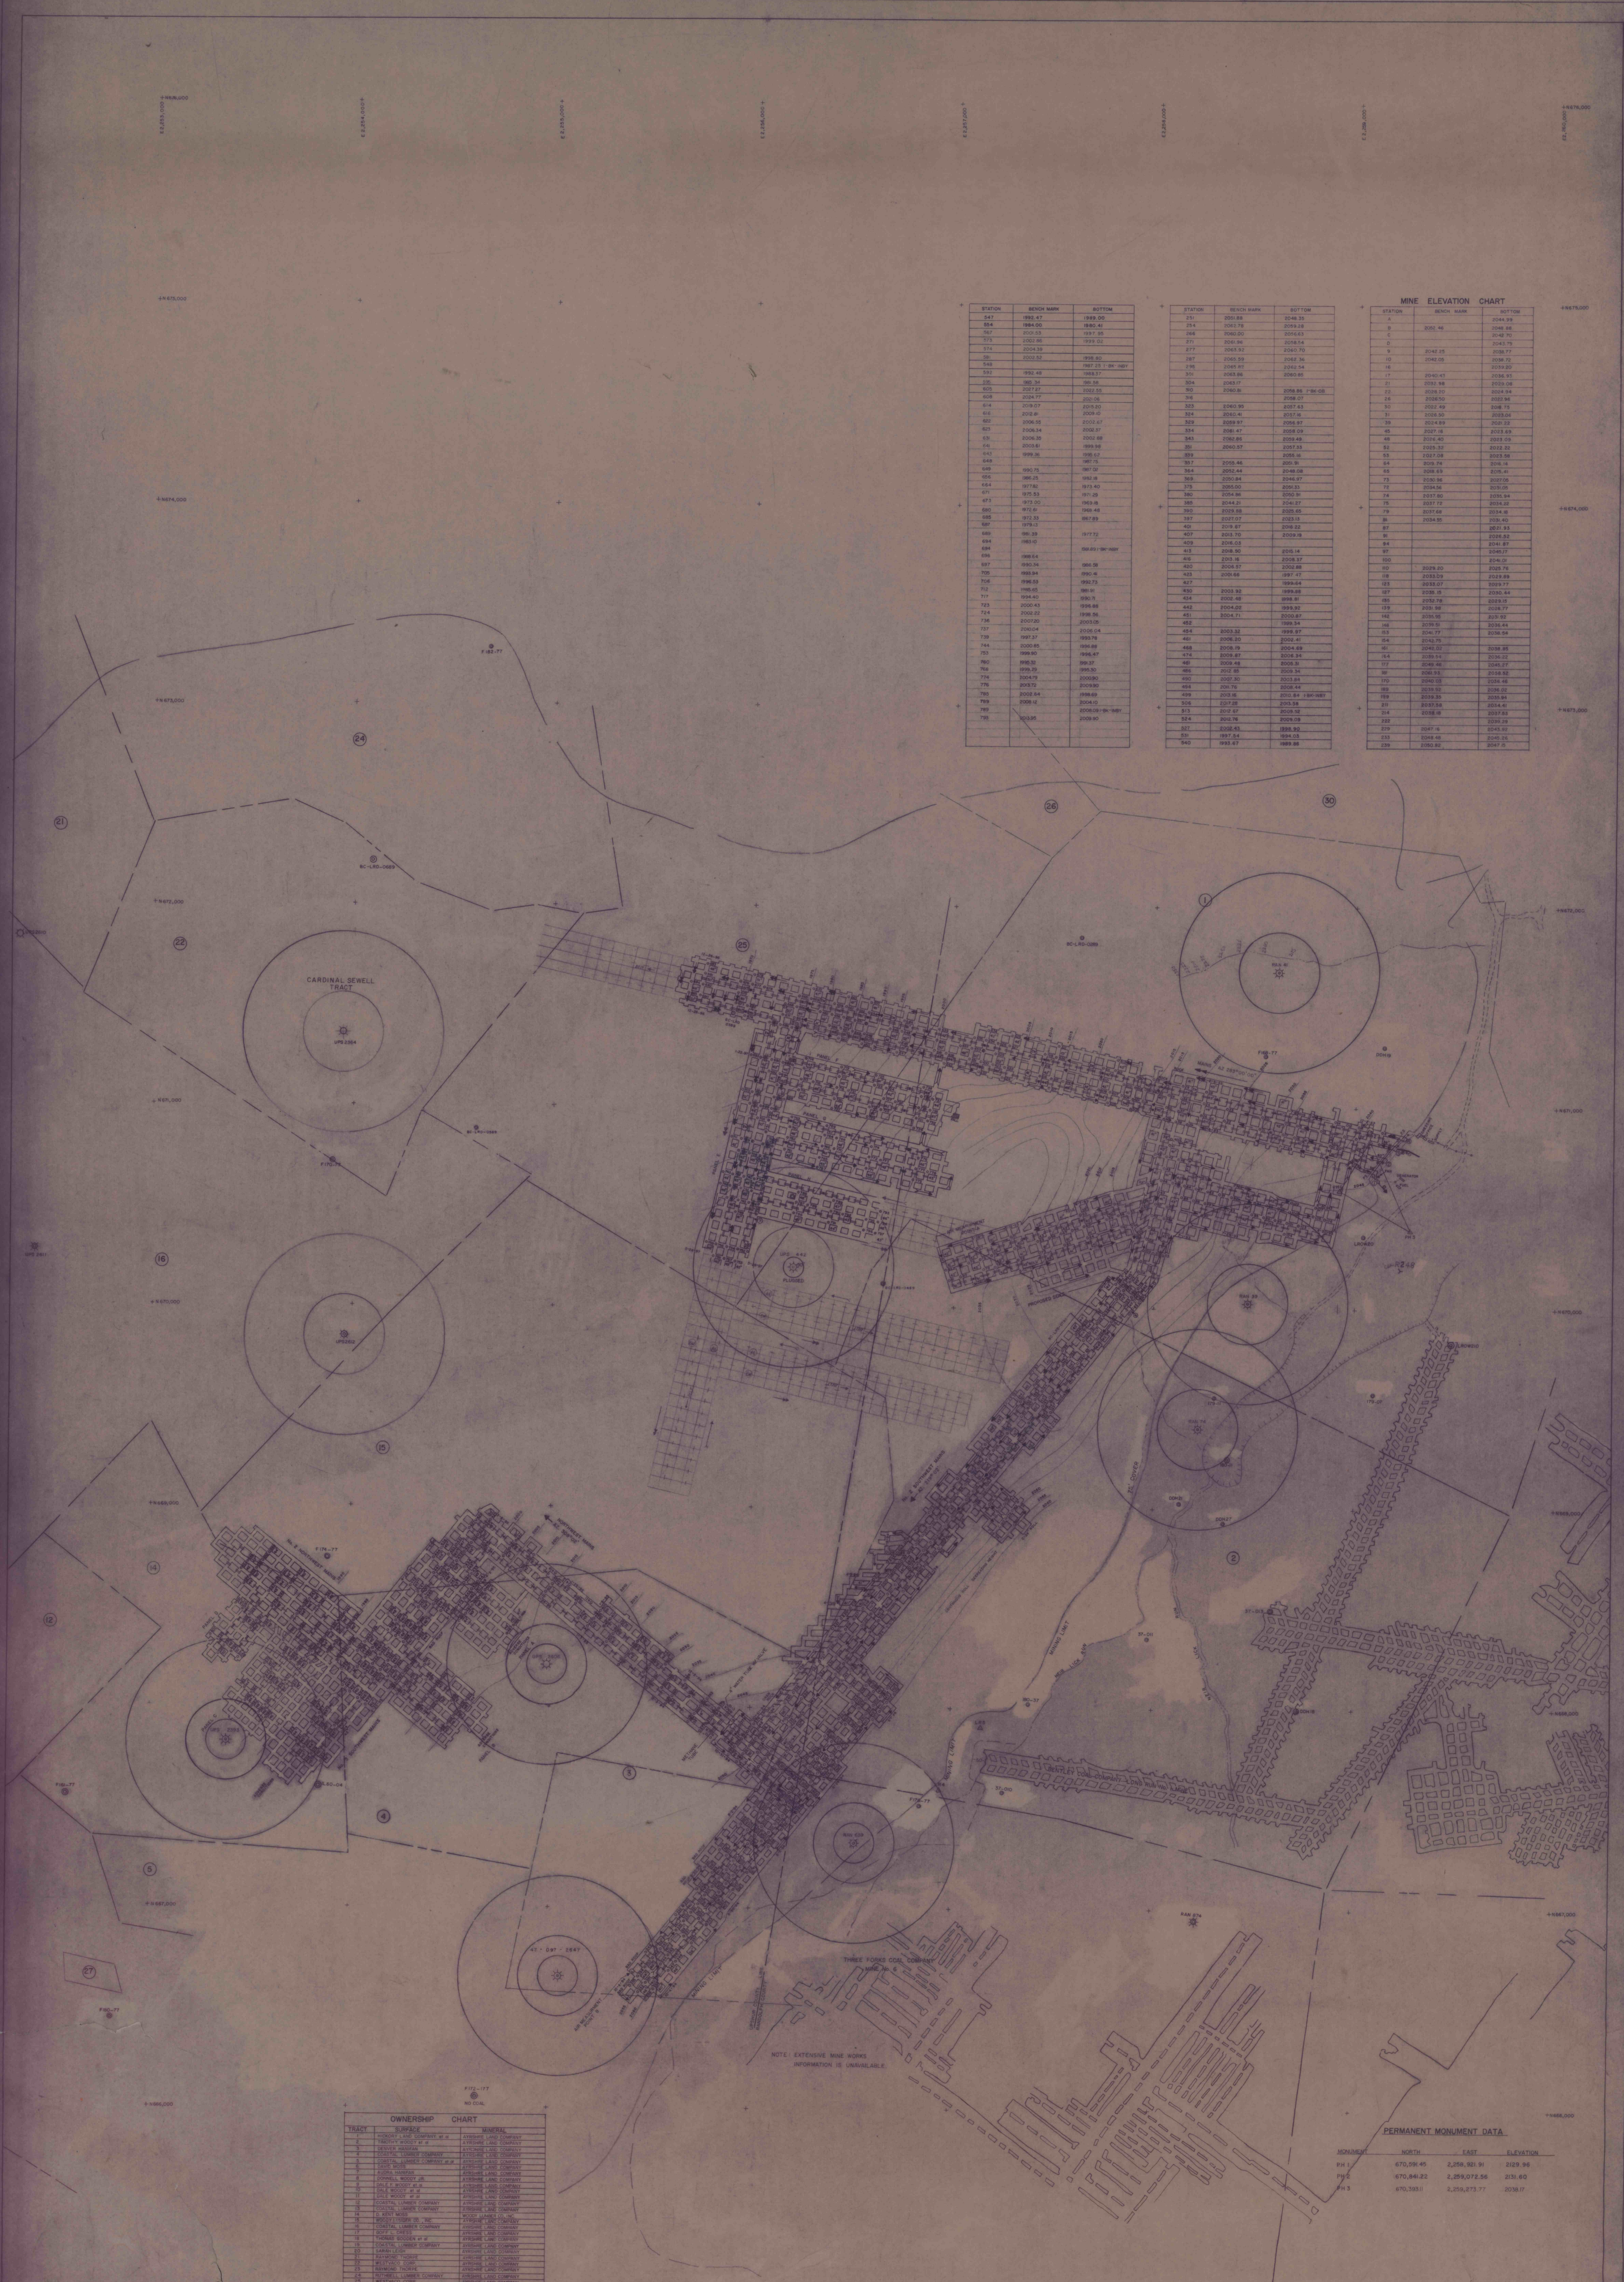

STATION	BENCH MARK	BOTTOM
247	1992.47	1992.50
