

75,372-6 FAN DATA
 LOCATION: DRIFT OPENING RPM 1000
 MFR: JEFFERY AIR QUANTITY 36,000
 TYPE: AXIAL BLADE SETTING 15°
 SIZE: 60" HP 46
 OPERATING PRESSURE
 MODEL: UNKNOWN

NOTE:
 RED DESIGNATES VENTILATION
 AT PROPOSED TOE OF WATER
 STOPPINGS CIRCLED TO BE
 REMOVED.

NOTE: All minerals owned by Barnes & Tucker unless
 otherwise noted.
 NO OTHER MINE WORKING ON MINE PROPERTY
 NO MINE WORKING ABOVE OR BELOW

THIS MAP MEETS REQUIREMENTS FOR
 75,1200 AND 75,372
 SURVEYED BY CLOSED LOOP METHOD
 ACC: 1-15000

RESPONSIBLE PERSON FOR MAP INFO:
 CLAIR RUFFNER
 (GENERAL SUPERINTENDENT)


- LEGEND
- PERMIT BOUNDARY
 - PROPERTY LINE
 - PUBLIC ROAD
 - STREAM
 - PROTECTED STRUCTURE
 - SURVEY CONTROL POINT
 - GAS WELL
 - CONTEMPLATED MINING AREA
 - PROJECTED MINING 9/10/94 TO 3/10/95
 - MINERAL OWNERSHIP LINE

REVISED 10/5/92
 8/4/93
 9/17/93
 3/5/94
 9/3/94
 9/28/94
 10/11/94

- VENTILATION LEGEND
- WORKING SECTION
 - PRIMARY ESCAPEWAY
 - ALTERNATIVE ESCAPEWAY
 - MAN DOOR
 - PERMANENT STOPPING
 - REGULATOR
 - CHECK CURTAIN
 - BELT HAULAGE
 - INTAKE AIRFLOW
 - RETURN AIR
 - REDUCED AIR
 - OVERCAST
 - PROPOSED SEAL
 - B.E. POINT
 - EQUIPMENT DOORS
 - IN-PLACE SEALS

NOTE:
 ELEVATIONS FROM STA. 312 AND ABOVE B.O.C.
 ALL OTHERS T.O.C.


NOTE:
 STOPPINGS WILL BE REMOVED AS NEEDED
 TO MAINTAIN PROPER VENTILATION.
 FIELD OFFICE WILL BE NOTIFIED AS WATERS
 EDGE INCREASES ONE CROSS CUT OR MORE
 AND/OR AS AGREED UPON BY FIELD OFFICE AND
 MINE OFFICIALS.

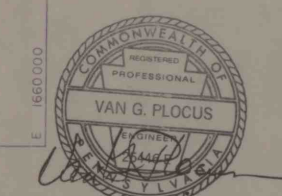

SHEET NO. 1
 MEARS ENTERPRISES INC.

PENN RUN MINE
 UPPER FREEPORT COAL SEAM
 CHERRYHILL TWP., INDIANA CO.
 SCALE: 1"=200' SURVEY DATE: 9/16/94
 PREPARED BY: VAPCO ENGINEERING

PENN RUN MINE
 RD 1
 PENN RUN, PA.
 15765

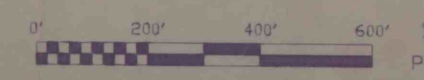

IMAPS#21161