PARDEE BRO'S & CO., Inc.

LATTIMER MINES PA.

INSURANCE MAP

MINE IMPROVEMENTS.

Revised 1924 July

Scale 1 inch = 100 Feet.

Revised Nov. 19, 1929.
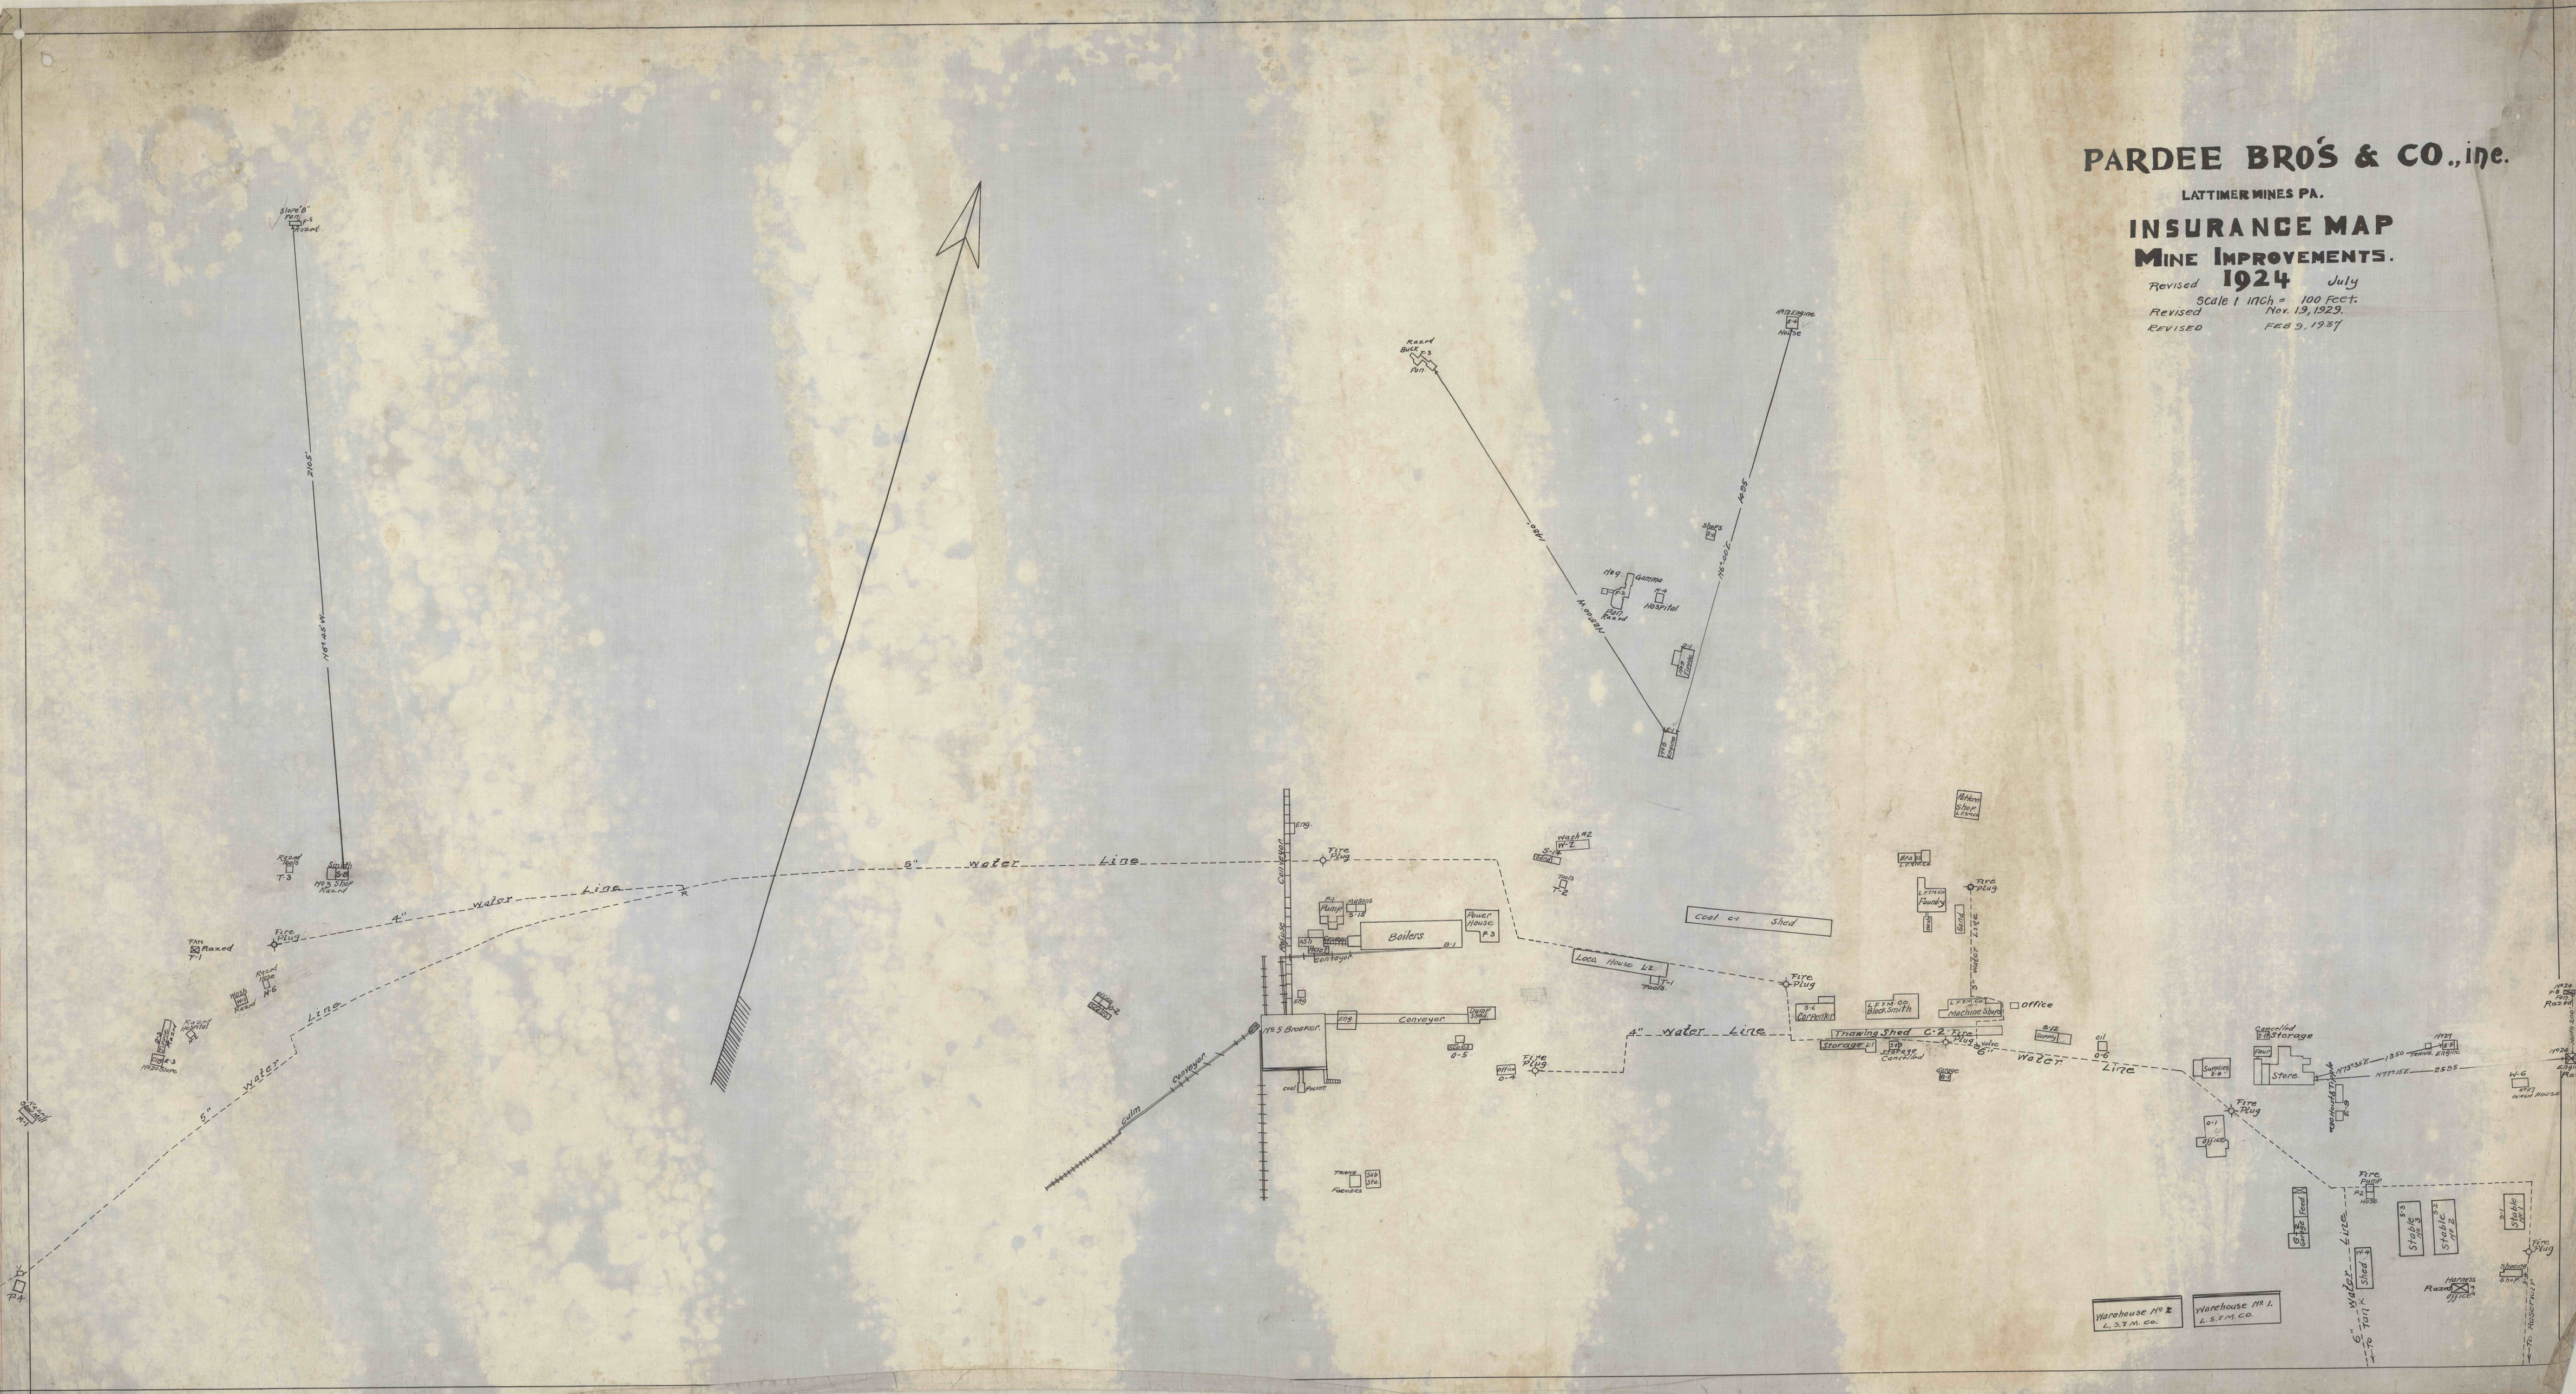
REVISED FEB 9, 1937