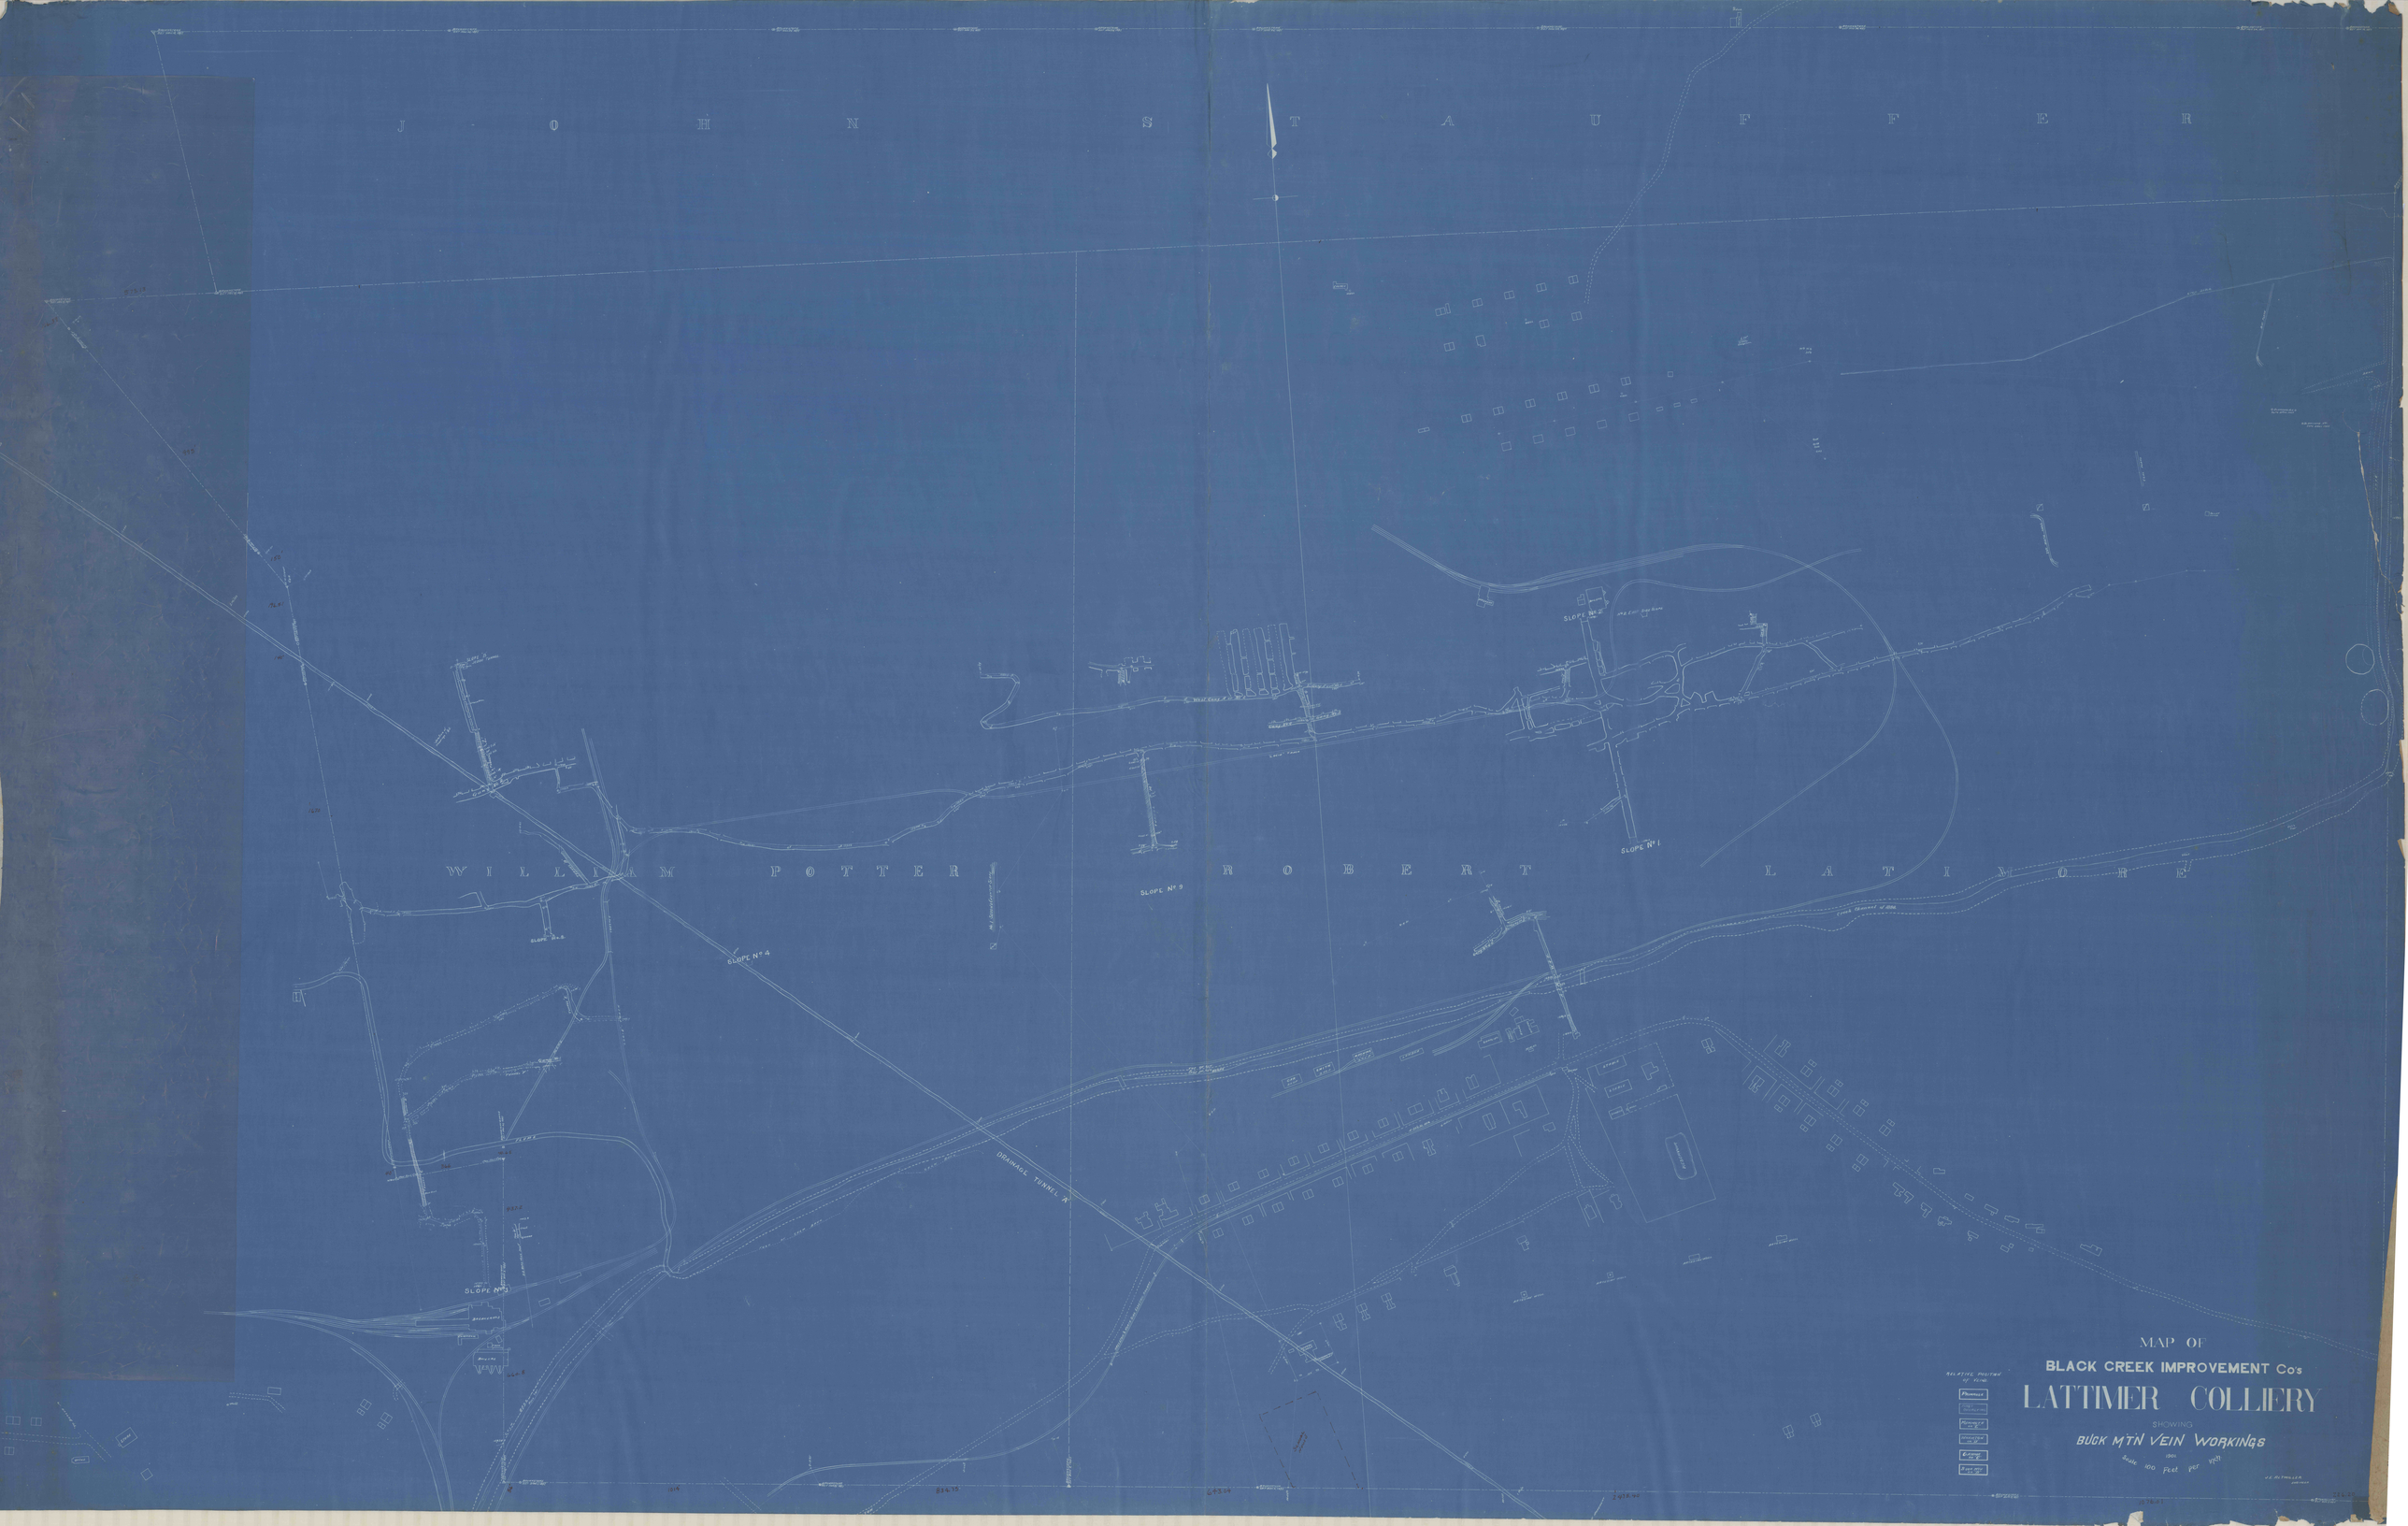
JOHN STAUFFER
WILLIAM POTTER
ROBERT LATIMORE
SLOPE No 1
SLOPE No 2
SLOPE No 3
SLOPE No 4
SLOPE No 5
DRAINAGE TUNNEL "A"
MAP OF
BLACK CREEK IMPROVEMENT Co's
LATTIMER COLLIERY
SHOWING
BUCK MTN VEIN WORKINGS
Scale 100 Feet per inch