


LATTIMER COAL CORP.

LATTIMER MINES PA.
MAP SHOWING
OUTSIDE IMPROVEMENTS
LATTIMER 1/4 MILNESVILLE
Scale 1"=100' 1-30-38

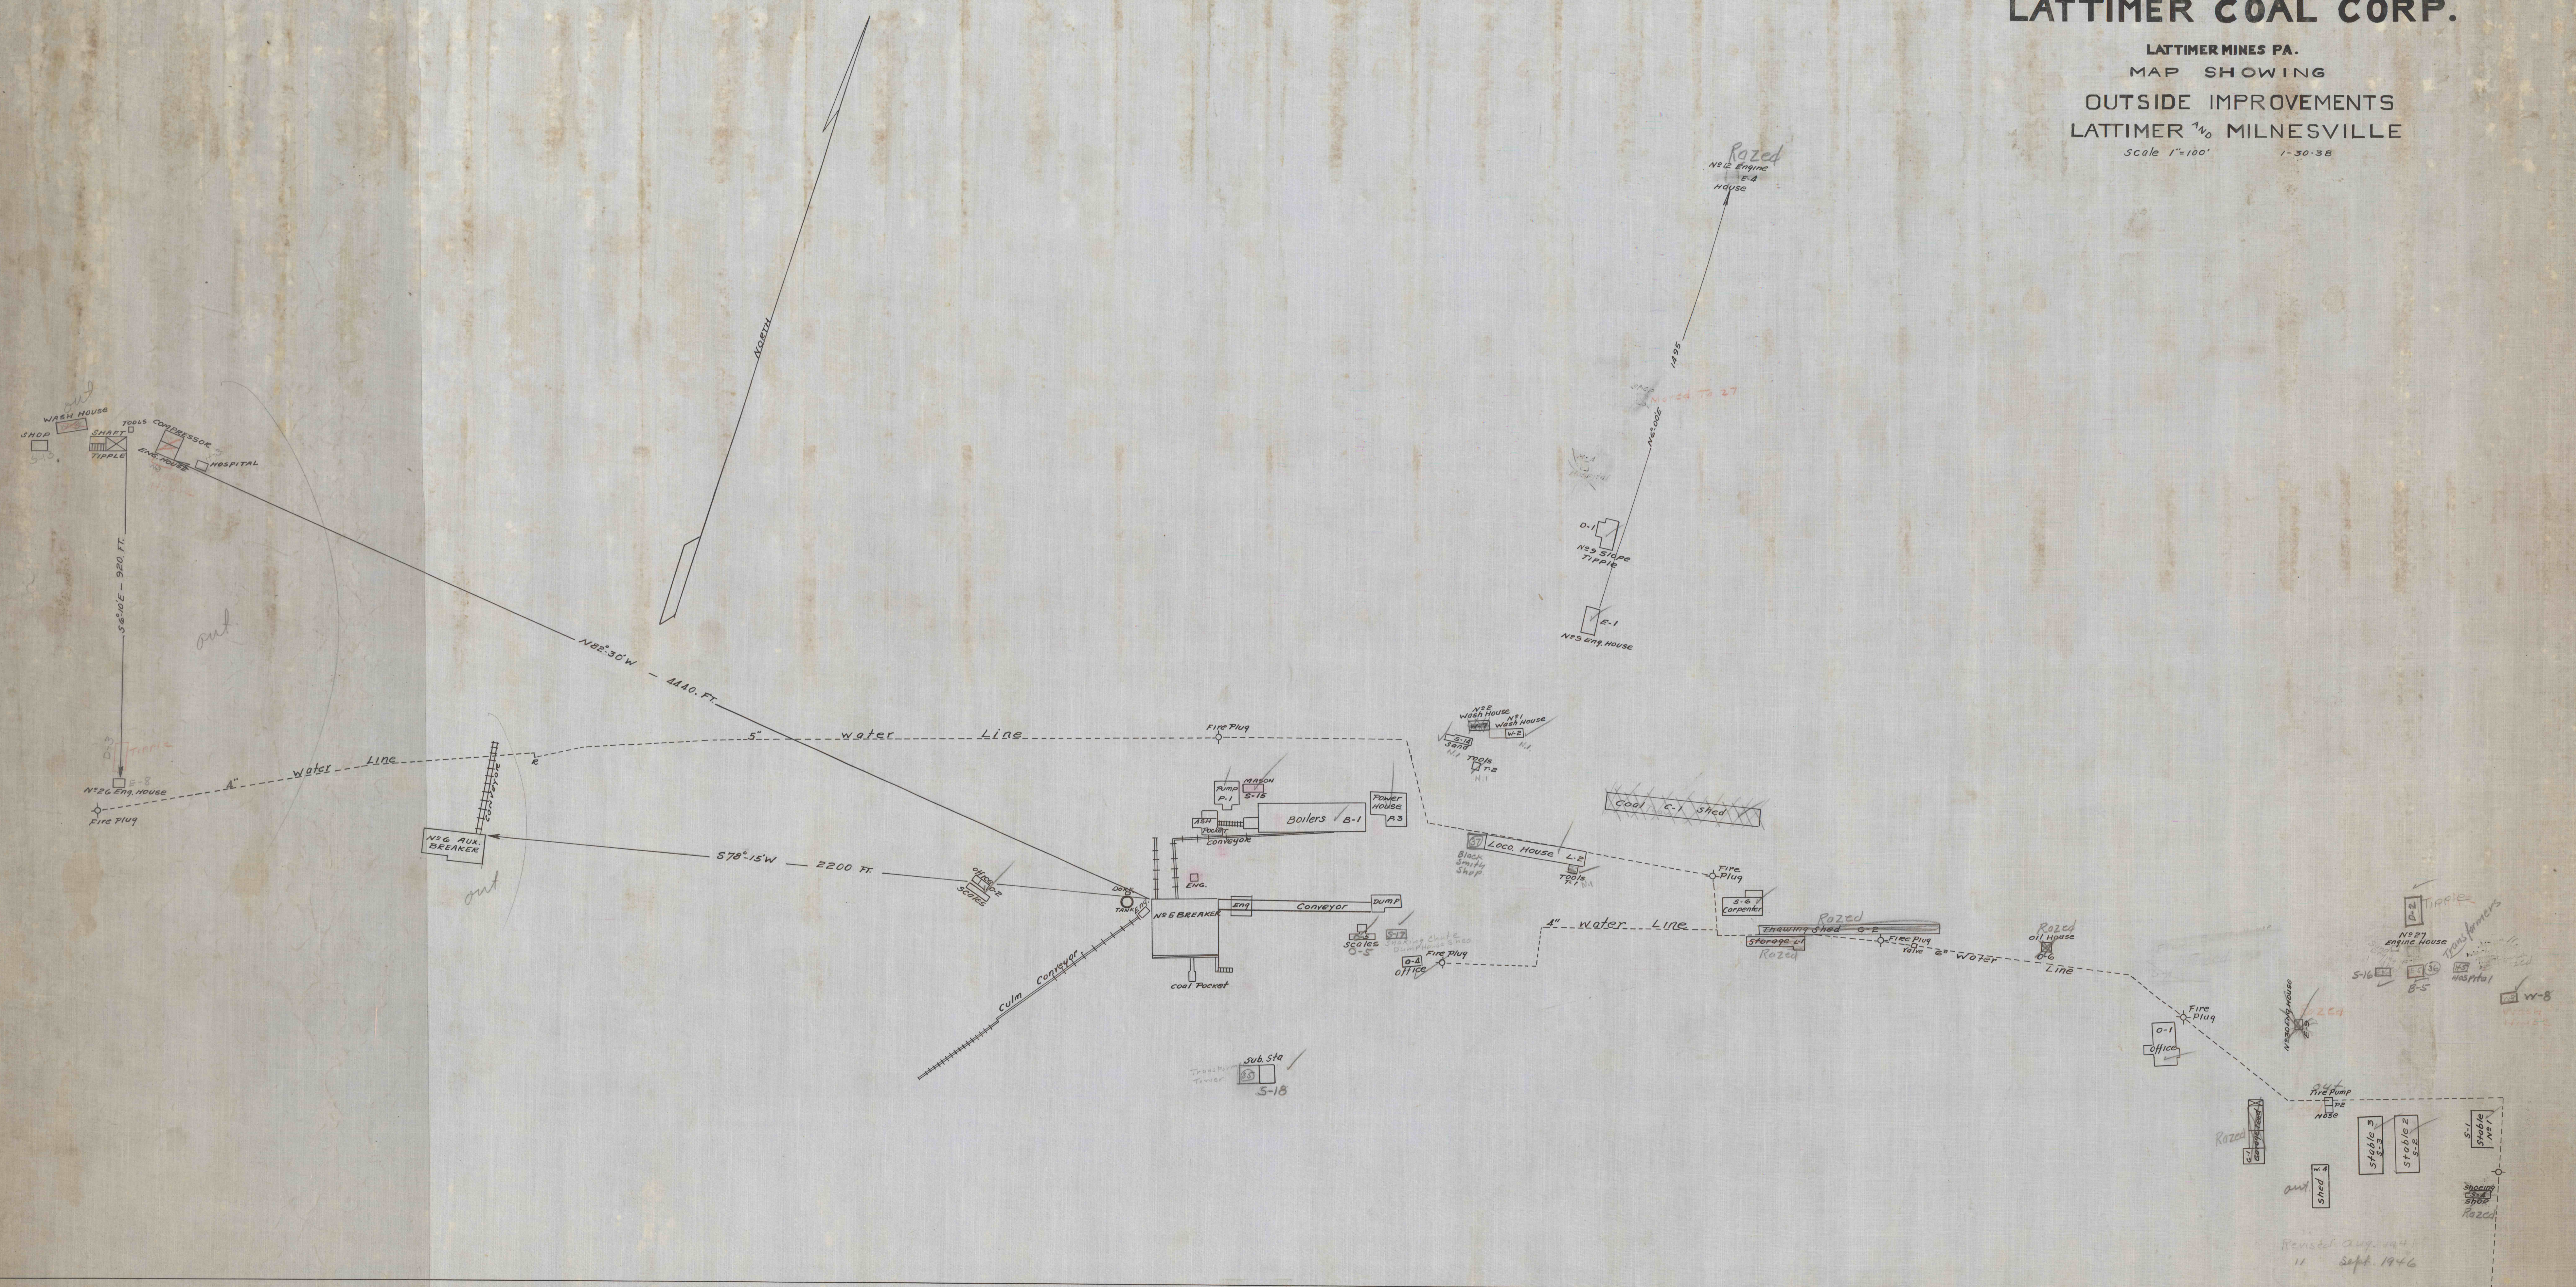

Revised Aug. 1941
11 Sept. 1946