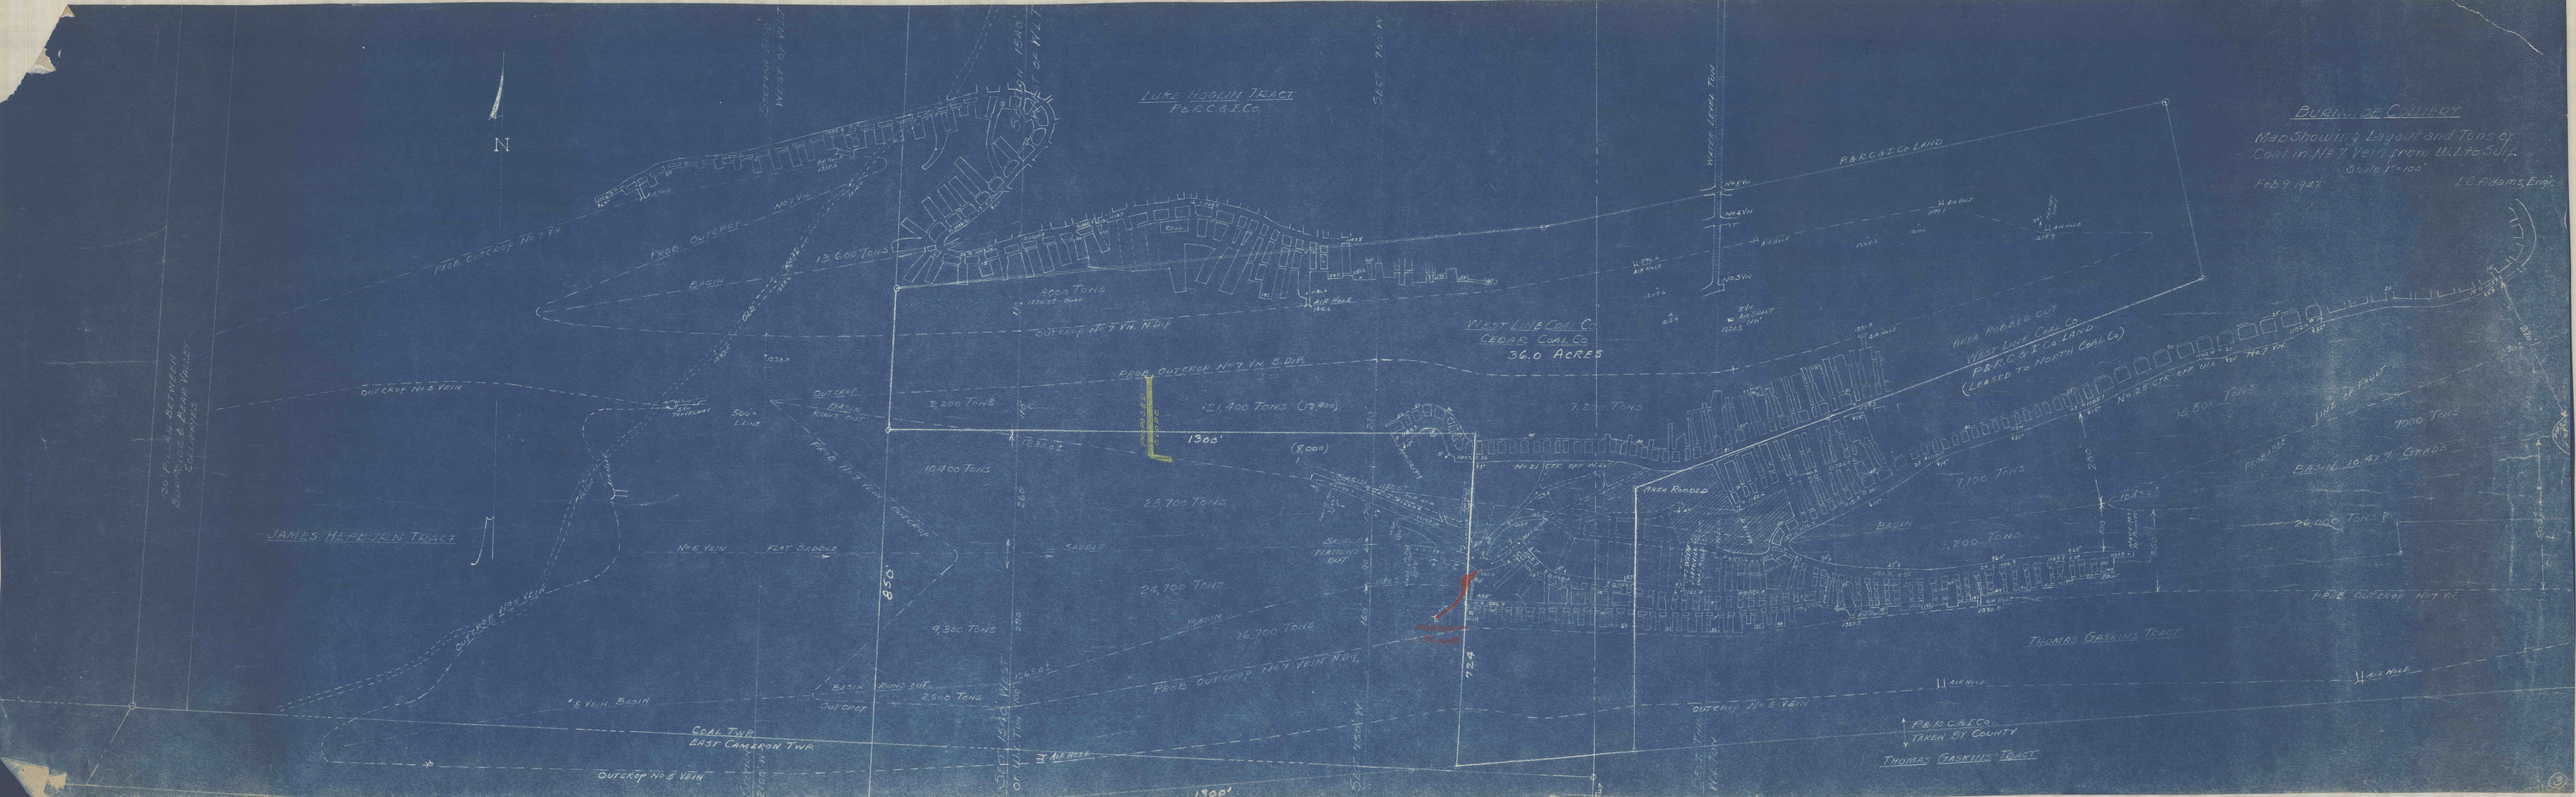
BURNSIDE COLLIERY
Map Showing Layout and Tons of Coal in No 7 Vein from U.L. to Surf.
Scale 1" = 100'
Feb 9 1947
L C Adams, Engr.
N
LUKE HOOLIN TRACT
P&R C&I Co
P&R C&I Co LAND
WEST LINE COAL CO
CEDAR COAL CO
36.0 ACRES
AREA ROBBED OUT
WEST LINE COAL CO
P&R C&I Co LAND
(LEASED TO NORTH COAL CO)
JAMES HEPBURN TRACT
THOMAS GASKINS TRACT
P&R C&I Co
TAKEN BY COUNTY
THOMAS GASKINS TRACT
COAL TWP.
EAST CAMERON TWP.
13,000 TONS
8000 TONS
2,200 TONS
21,400 TONS (3,400)
(8,000)
1300'
16,400 TONS
22,700 TONS
24,700 TONS
16,700 TONS
9,300 TONS
2,800 TONS
7,200 TONS
7,100 TONS
200 TONS
15,800 TONS
1000 TONS
26,000 TONS
BASIN 10.41% GRADE
PROB. OUTCROP No 7 VEIN
PROB. OUTCROP No 7 VEIN N DIP
PROB. OUTCROP No 7 VEIN S DIP
OUTCROP No 7 VEIN
OUTCROP No 8 VEIN
OUTCROP No 5 VEIN
OUTCROP No 4 VEIN
OUTCROP No 3 VEIN
No 6 VEIN
FLAT SADDLE
SADDLE
BASIN
AIR HOLE
850'
724'
1300'