


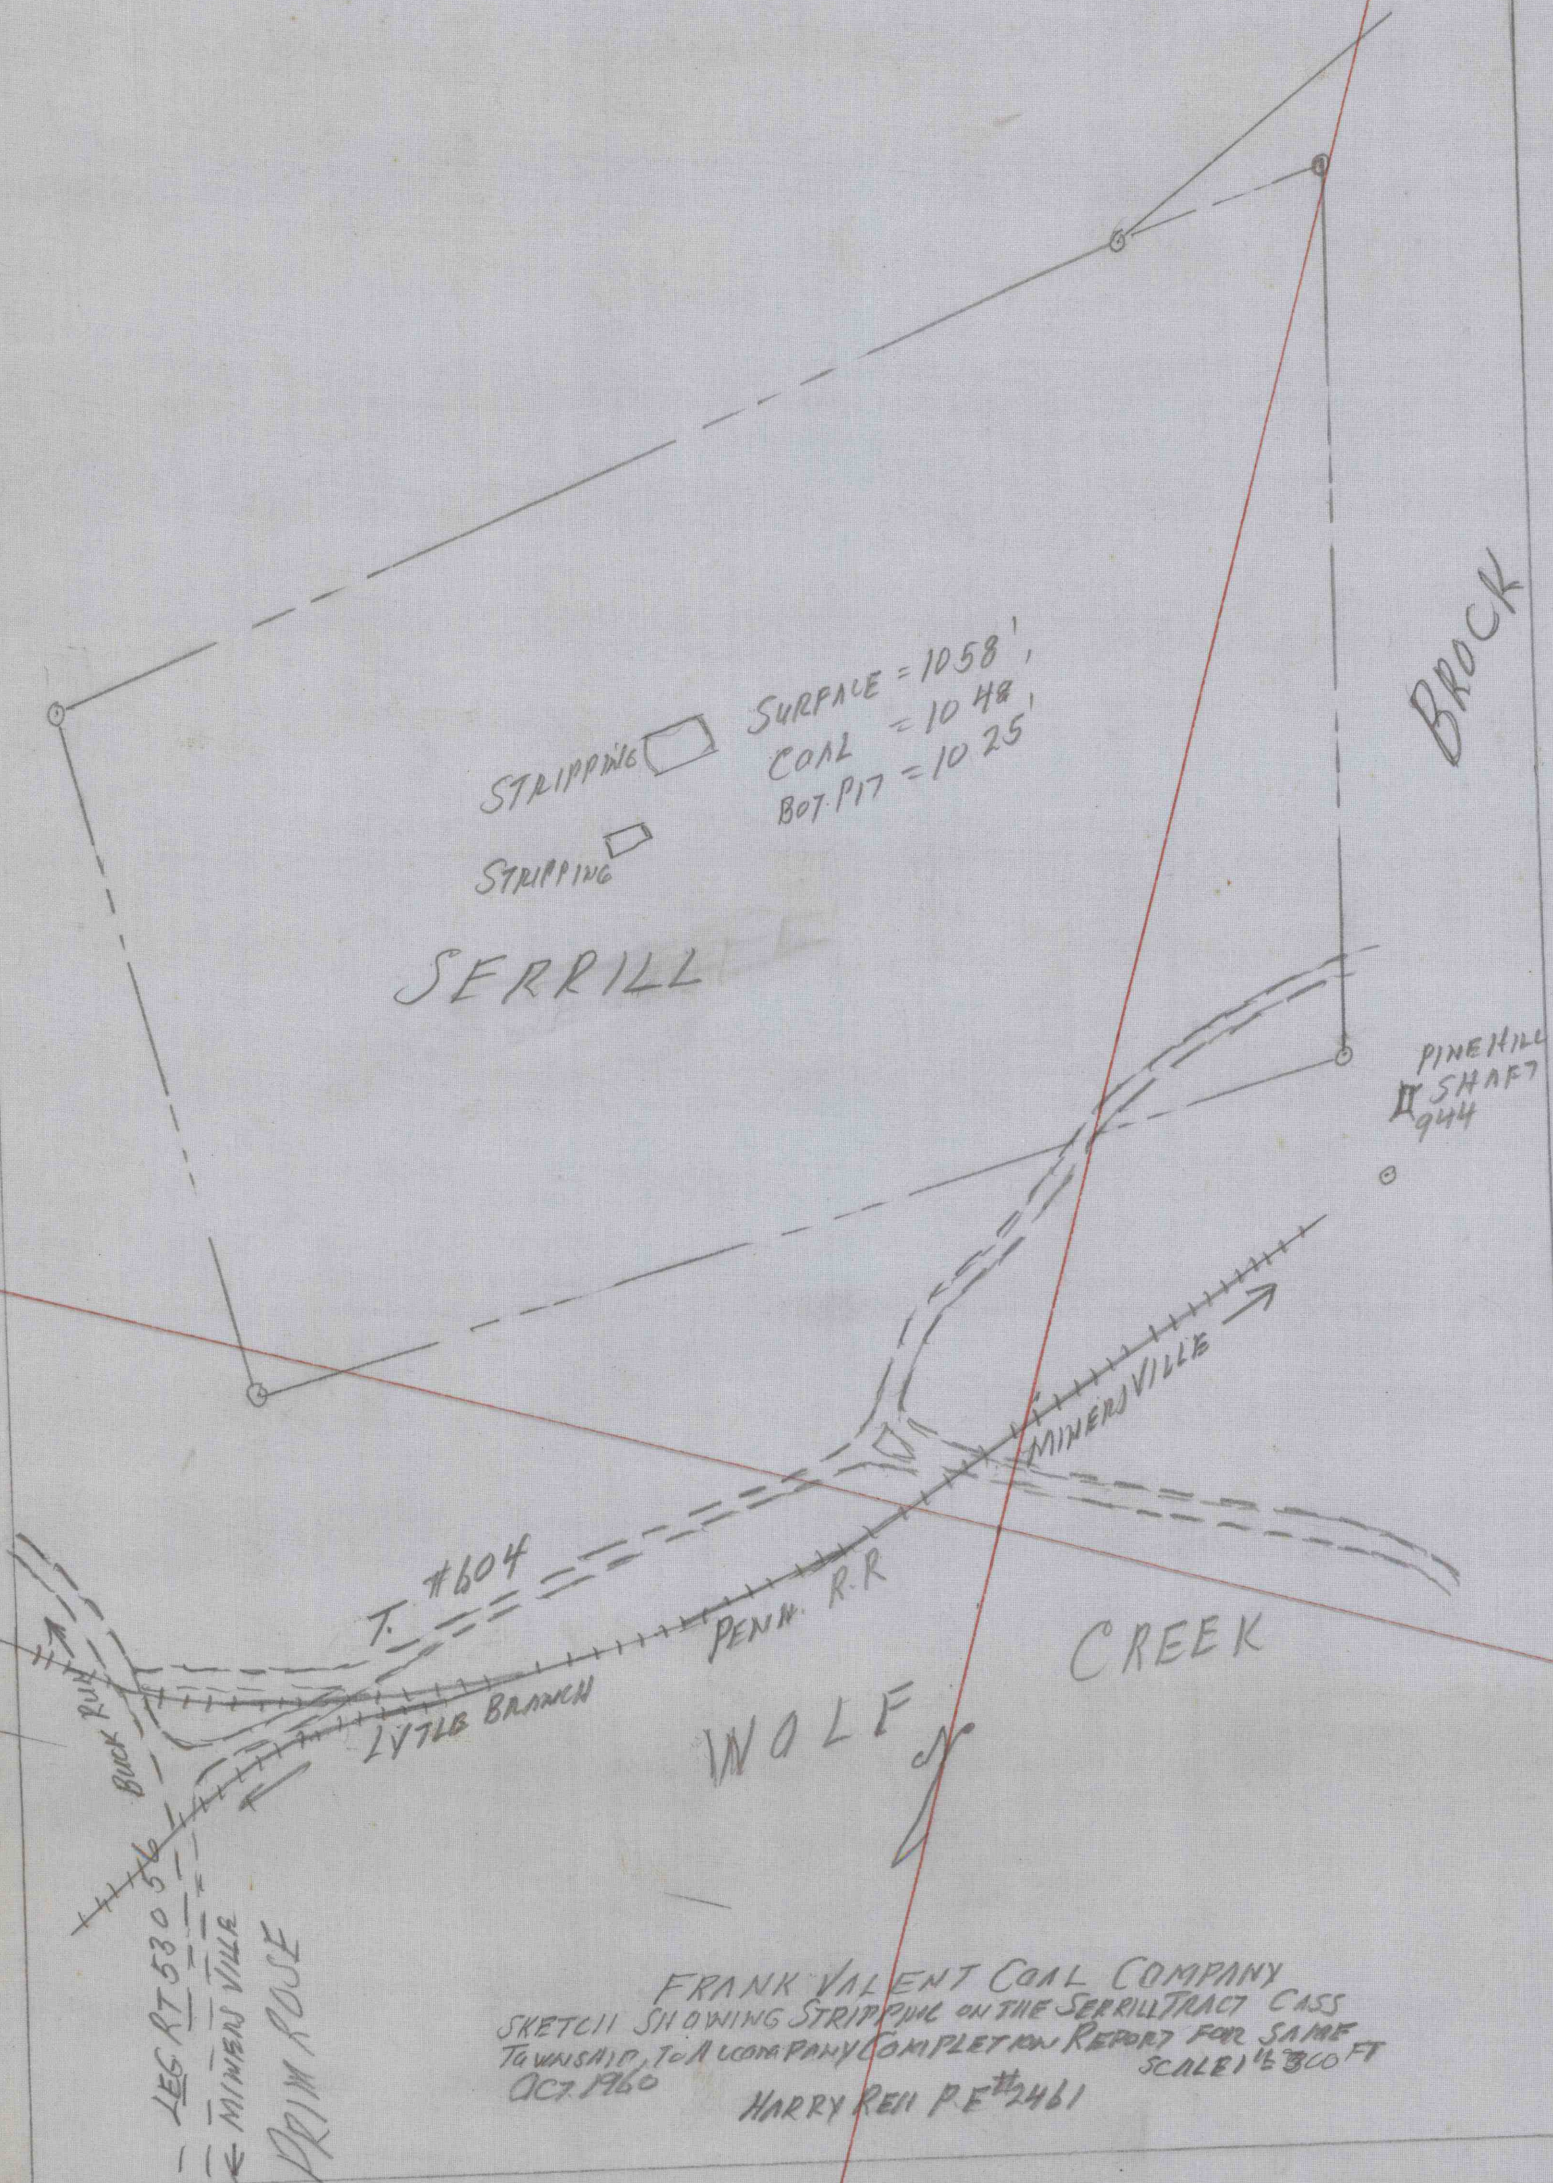

STRIPPING 
STRIPPING 
SURFACE = 1058'
COAL = 1048'
BOT. P17 = 1025'

SERRILL

BROCK

PINE HILL
SHAFT
#944

MINERSVILLE →

T. #604

PENN. R.R.

CREEK

WOLF

LITTLE BRANCH

LEG RT 530 S
MINERSVILLE
PRIM ROSE

FRANK VALENT COAL COMPANY
SKETCH SHOWING STRIPPING ON THE SERRILL TRACT CASS
TOWNSHIP, TO A COMPANY COMPLETION REPORT FOR SAME
OCT 1960
HARRY REH P.E. #2461
SCALE 1" = 300 FT