


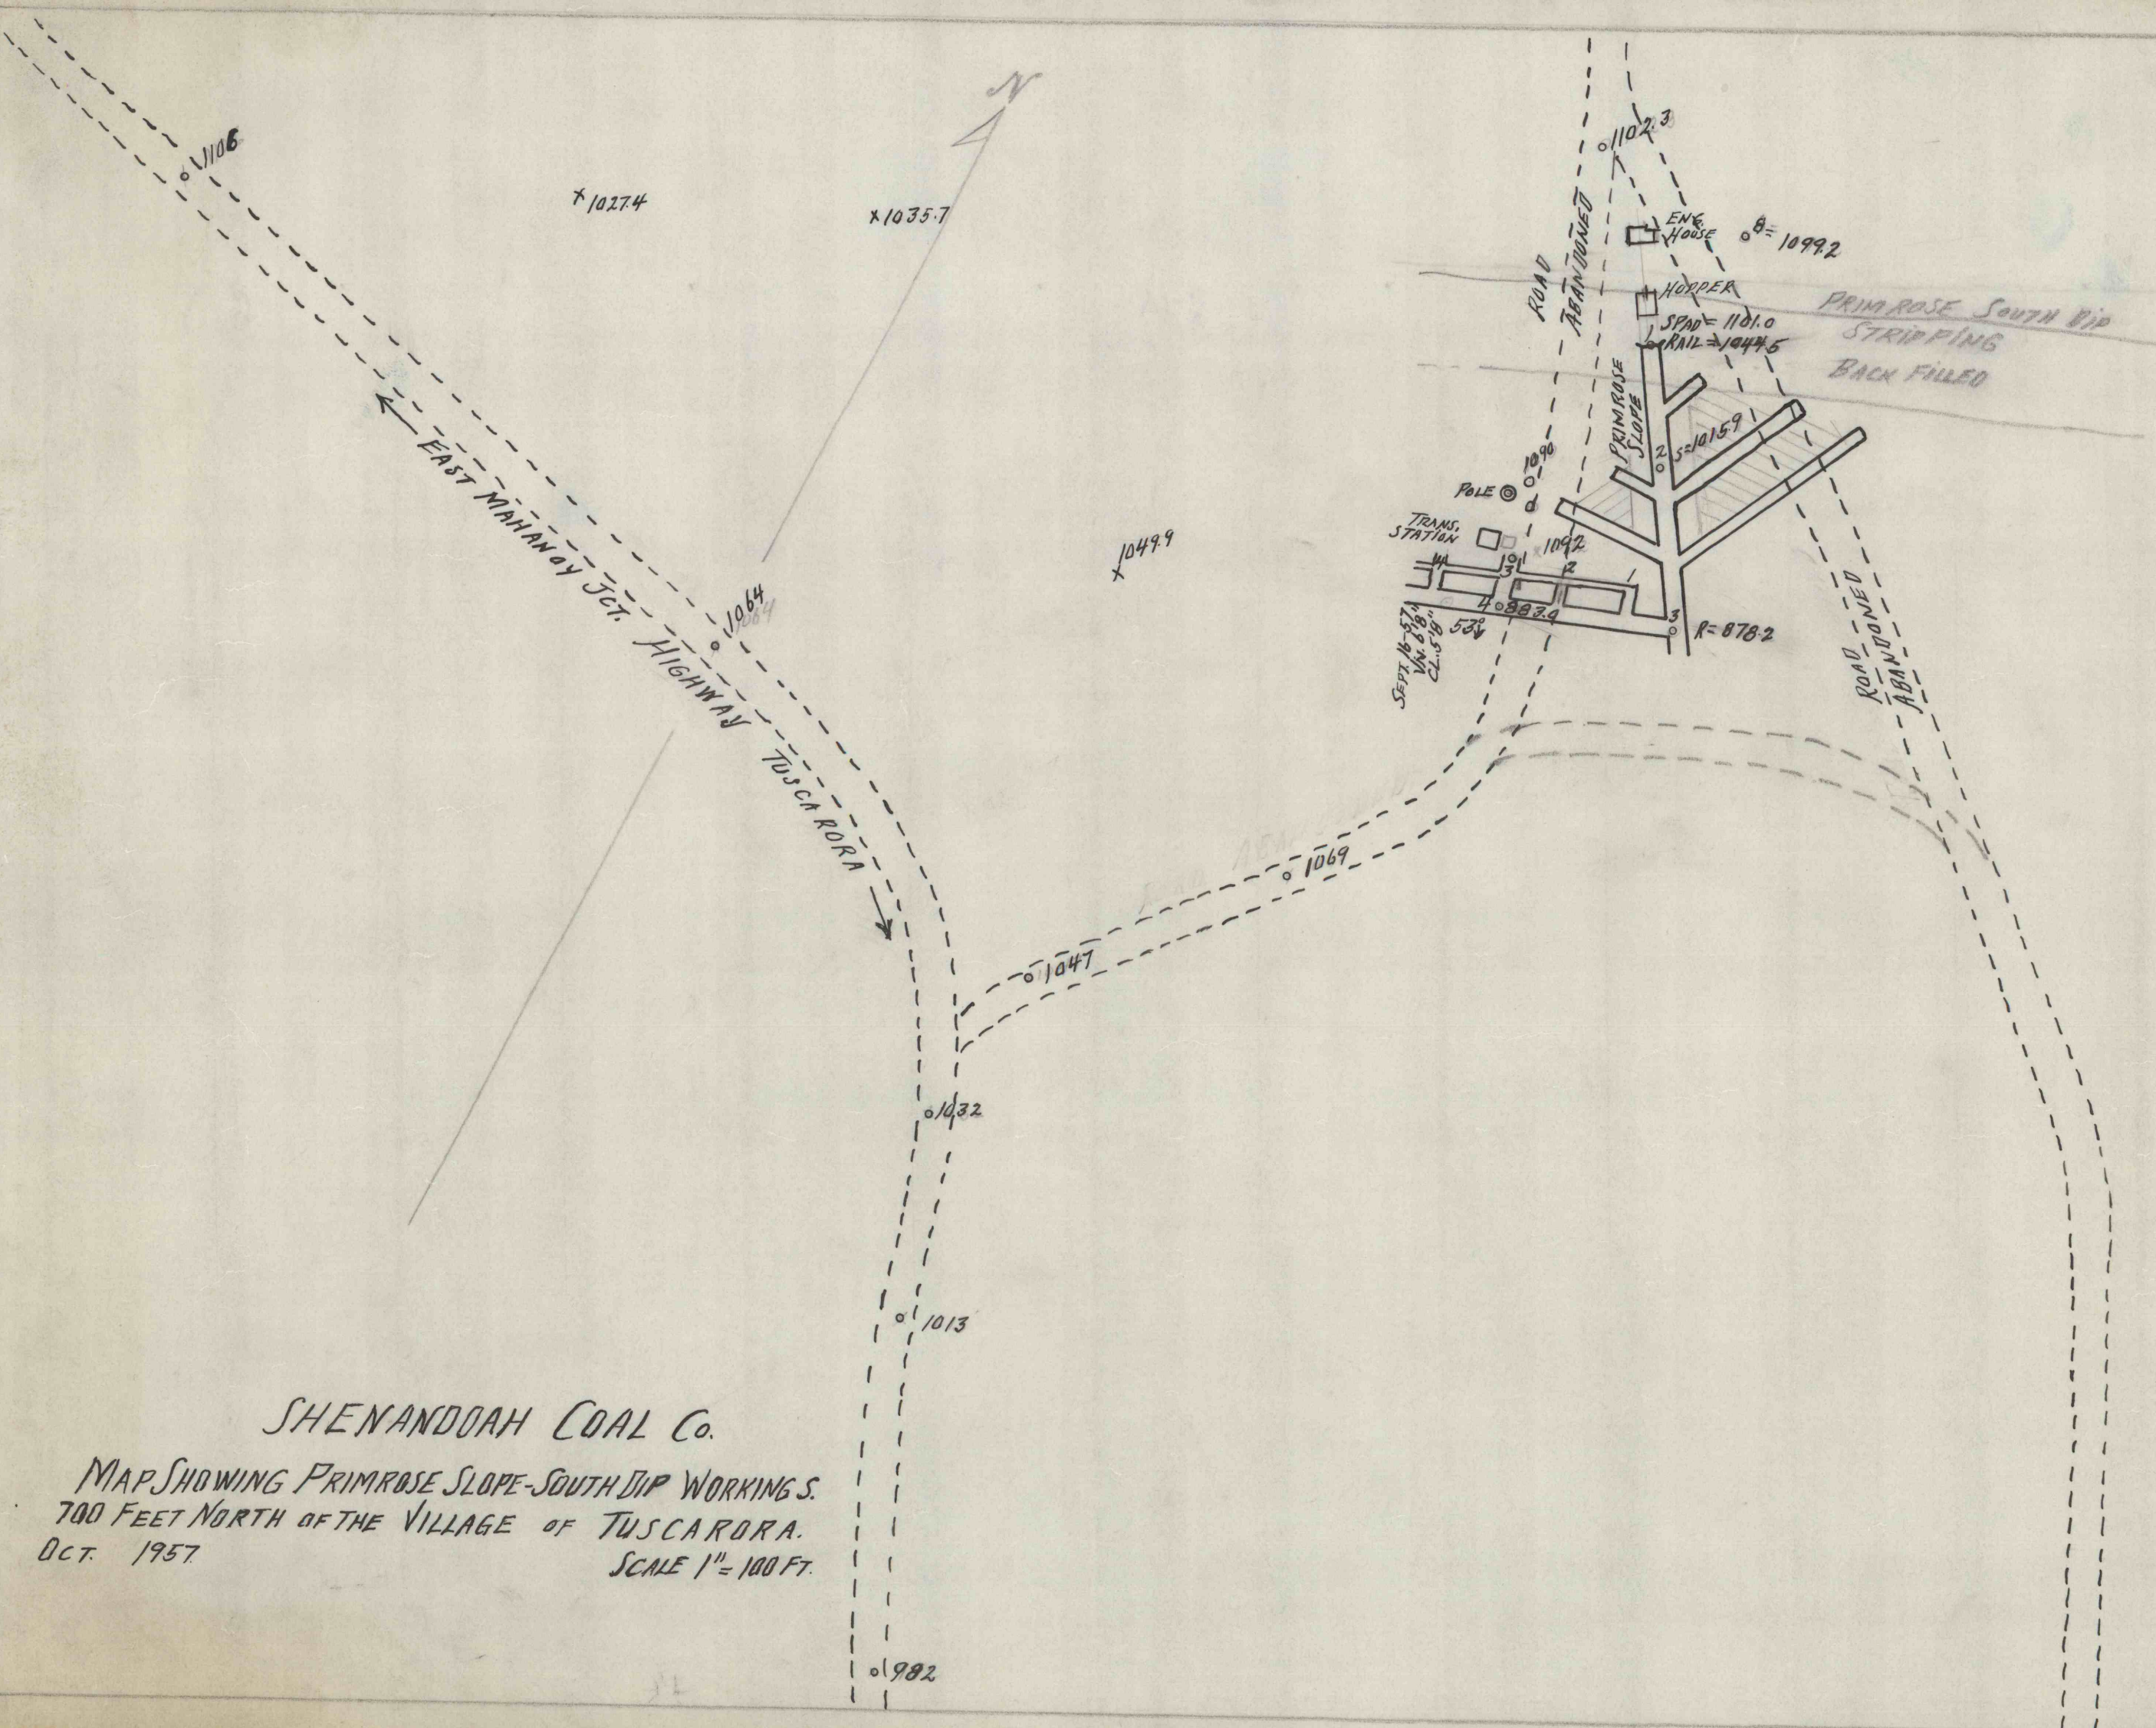

SHENANDOAH COAL CO.

MAP SHOWING PRIMROSE SLOPE-SOUTH DIP WORKINGS.  
700 FEET NORTH OF THE VILLAGE OF TUSCARORA.  
OCT. 1957  
SCALE 1" = 100 FT.