




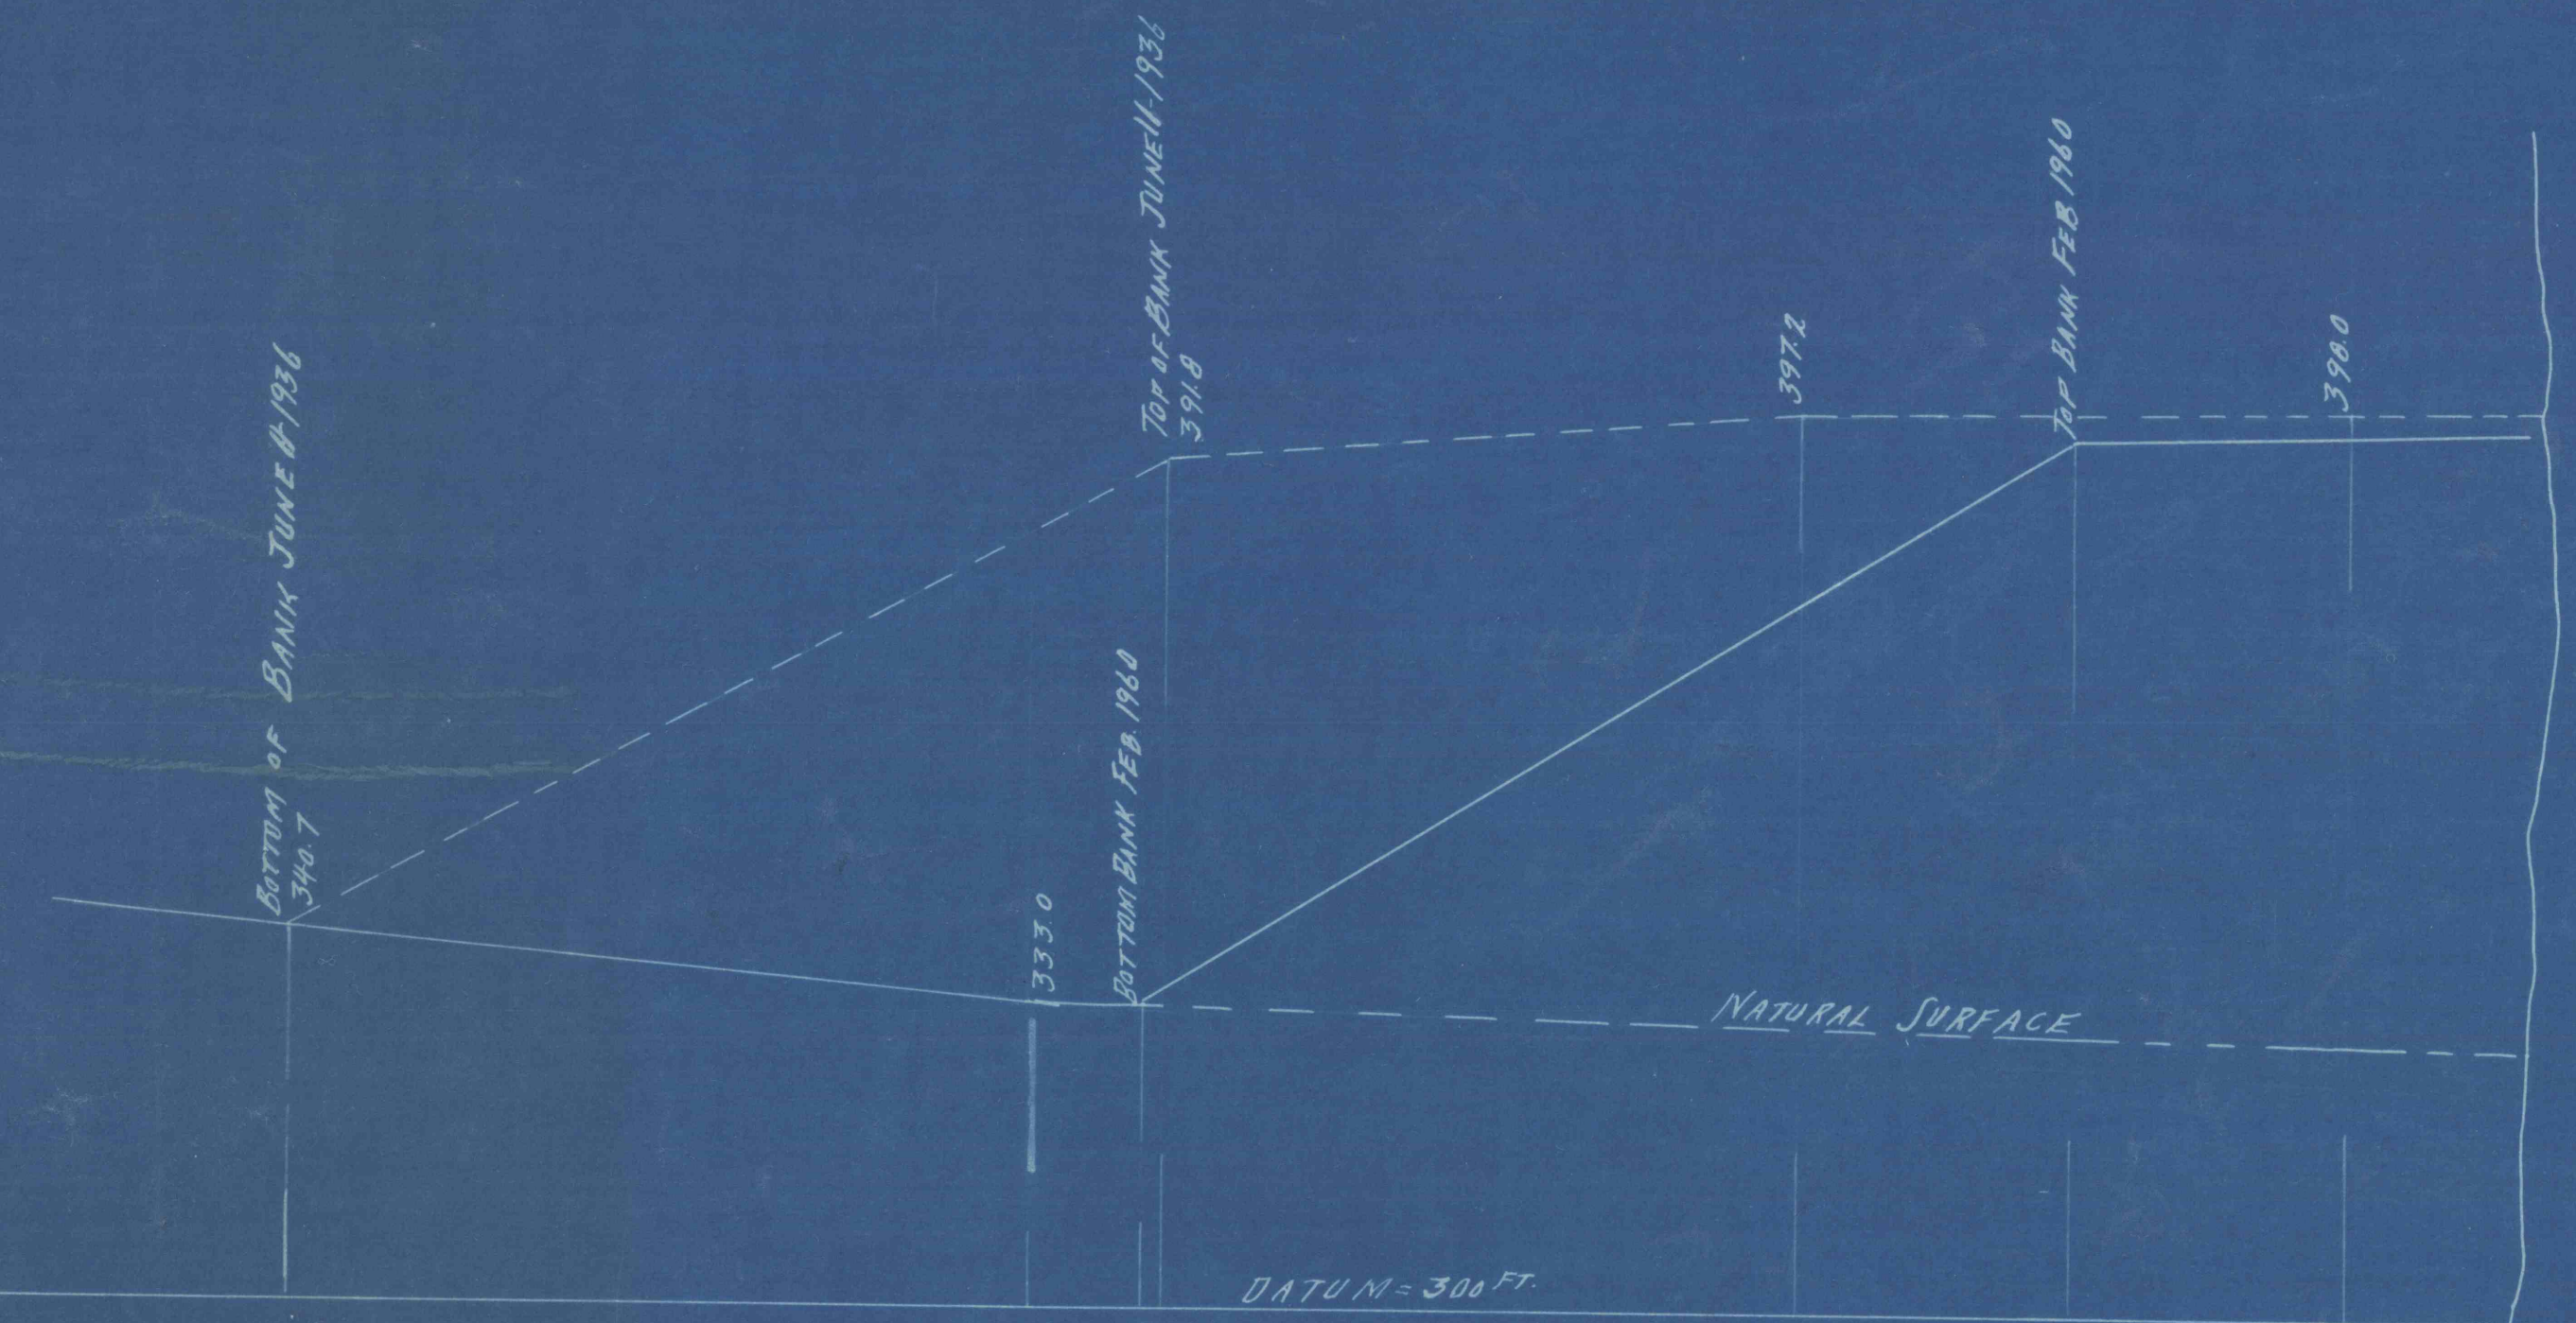

SCALE 1" = 20 FT
SECTION THRU "C"-C' LOOKING NORTH WEST

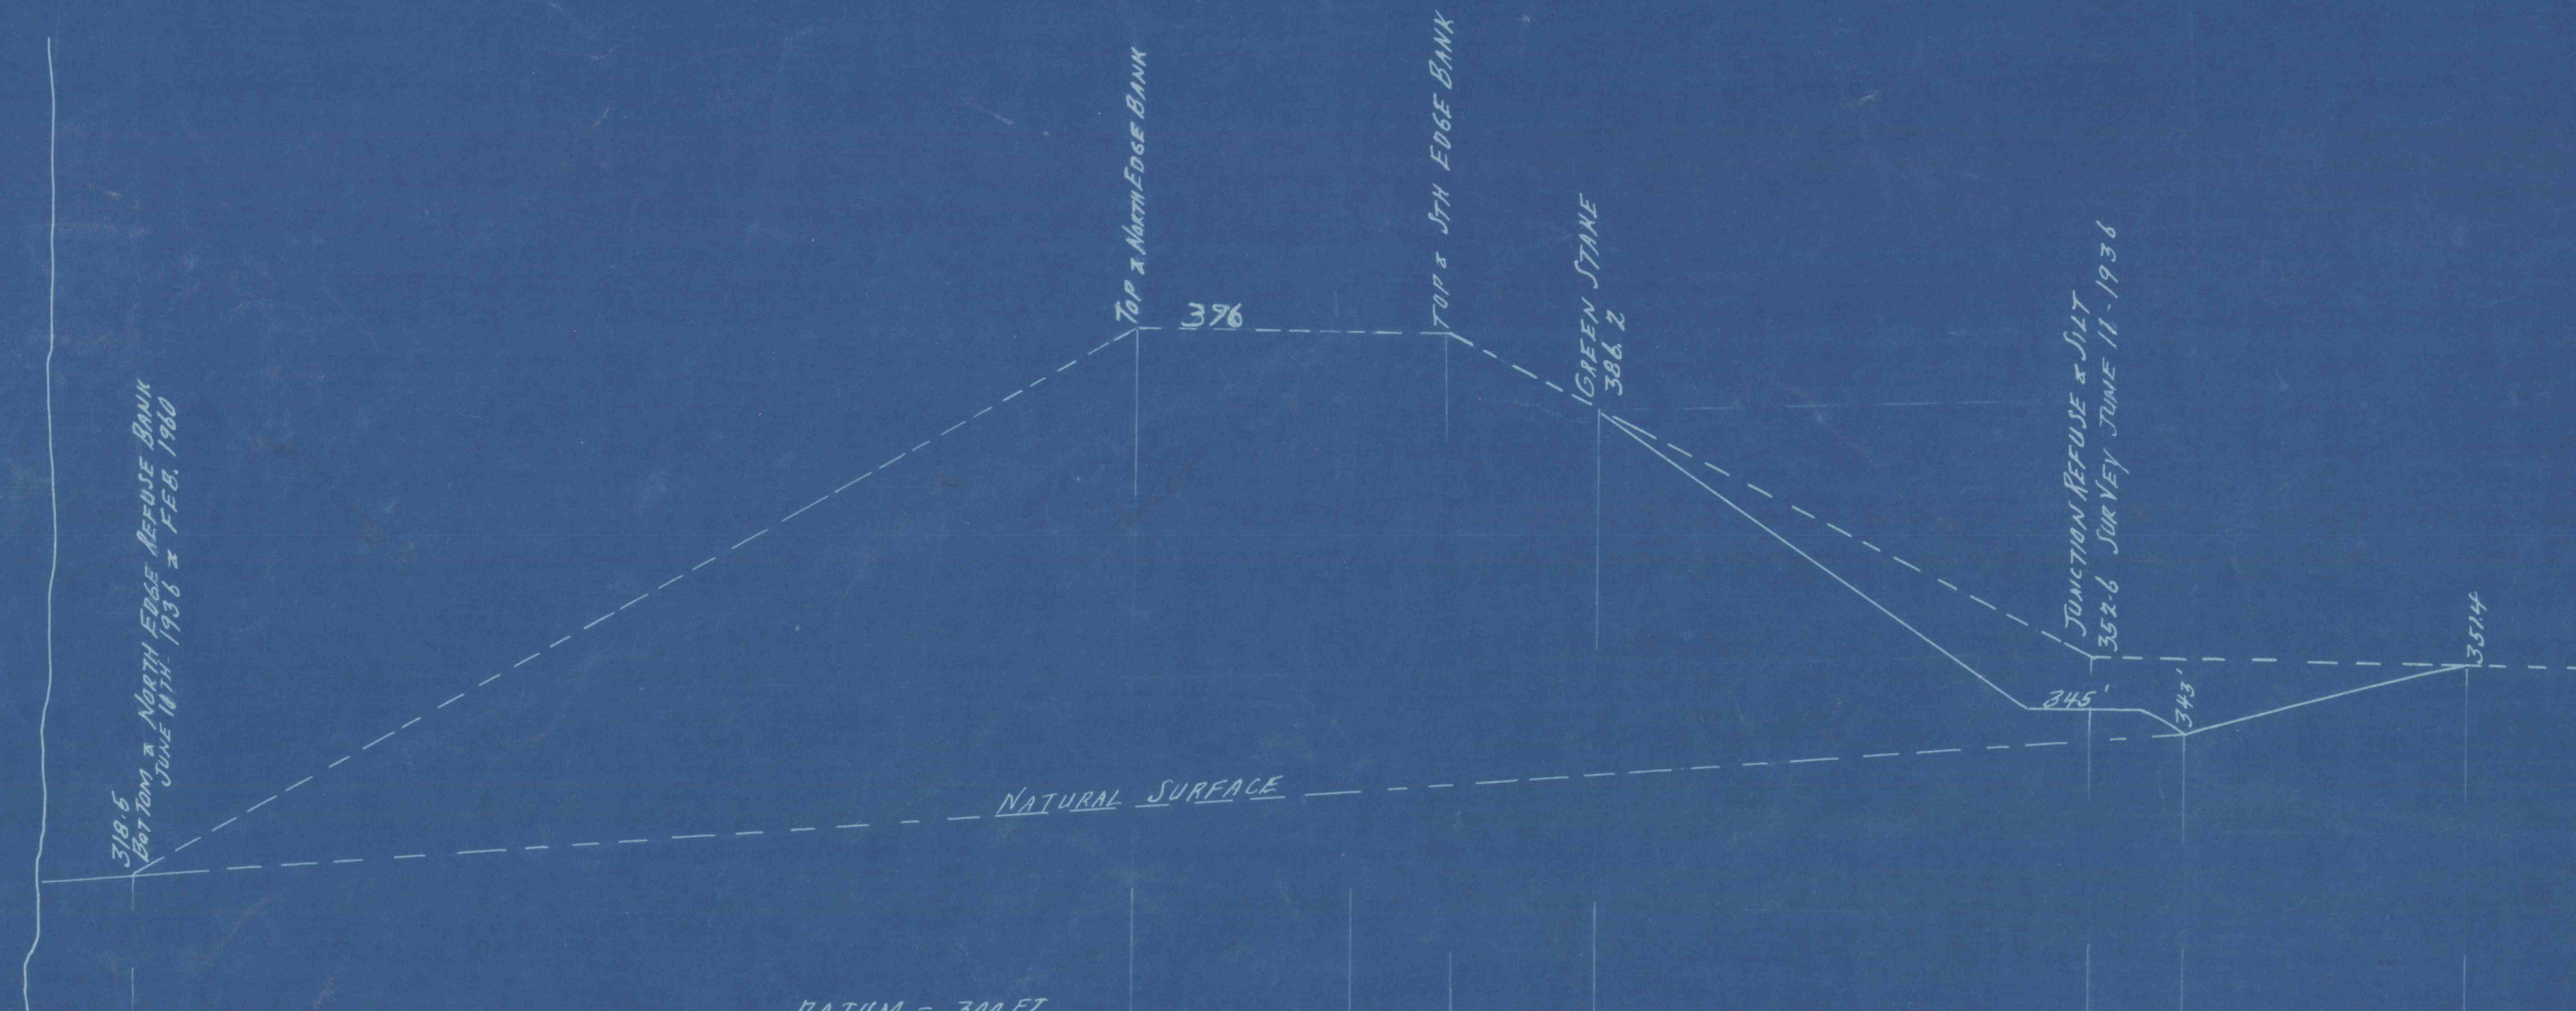

SCALE 1" = 20 FT
SECTION THRU "A"-A' LOOKING EAST

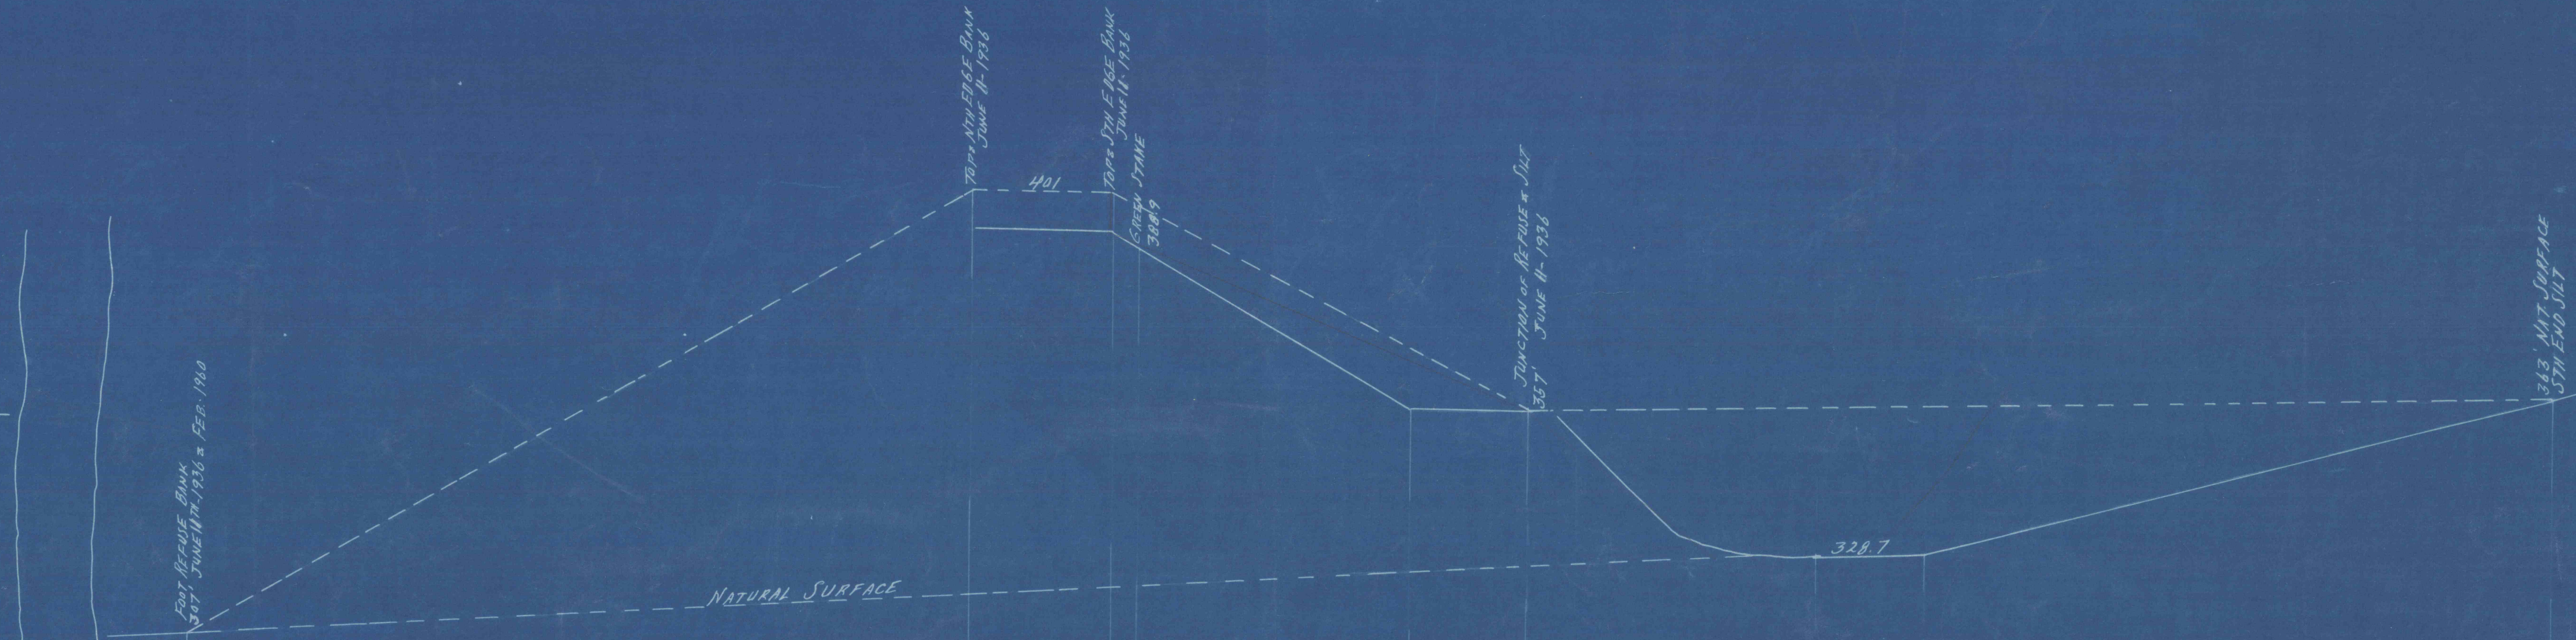

SCALE 1" = 20 FT
SECTION THRU "B"-B' LOOKING EAST

MAHANDY TOWNSHIP SCHUYLKILL COUNTY PENN.
BUCK MOUNTAIN NO. 1 SLOPE REFUSE BANKS OF THE LEHIGH VALLEY COAL CO.
CROSS SECTIONS THRU VARIOUS AREAS IN RELATION TO THE SILT AND REFUSE
SCALE 1" = 20 FT
HARRY REH. PROF. ENGR. #2461
FEB 1960