


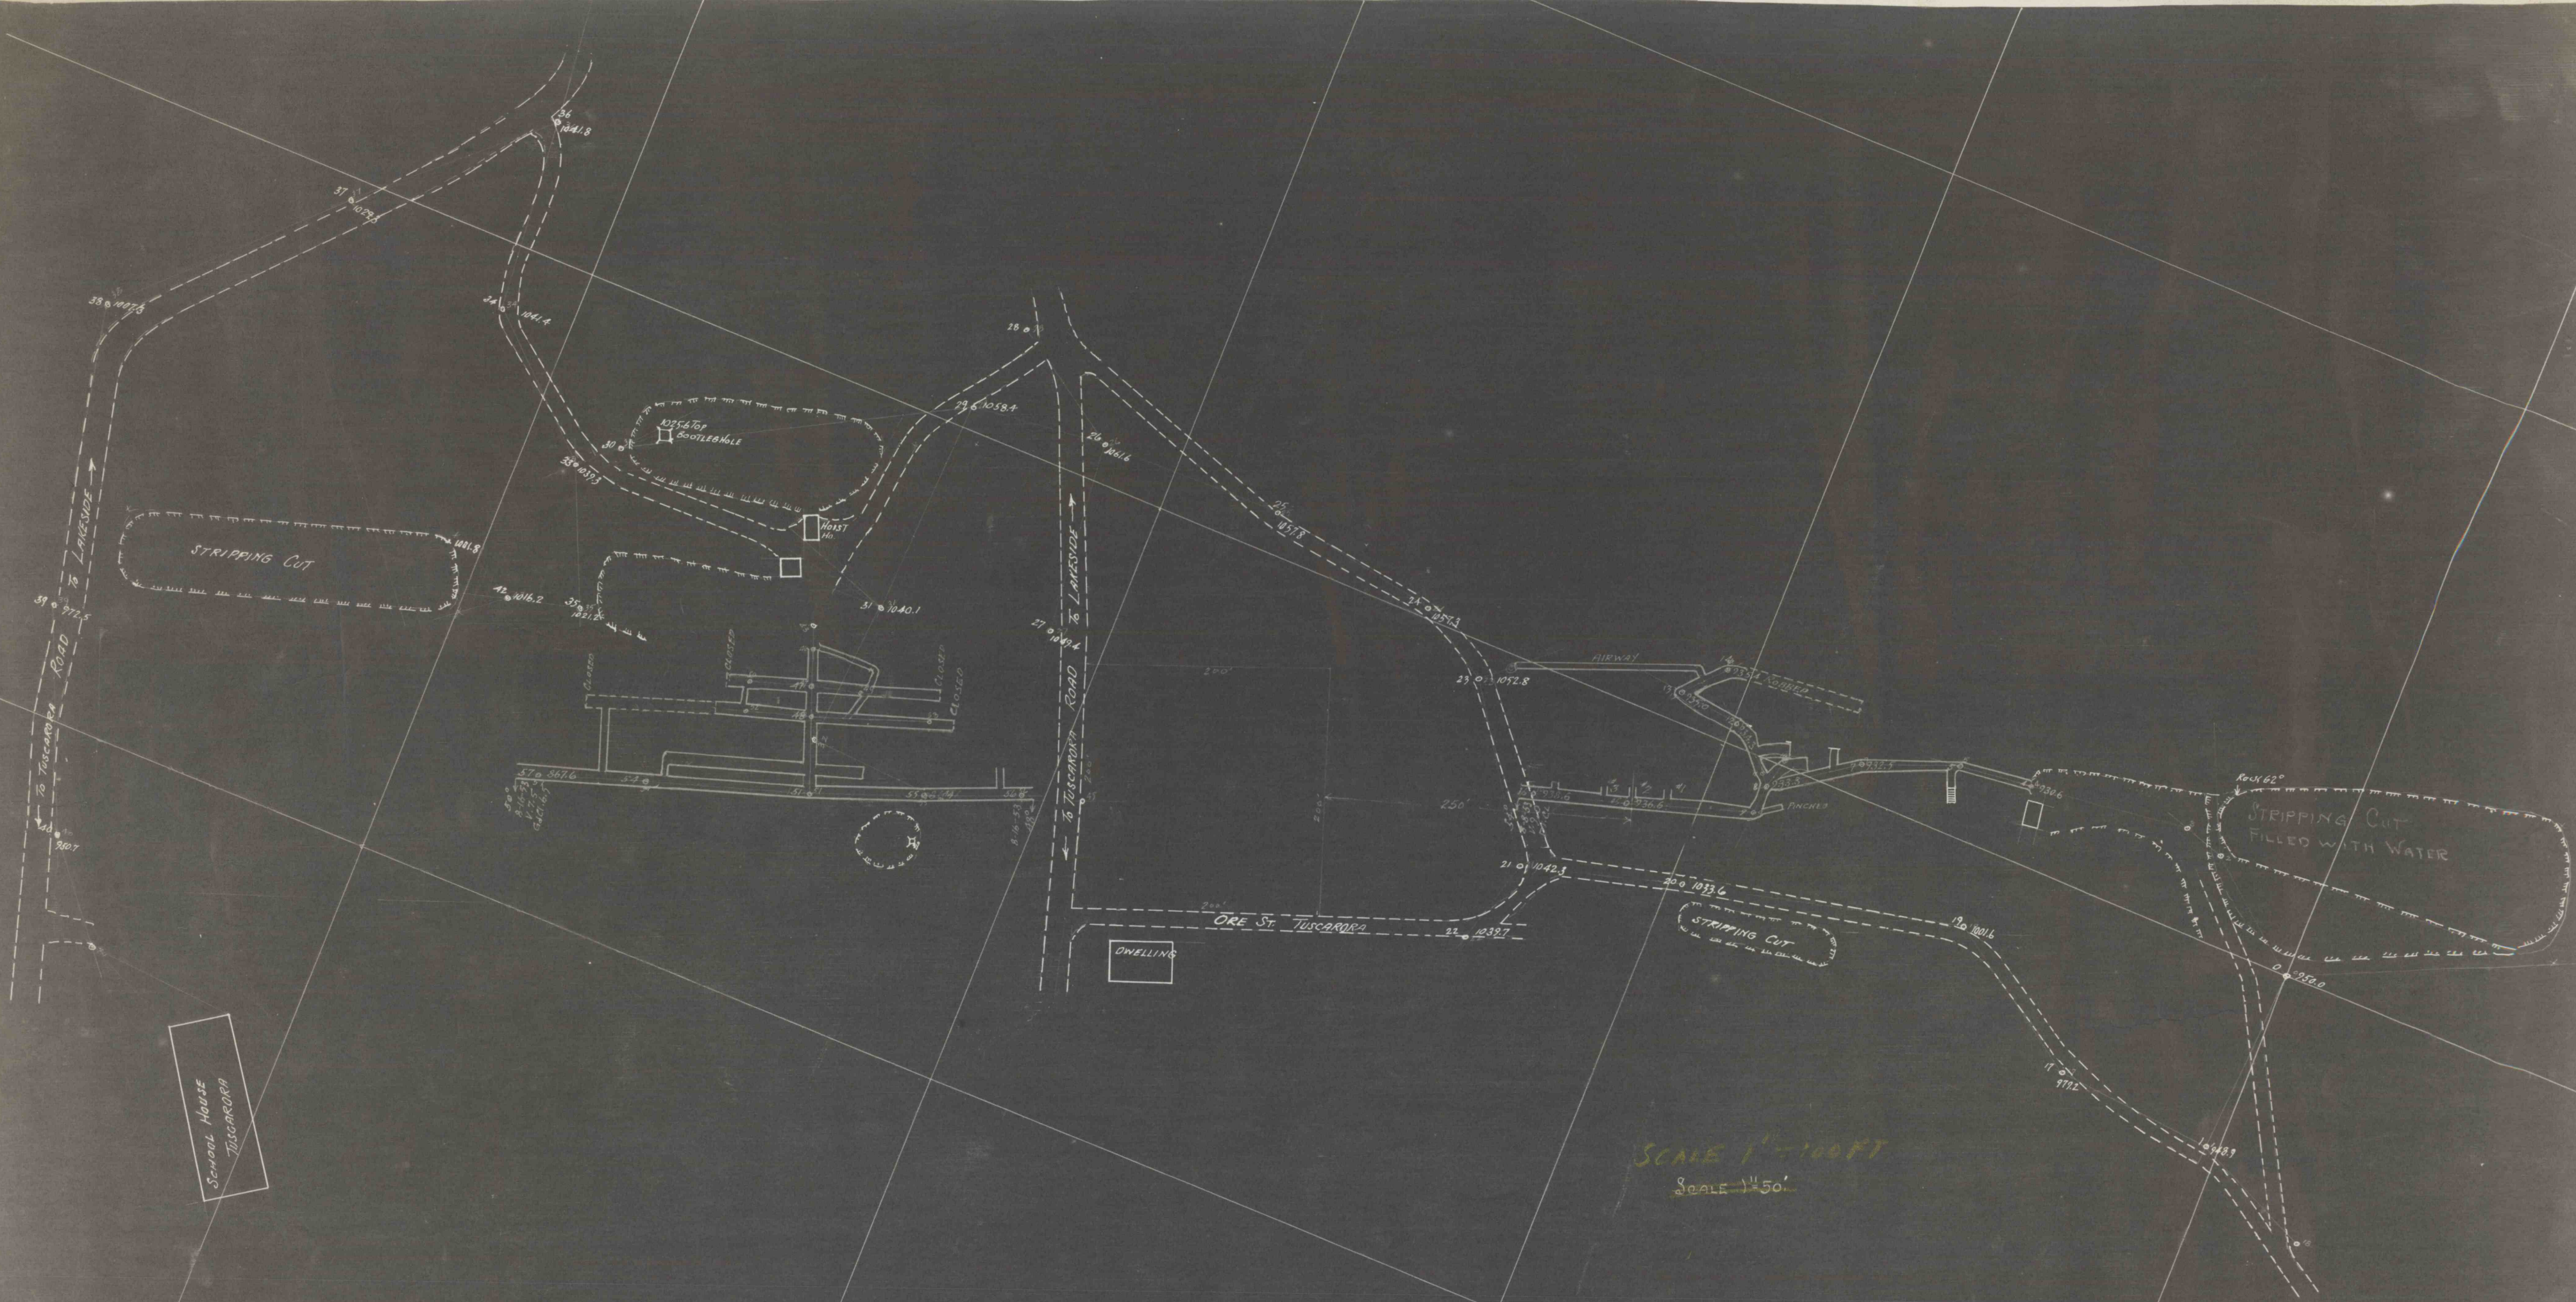

SCALE 1"=100 FT
SCALE 1"=50'