




④

У-Н 2

-NORTA

SCALE 1" = 100'

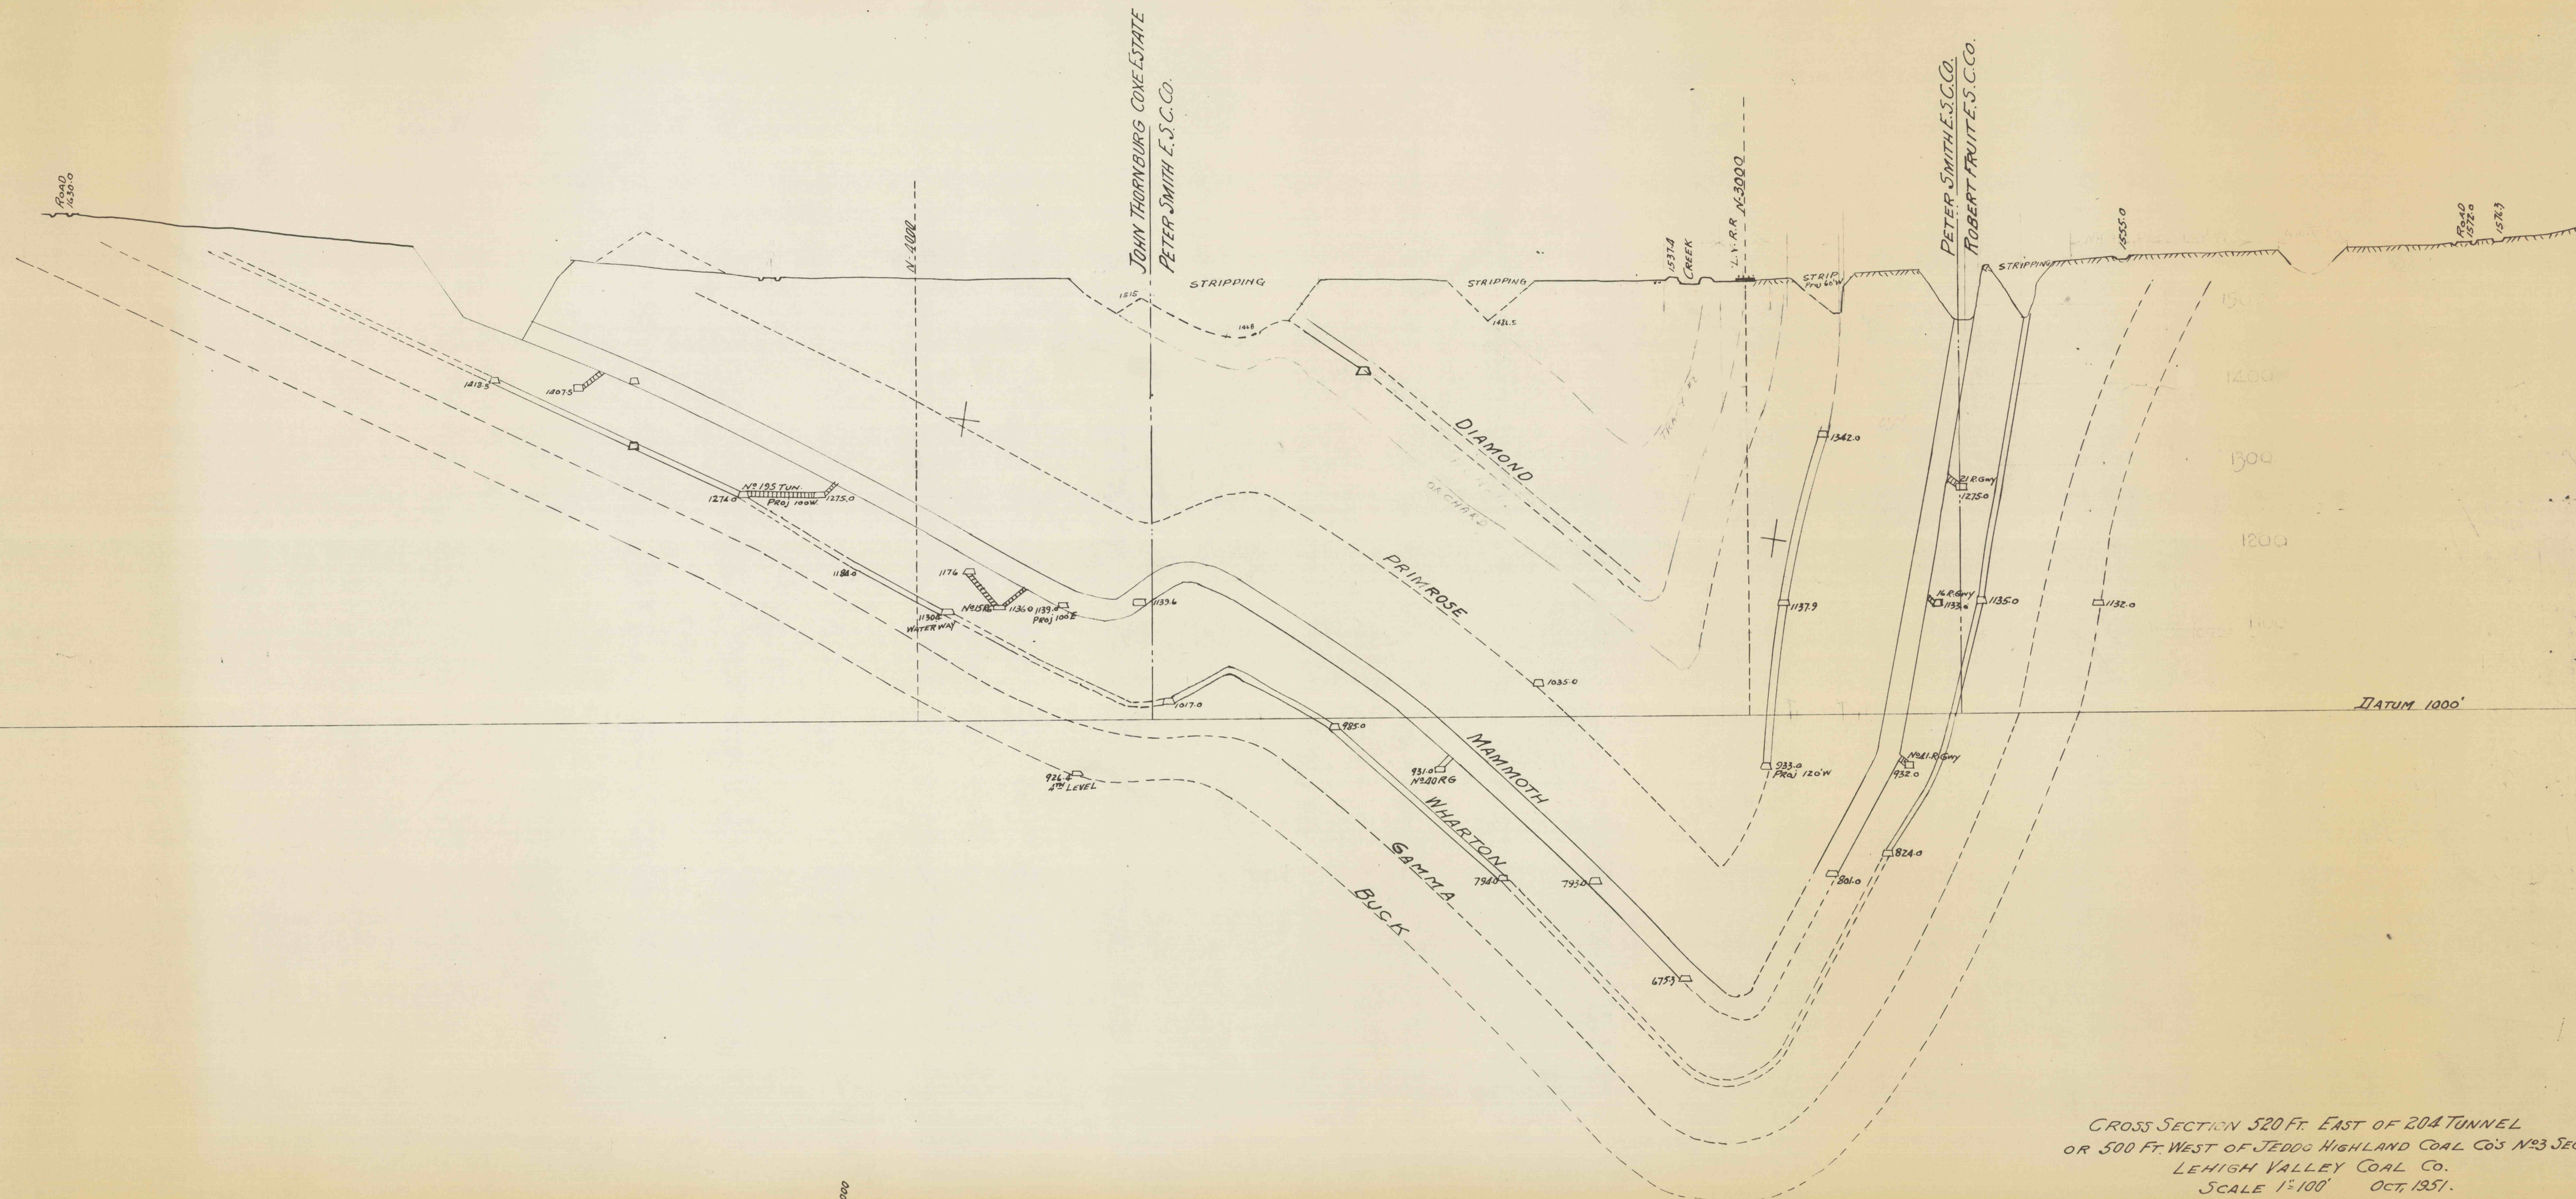

CROSS SECTION 520 FT. EAST OF 204 TUNNEL
OR 500 FT. WEST OF JEDOO HIGHLAND COAL CO.'S N^o 23 SECTION
LEHIGH VALLEY COAL CO.
SCALE 1"=100' OCT, 1951.