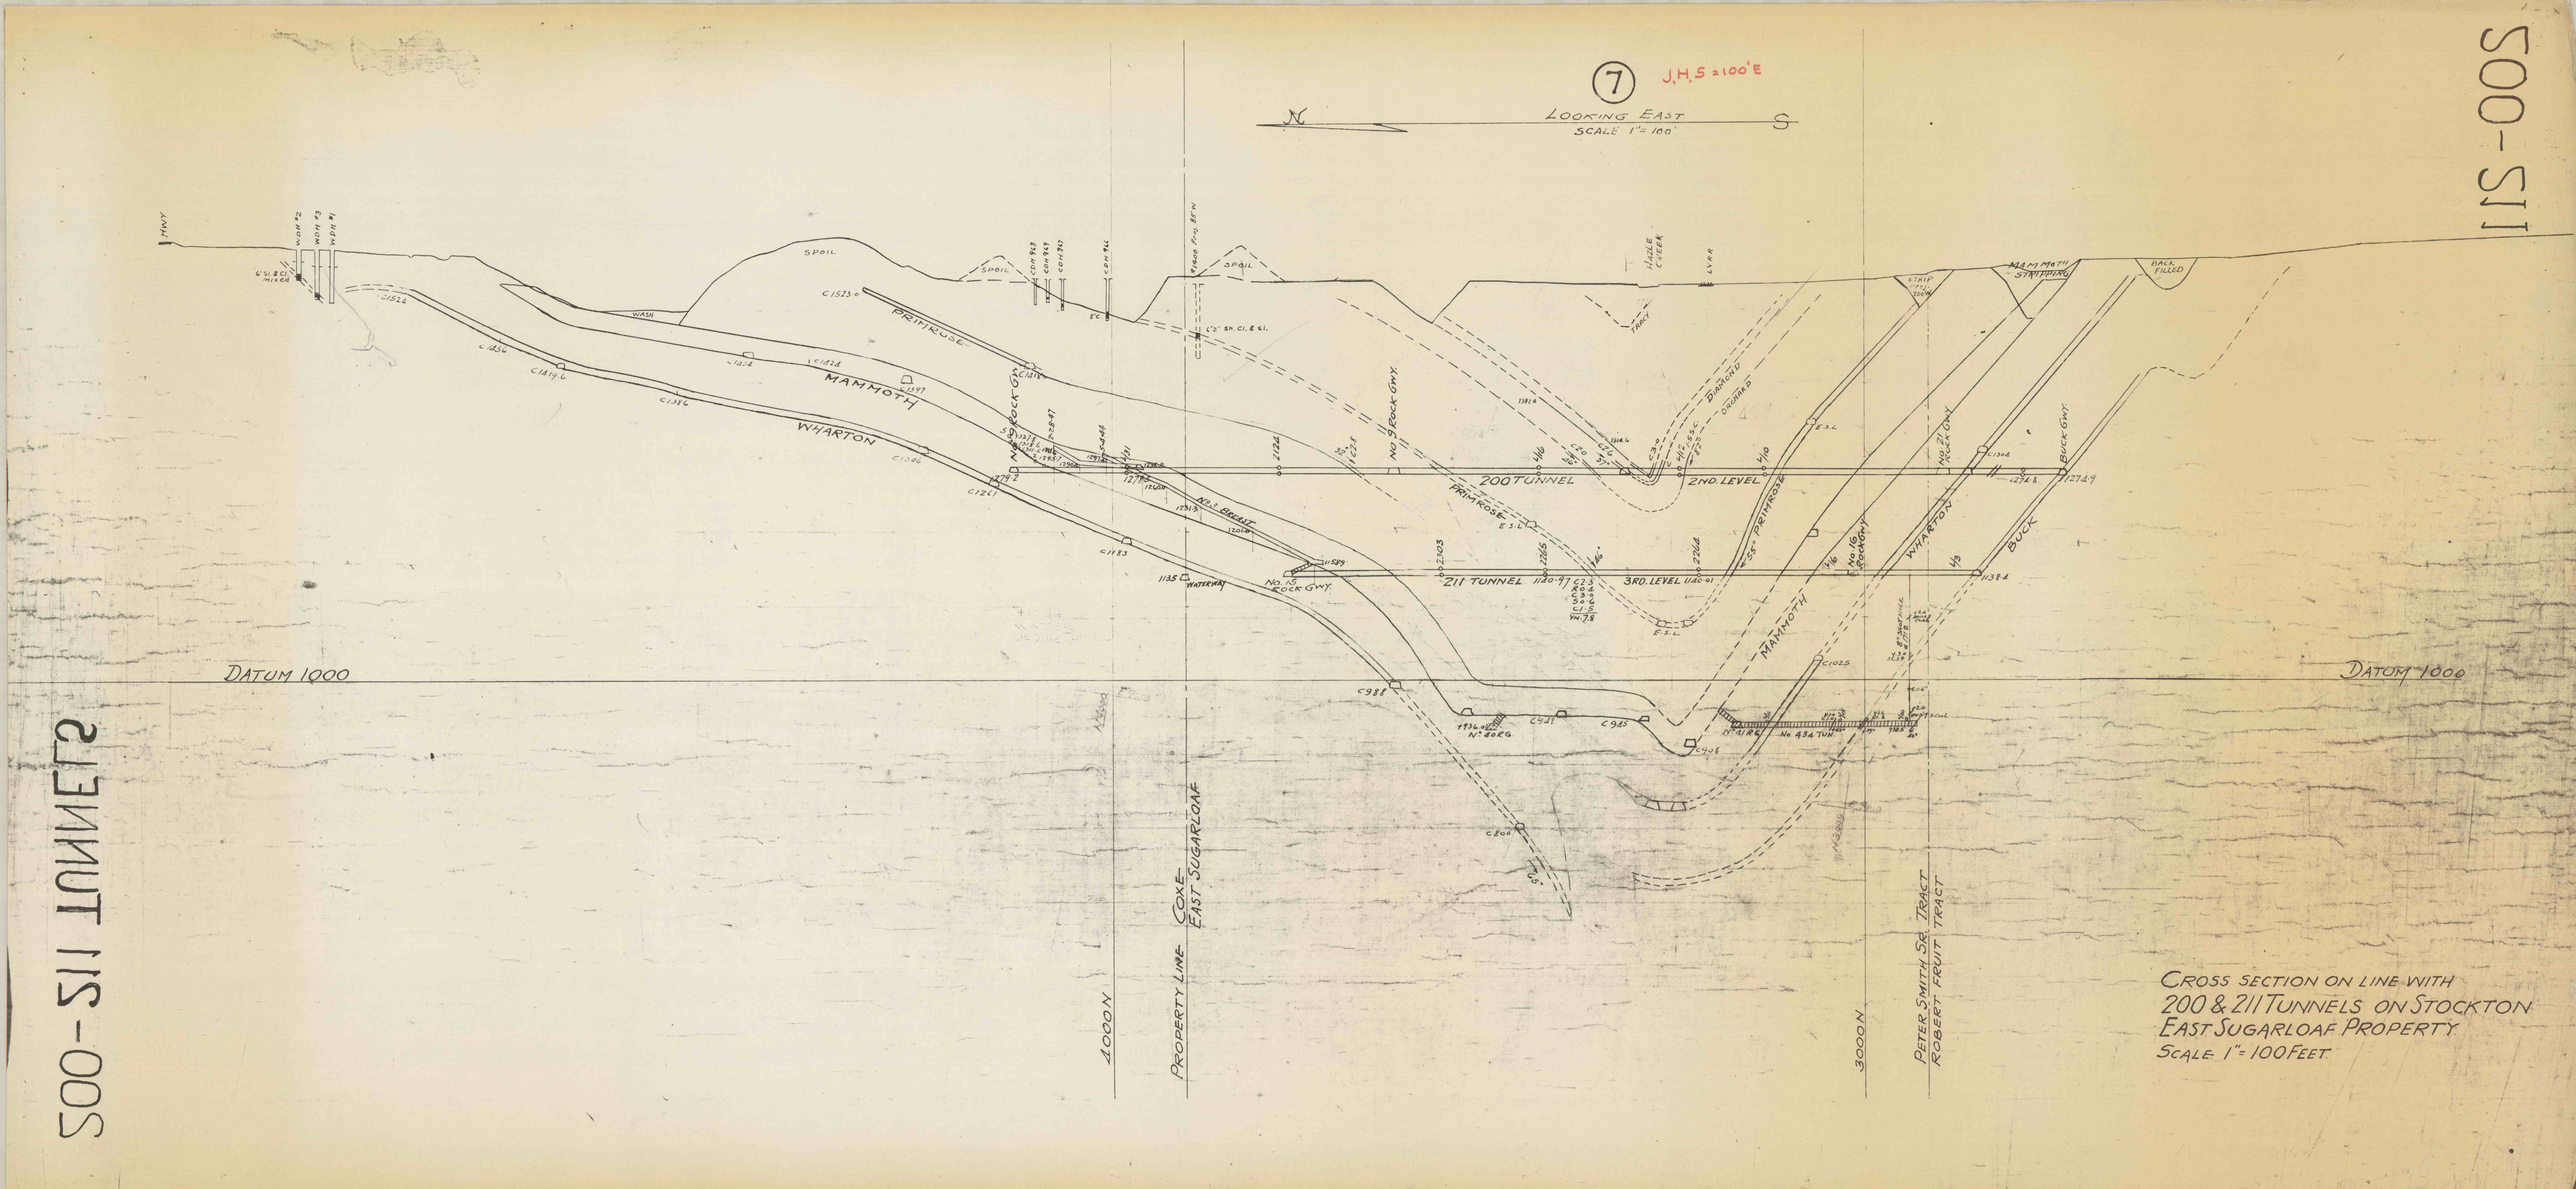

CROSS SECTION ON LINE WITH
200 & 211 TUNNELS ON STOCKTON
EAST SUGARLOAF PROPERTY.
SCALE 1" = 100 FEET