


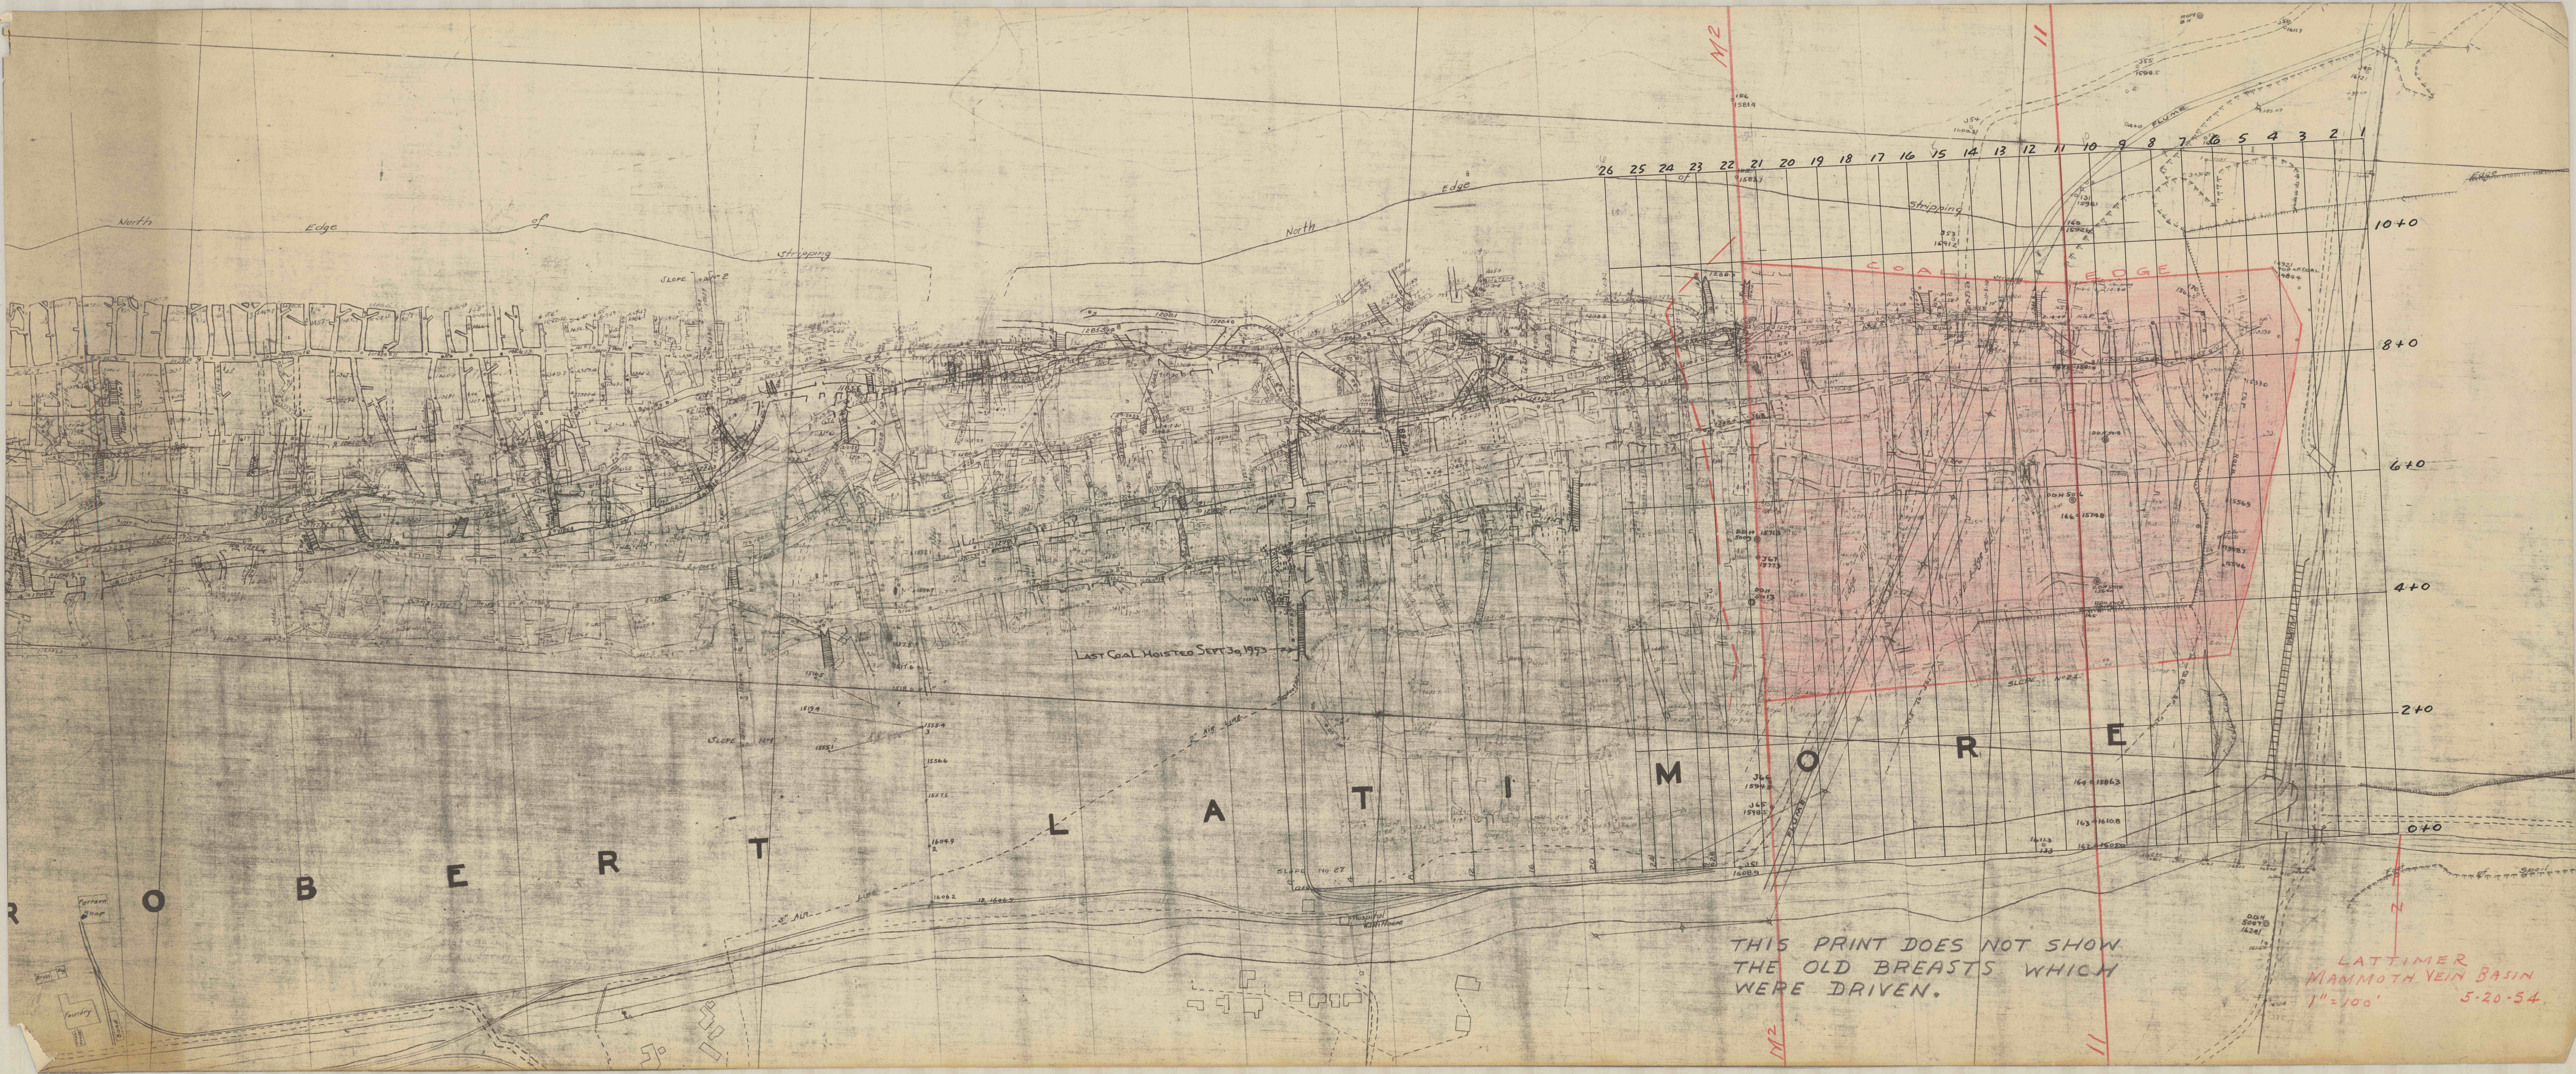

THIS PRINT DOES NOT SHOW
THE OLD BREASTS WHICH
WERE DRIVEN.

LATTIMER
MAMMOTH VEIN BASIN
1"=100'
5-20-54