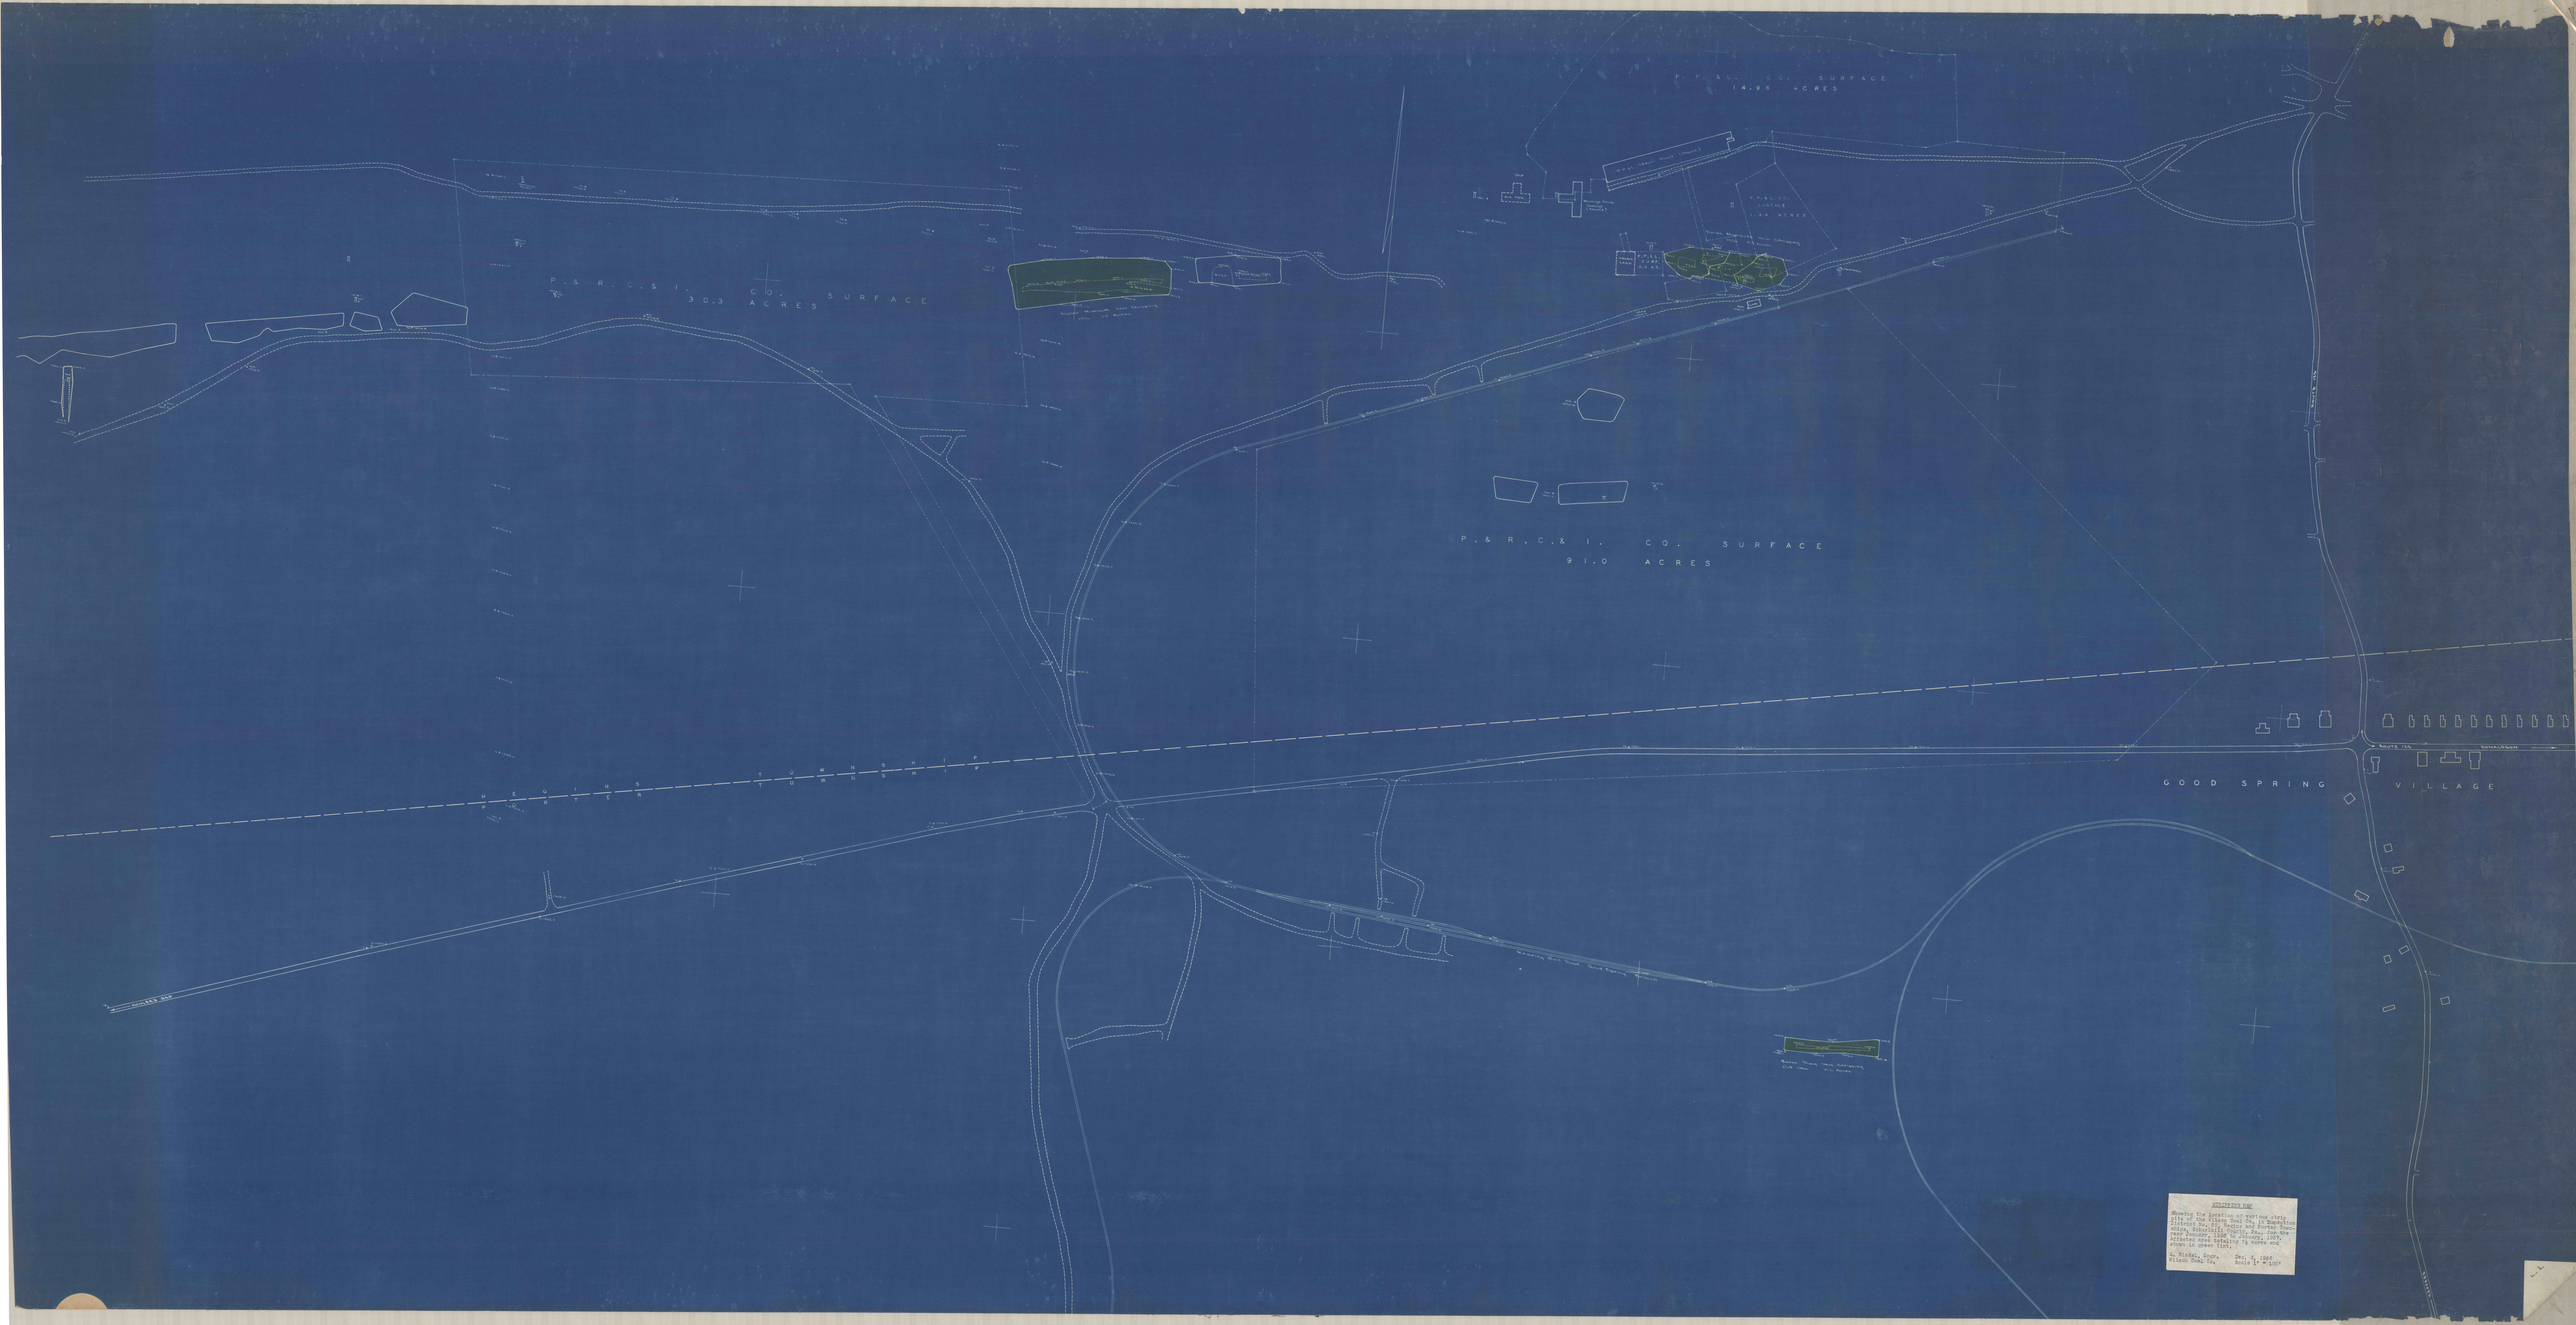
P. P. & L. CO. SURFACE
14.98 ACRES
P. & R. C. & I. CO. SURFACE
30.3 ACRES
P. & R. C. & I. CO. SURFACE
91.0 ACRES
GOOD SPRING VILLAGE
HEGINS TOWNSHIP
SCALE 1" = 100'