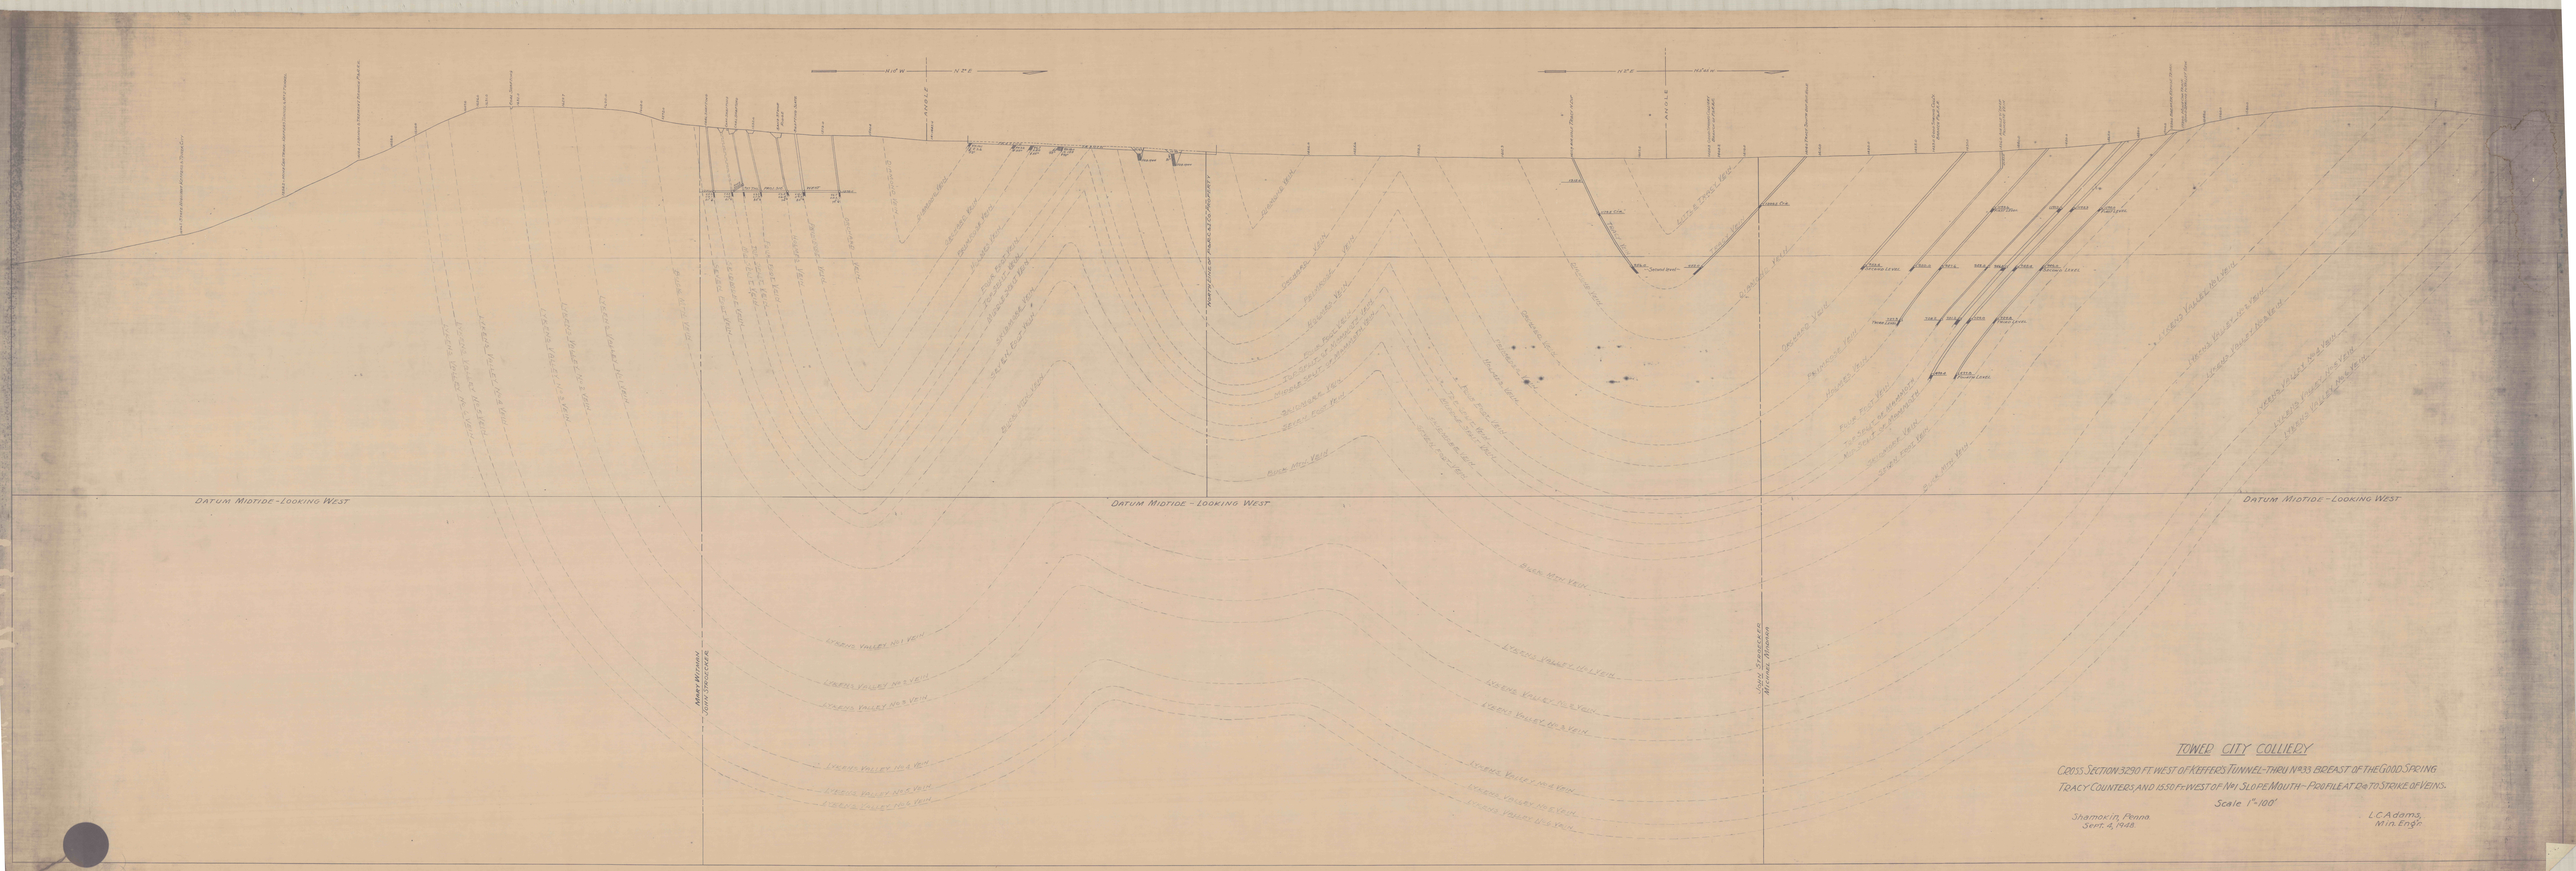
DATUM MIDTIDE - LOOKING WEST
DATUM MIDTIDE - LOOKING WEST
DATUM MIDTIDE - LOOKING WEST
TOWER CITY COLLIERY
CROSS SECTION 3290 FT. WEST OF KEEFERS TUNNEL - THRU No 33 EB EAST OF THE GOOD SPRING
TRACY COUNTERS, AND 1530 FT. WEST OF No 1 SLOPE MOUTH - PROFILE AT DA 70, STRIKE OF VEINS.
Scale 1" = 100'
Shamokin, Penna
Sept. 4, 1948
L.C. Adams,
Min. Eng.