


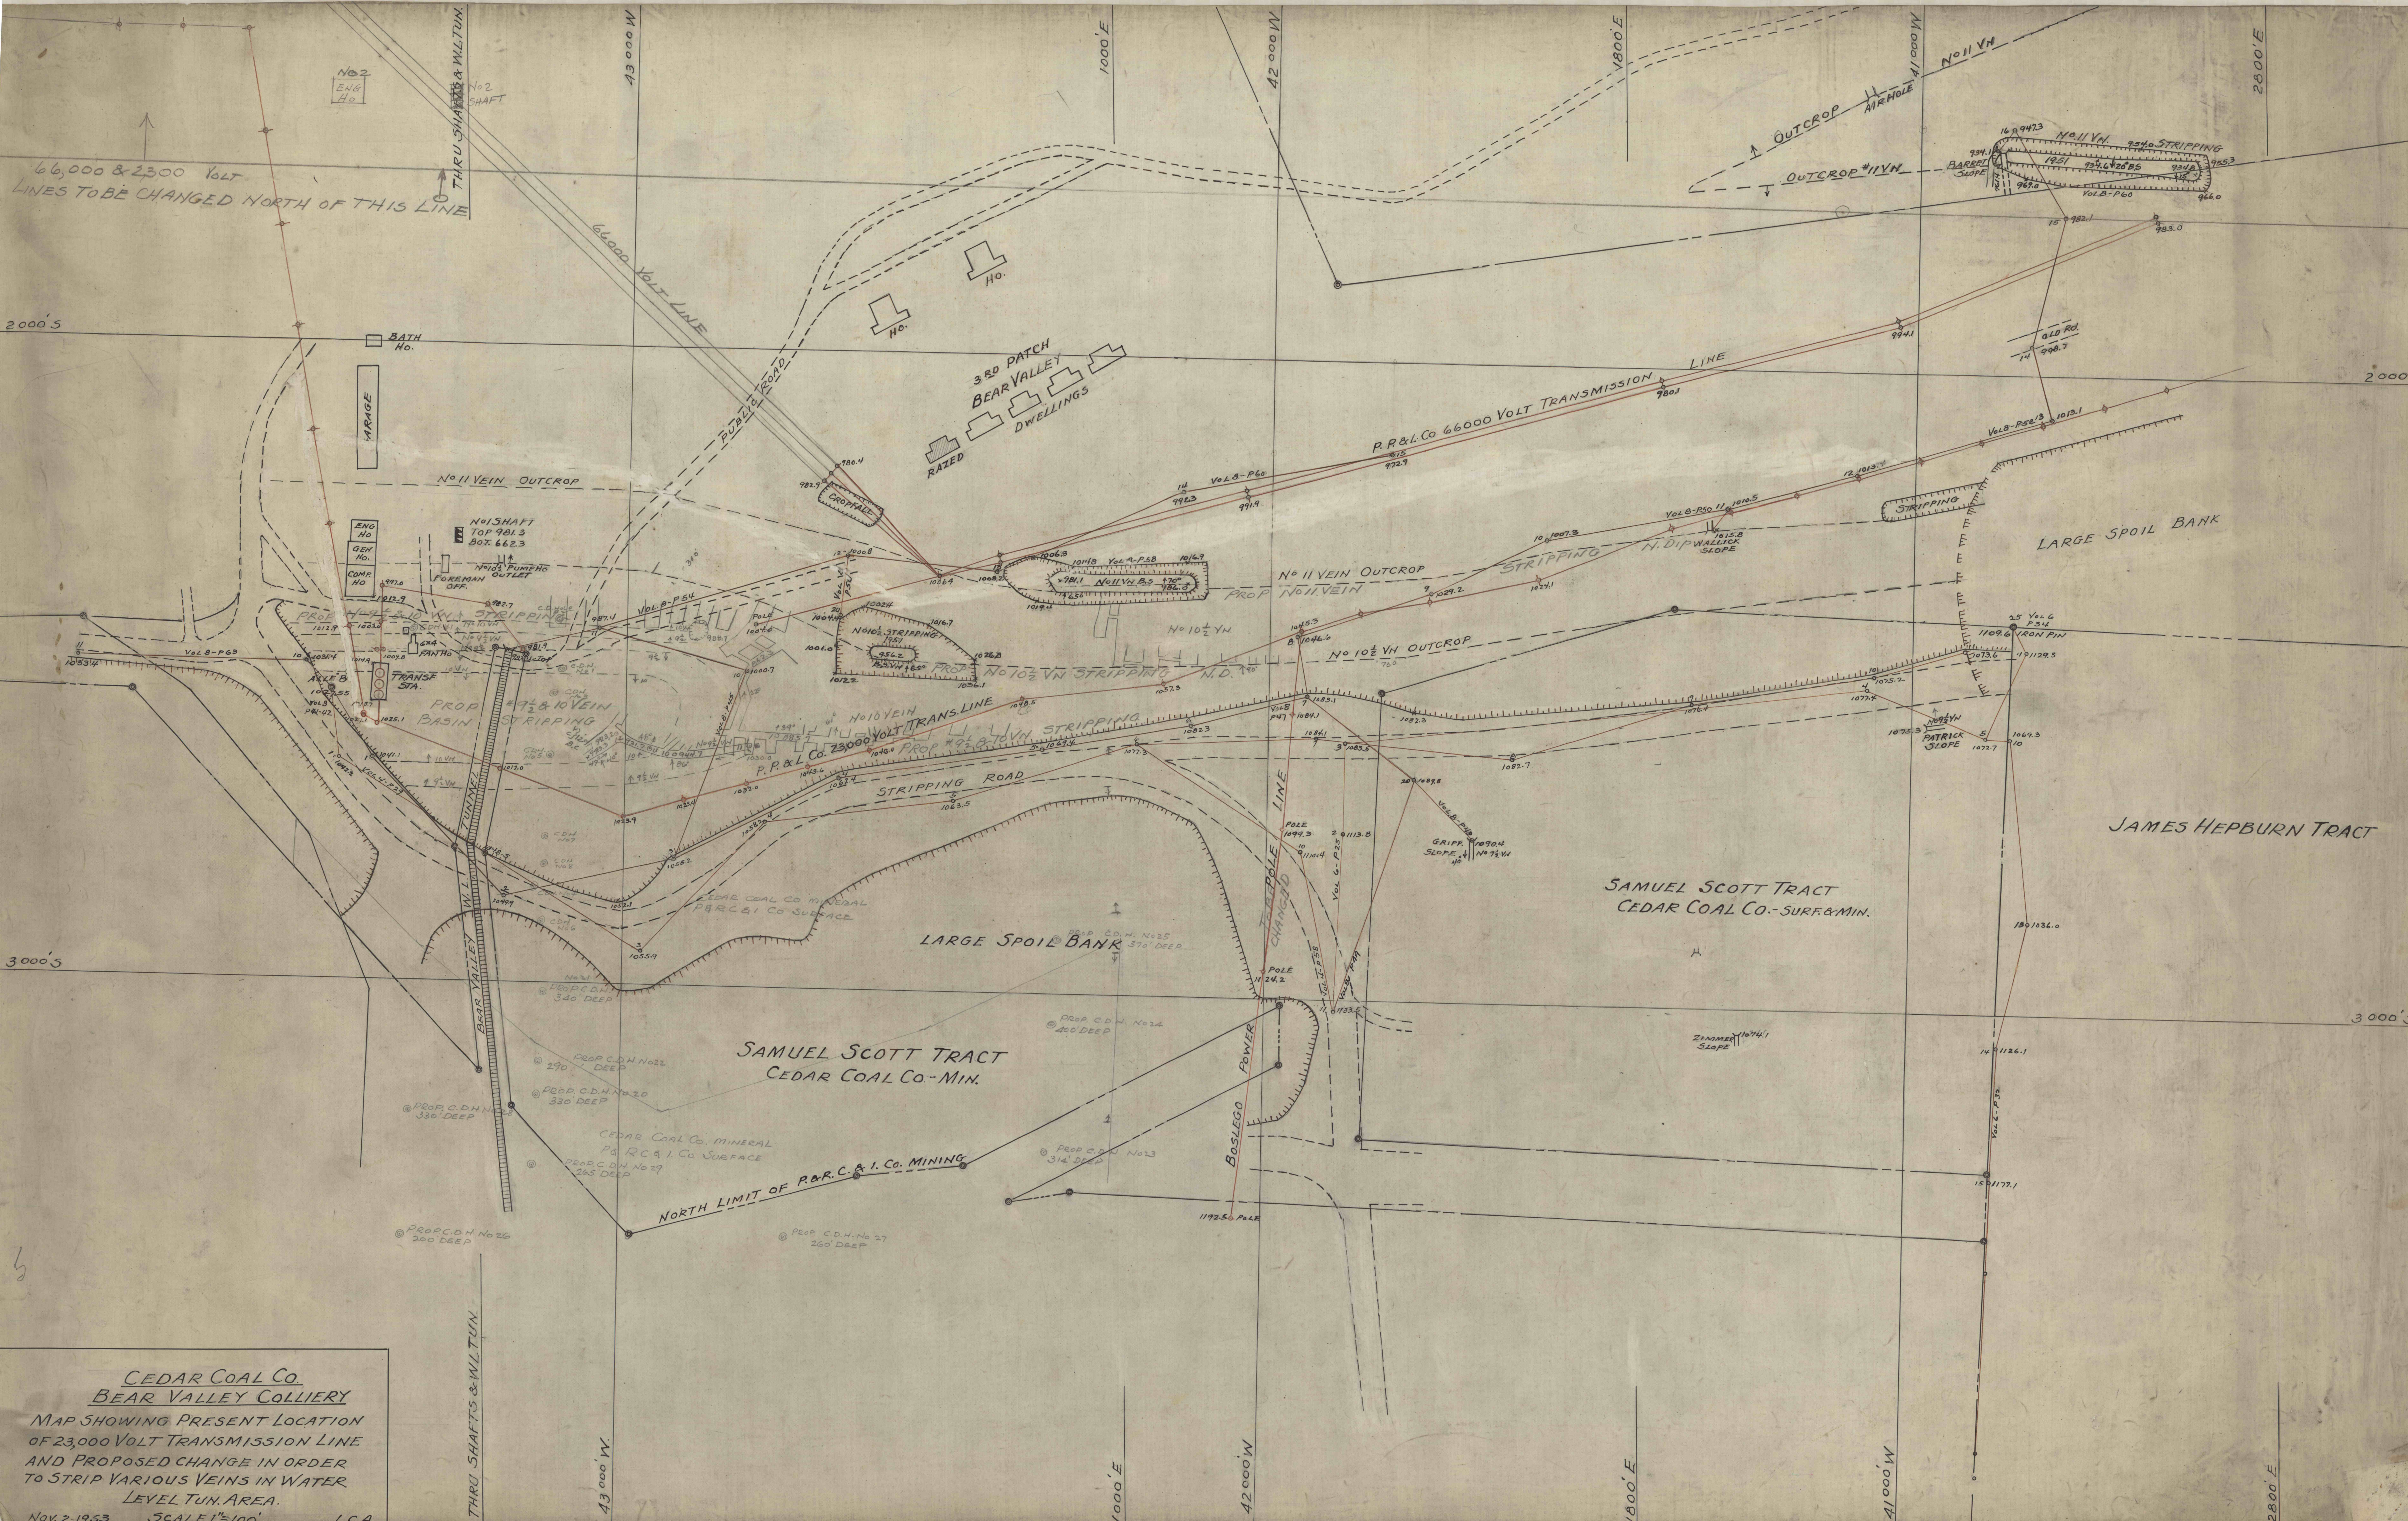

CEDAR COAL CO.
BEAR VALLEY COLLIERY
MAP SHOWING PRESENT LOCATION
OF 23,000 VOLT TRANSMISSION LINE
AND PROPOSED CHANGE IN ORDER
TO STRIP VARIOUS VEINS IN WATER
LEVEL TUN. AREA.
NOV. 2, 1933. SCALE 1"=100' L.C.A.