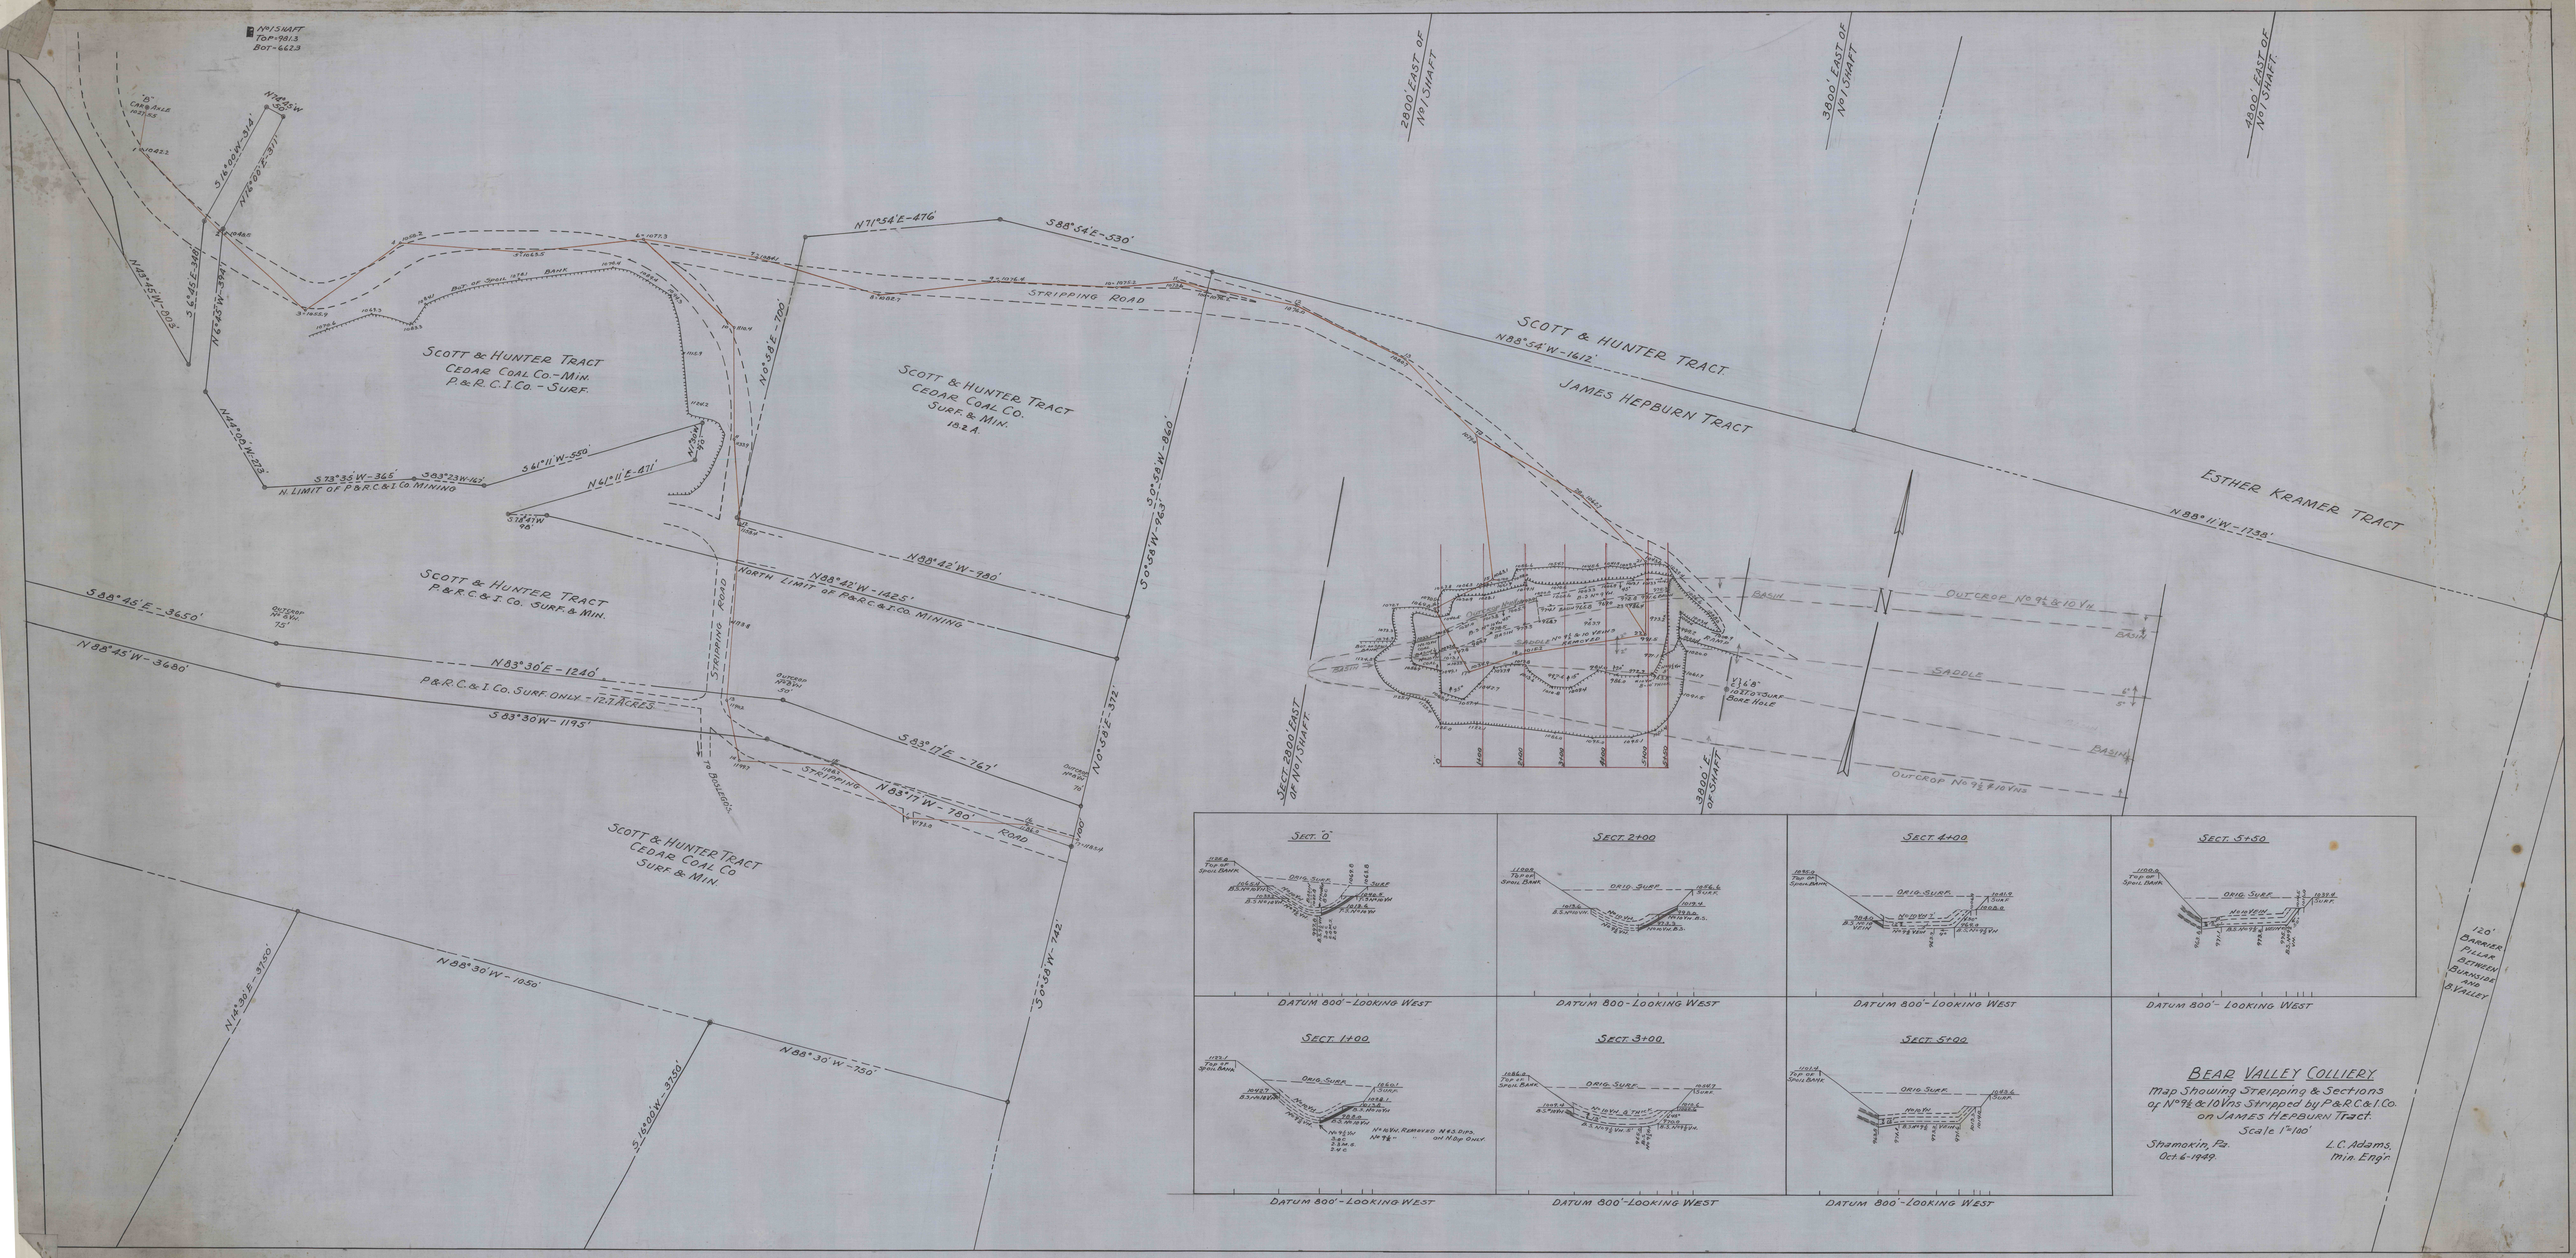

No 1 SHAFT
TOP-981.3
BOT-662.3
2800' EAST OF No 1 SHAFT
3800' EAST OF No 1 SHAFT
4800' EAST OF No 1 SHAFT
SCOTT & HUNTER TRACT
CEDAR COAL CO.-MIN.
P.&R.C.I.CO.-SURF.
SCOTT & HUNTER TRACT
CEDAR COAL CO.
SURF. & MIN.
18.2 A.
SCOTT & HUNTER TRACT
JAMES HEPBURN TRACT
ESTHER KRAMER TRACT
STRIPPING ROAD
N. LIMIT OF P.&R.C.&I.CO. MINING
NORTH LIMIT OF P.&R.C.&I.CO. MINING
SCOTT & HUNTER TRACT
P.&R.C.&I.CO. SURF. & MIN.
P.&R.C.&I.CO. SURF. ONLY - 12.7 ACRES
SCOTT & HUNTER TRACT
CEDAR COAL CO
SURF. & MIN.
N71°54'E-476'
S88°54'E-530'
N88°54'W-1612'
N88°11'W-1738'
N88°42'W-980'
N88°42'W-1425'
S88°45'E-3650'
N88°45'W-3680'
N83°30'E-1240'
S83°30'W-1195'
S83°17'E-767'
N83°17'W-780'
N88°30'W-1050'
N88°30'W-750'
S16°00'W-3750'
N14°30'E-3750'
S0°58'W-860'
S0°58'W-963'
N0°58'E-372'
S0°58'W-742'
N0°58'E-700'
OUTCROP No 9½ & 10 VN
BASIN
SADDLE
OUTCROP No 9½ & 10 VNS
SECT. 2800' EAST OF No 1 SHAFT
3800' E. OF SHAFT
SECT. "0"
SECT. 2+00
SECT. 4+00
SECT. 5+50
SECT. 1+00
SECT. 3+00
SECT. 5+00
DATUM 800'-LOOKING WEST
120' BARRIER PILLAR BETWEEN BURNSIDE AND B. VALLEY
BEAR VALLEY COLLIERY
Map Showing Stripping & Sections of No 9½ & 10 Vns Stripped by P.&R.C.&I.Co. on JAMES HEPBURN Tract.
Scale 1"=100'
Shamokin, Pa.
Oct. 6-1949.
L.C. Adams,
Min. Engr.