


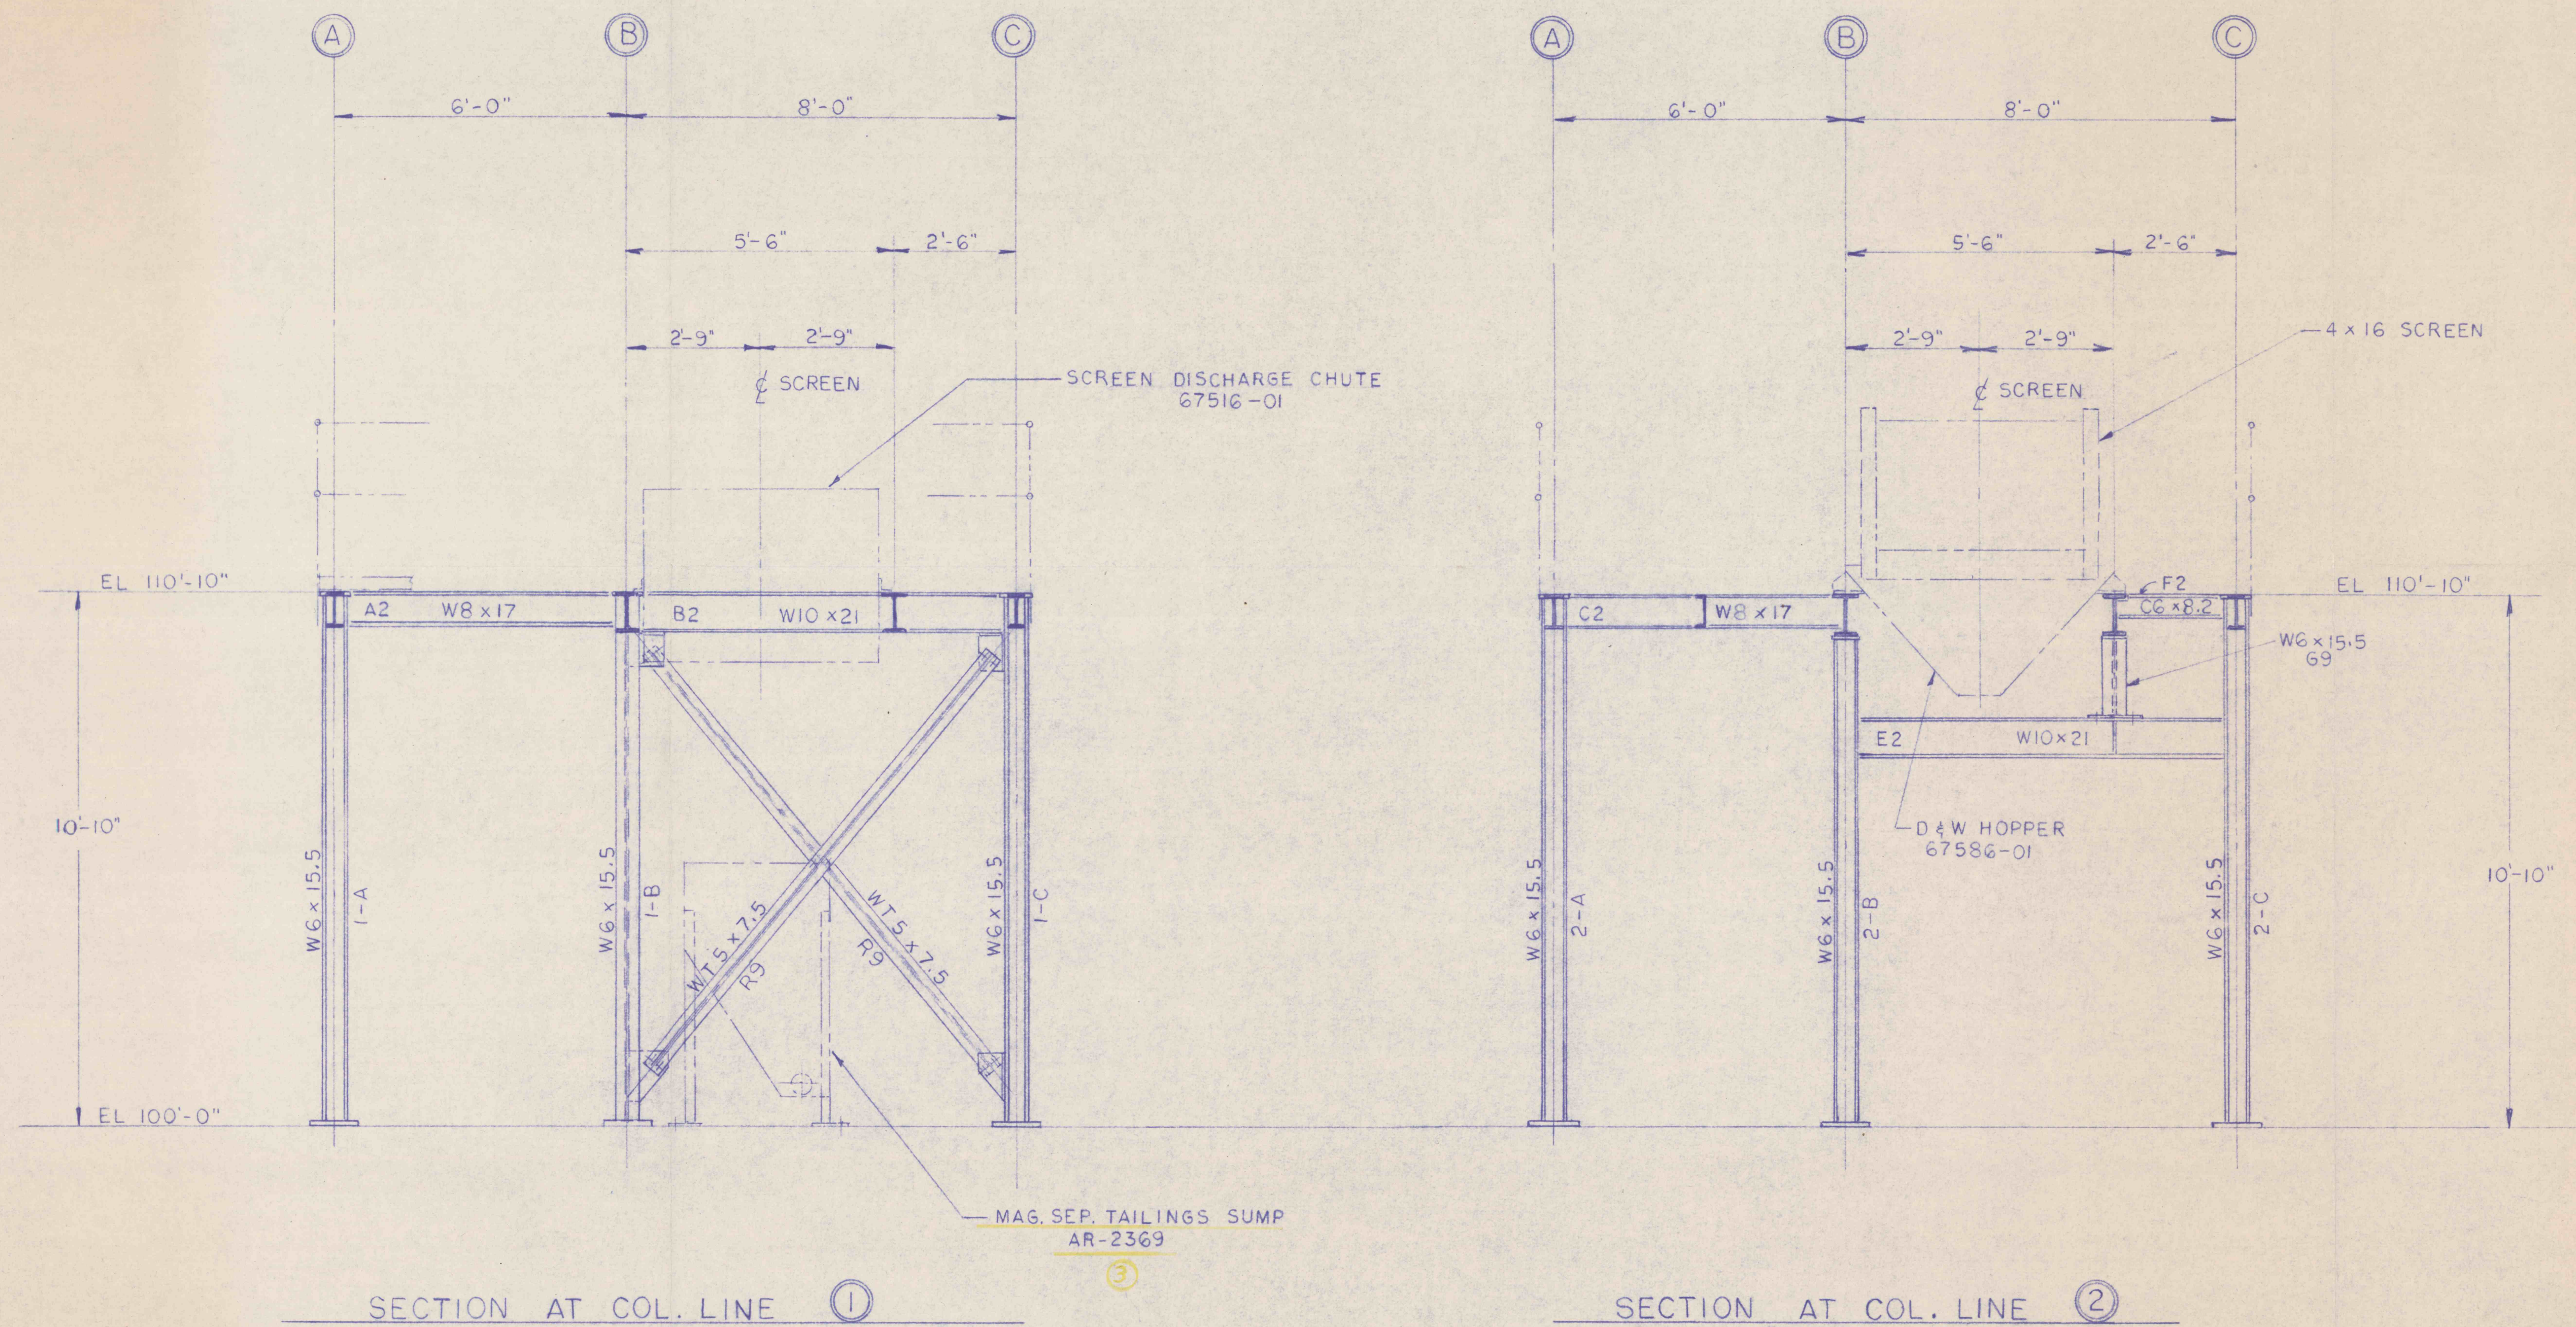

NOTE:
FOR LIST OF REF. DWGS AND NOTES SEE DWG 67482

REV NO.	DESCRIPTION	EDRN NO.	DATE	BY	CHK'D	APPR.	NEXT ASSY.
41672	UNLESS OTHERWISE SPECIFIED: DIMENSIONS ARE IN INCHES. TOLERANCE: .XX ± .02 .XXX ± .010 FRACTIONS ± ANGLE ± SURF FINISH ✓ RMS						
DRAWN G.O. 3-5-80 CHECK DATE PROJ. ENGR. DATE APPROVAL DATE RELEASE DATE		WEMCO HMS MOBIL MILL SECTION @ COL LINE ① & ② DWG. NO. 67486		SCALE 1/2" = 1'-0" SHT 1 OF 1 D		SACRAMENTO CALIF.	