



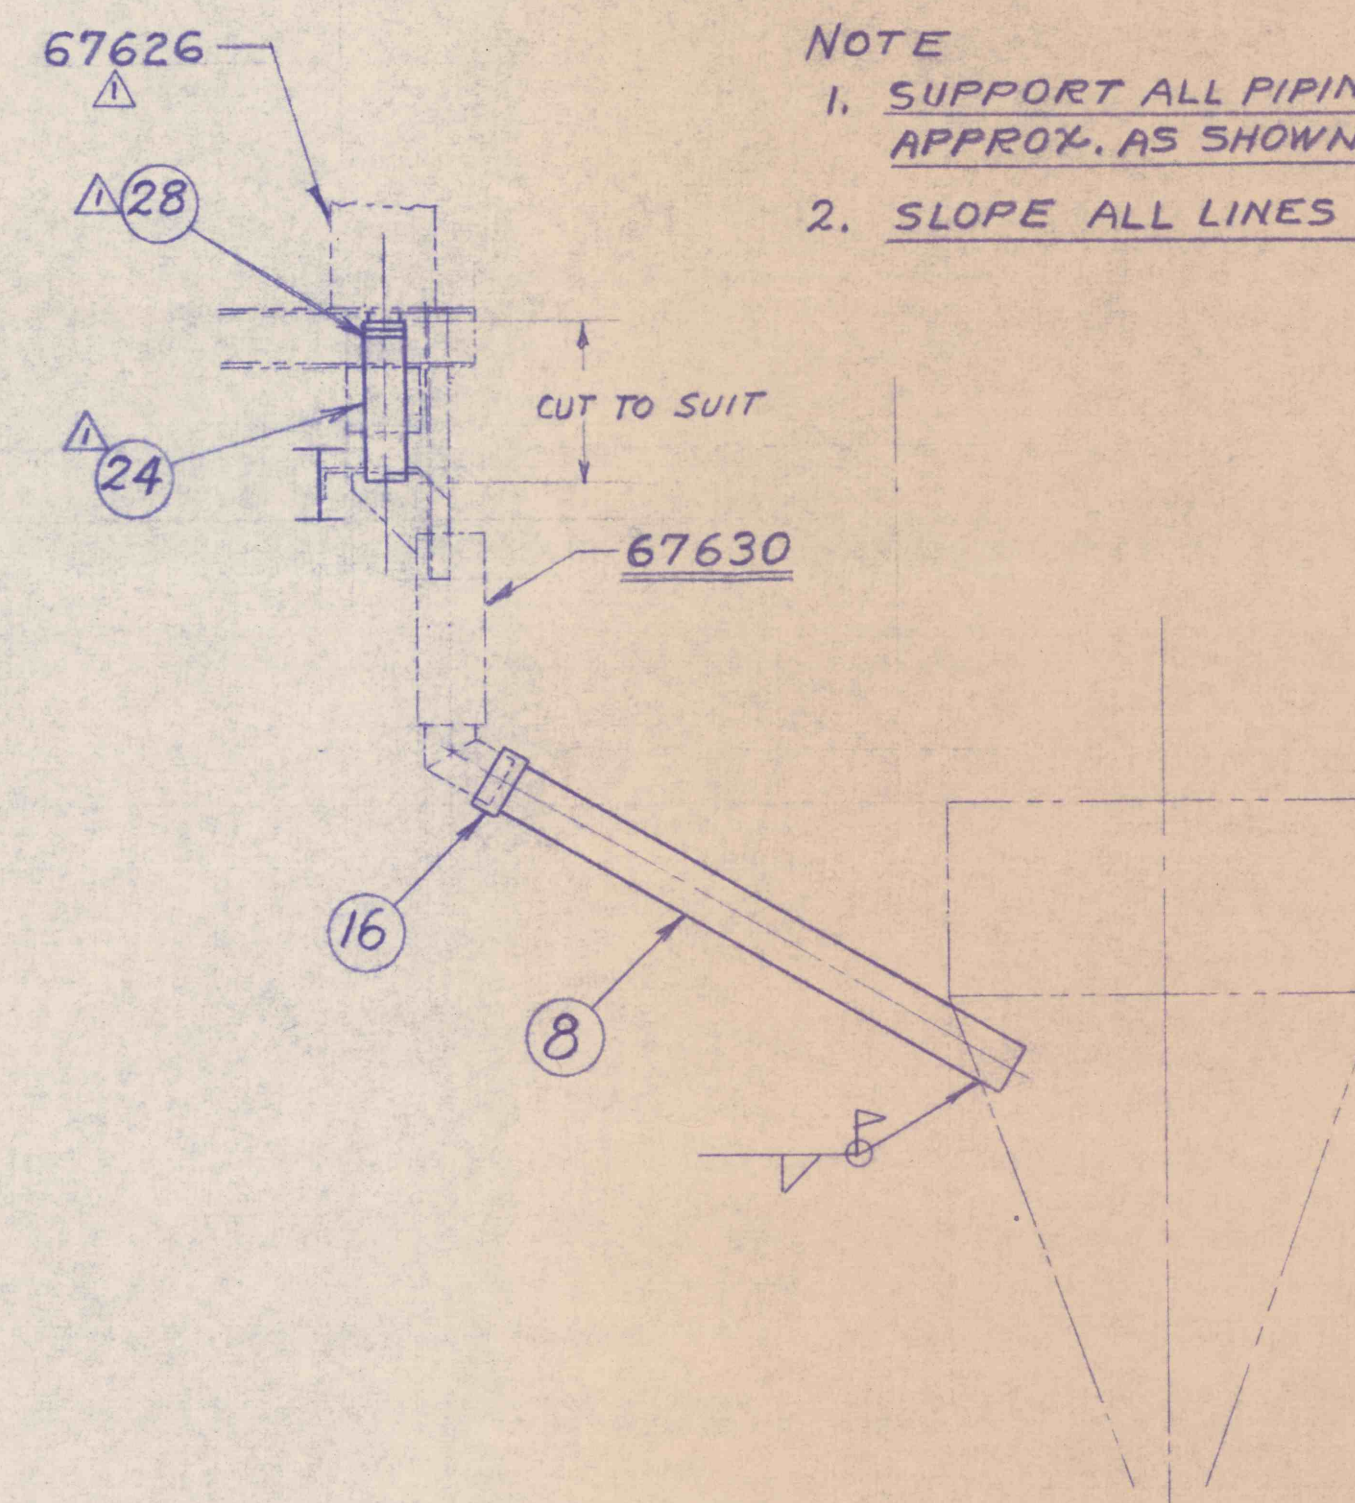

QTY.	REQ'D	ASSY.	ITEM NO.	PART NO.	DESCRIPTION	RAW PART NO.	MATERIAL	UNIT WT.
			-01					
			1	1	67632-04	SUPPORT, WELDMENT	STL	
			2	2	67633-11	SUPPORT	↑	
			1	3	67633-12	SUPPORT		
			1	4	67633-18	SUPPORT		
			1	5	67635-5	PIPE, SCH. 40 6"x15" SEE DETAIL		
			1	6	67678-07	PIPE, WELDMENT	↓	
			1	7	67678-08	PIPE, WELDMENT	STL	
			2	8	67635-8	PIPE, SCH. 40 6"x6.0" P.B.E.	A120	
			1	9	↑ -9	6 x 52" P.B.E.	↑	
			1	10	-10	4 x 6.6" P.B.E.		
			1	11	-11	3 x 7.9" P.O.E.&T.O.E.		
			1	12	-12	3 x 39" P.O.E.&T.O.E.		
			1	13	↓ -13	3 x 32" T.B.E.	↓	
			2	14	67635-14	PIPE, SCH. 40 3 x 10" P.O.E.&T.O.E.	A120	
			4	15	148645	COUPLING 3 VIC. STYLE 90	M.I.	
			5	16	148731	COUPLING, 6 VIC. STYLE 90	M.I.	
			1	17	148672	COUPLING, 4 VIC. STYLE 90	M.I.	
			8	18	115102	CLAMP, HOSE, KING # 400 3 1/2 to 4		
			1	19	130251	HOSE, WATER 3 1/2 ID x 4 1/16 x 48	RUBB	
			3	20	209824	U-BOLT 1/2 x 3	STL	
			1	21	209829	U-BOLT 1/2 x 4	↑	
			2	22	209830	U-BOLT 5/8 x 6	STL	
				23				
△			1	24	130257	HOSE, SOFT RUBBER 4 1/2 I.D. x 5 O.D. x 24" CUT TO SUIT	RUBB	
				25				
△			2	26	148788	ELBOW, 90° S.R., 3" VIC. STYLE 90	M.I.	
				27				
△			1	28	115112	CLAMP, HOSE IDEAL # 6896	5 ST	

NOTE

1. SUPPORT ALL PIPING SECURELY. LOCATE SUPPORTS APPROX. AS SHOWN. SUPPORTS MAY BE TRIMMED.
2. SLOPE ALL LINES $\frac{1}{8}$ " PER FT. MIN. FOR DRAINAGE.

MIC	 ADDED ITEMS 24	28 5 P/N 40	67626	28134	3/23/80	DK	105						
	REV NO	DESCRIPTION			EDRN NO.	DATE	BY	CHK'D	APPR.	NEXT ASSY.			
	5.041672			This drawing is the confidential property of ENVIROTECH CORPORATION and is loaned upon the express understanding and agreement that it is not to be reproduced or copied, in whole or in part, or used for furnishing information to others, or used directly or indirectly in any way detrimental to the interests of ENVIROTECH CORPORATION, and is to be returned upon request. All rights reserved.									
UNLESS OTHERWISE SPECIFIED: DIMENSIONS ARE IN INCHES. TOLERANCE:						WEMCO, DIVISION OF ENVIROTECH CORPORATION		SACRAMENTO CALIF.					
XX ± .02 XXX ± .010 FRACTIONS ± ANGLE ± SURF FINISH — — — — — ✓ RMS				DRAWN KERR DATE 4-16-80		CHECKED B DATE 4-23-80		PROJ. ENGR. AS DATE 4-23-80		APPROVAL AS DATE 4-23-80		RELEASE DATE	
				PIPING MISC. WEMCO HMS		SCALE NONE		D					
				SHT 1 OF 1		DWG. NO. 67635		L					