


67321

| ITEM | REQ'D | PART NO. | DESCRIPTION | MAT'L | WT. |
|------|-------|----------|-------------|-------|-----|
|      |       |          |             |       |     |

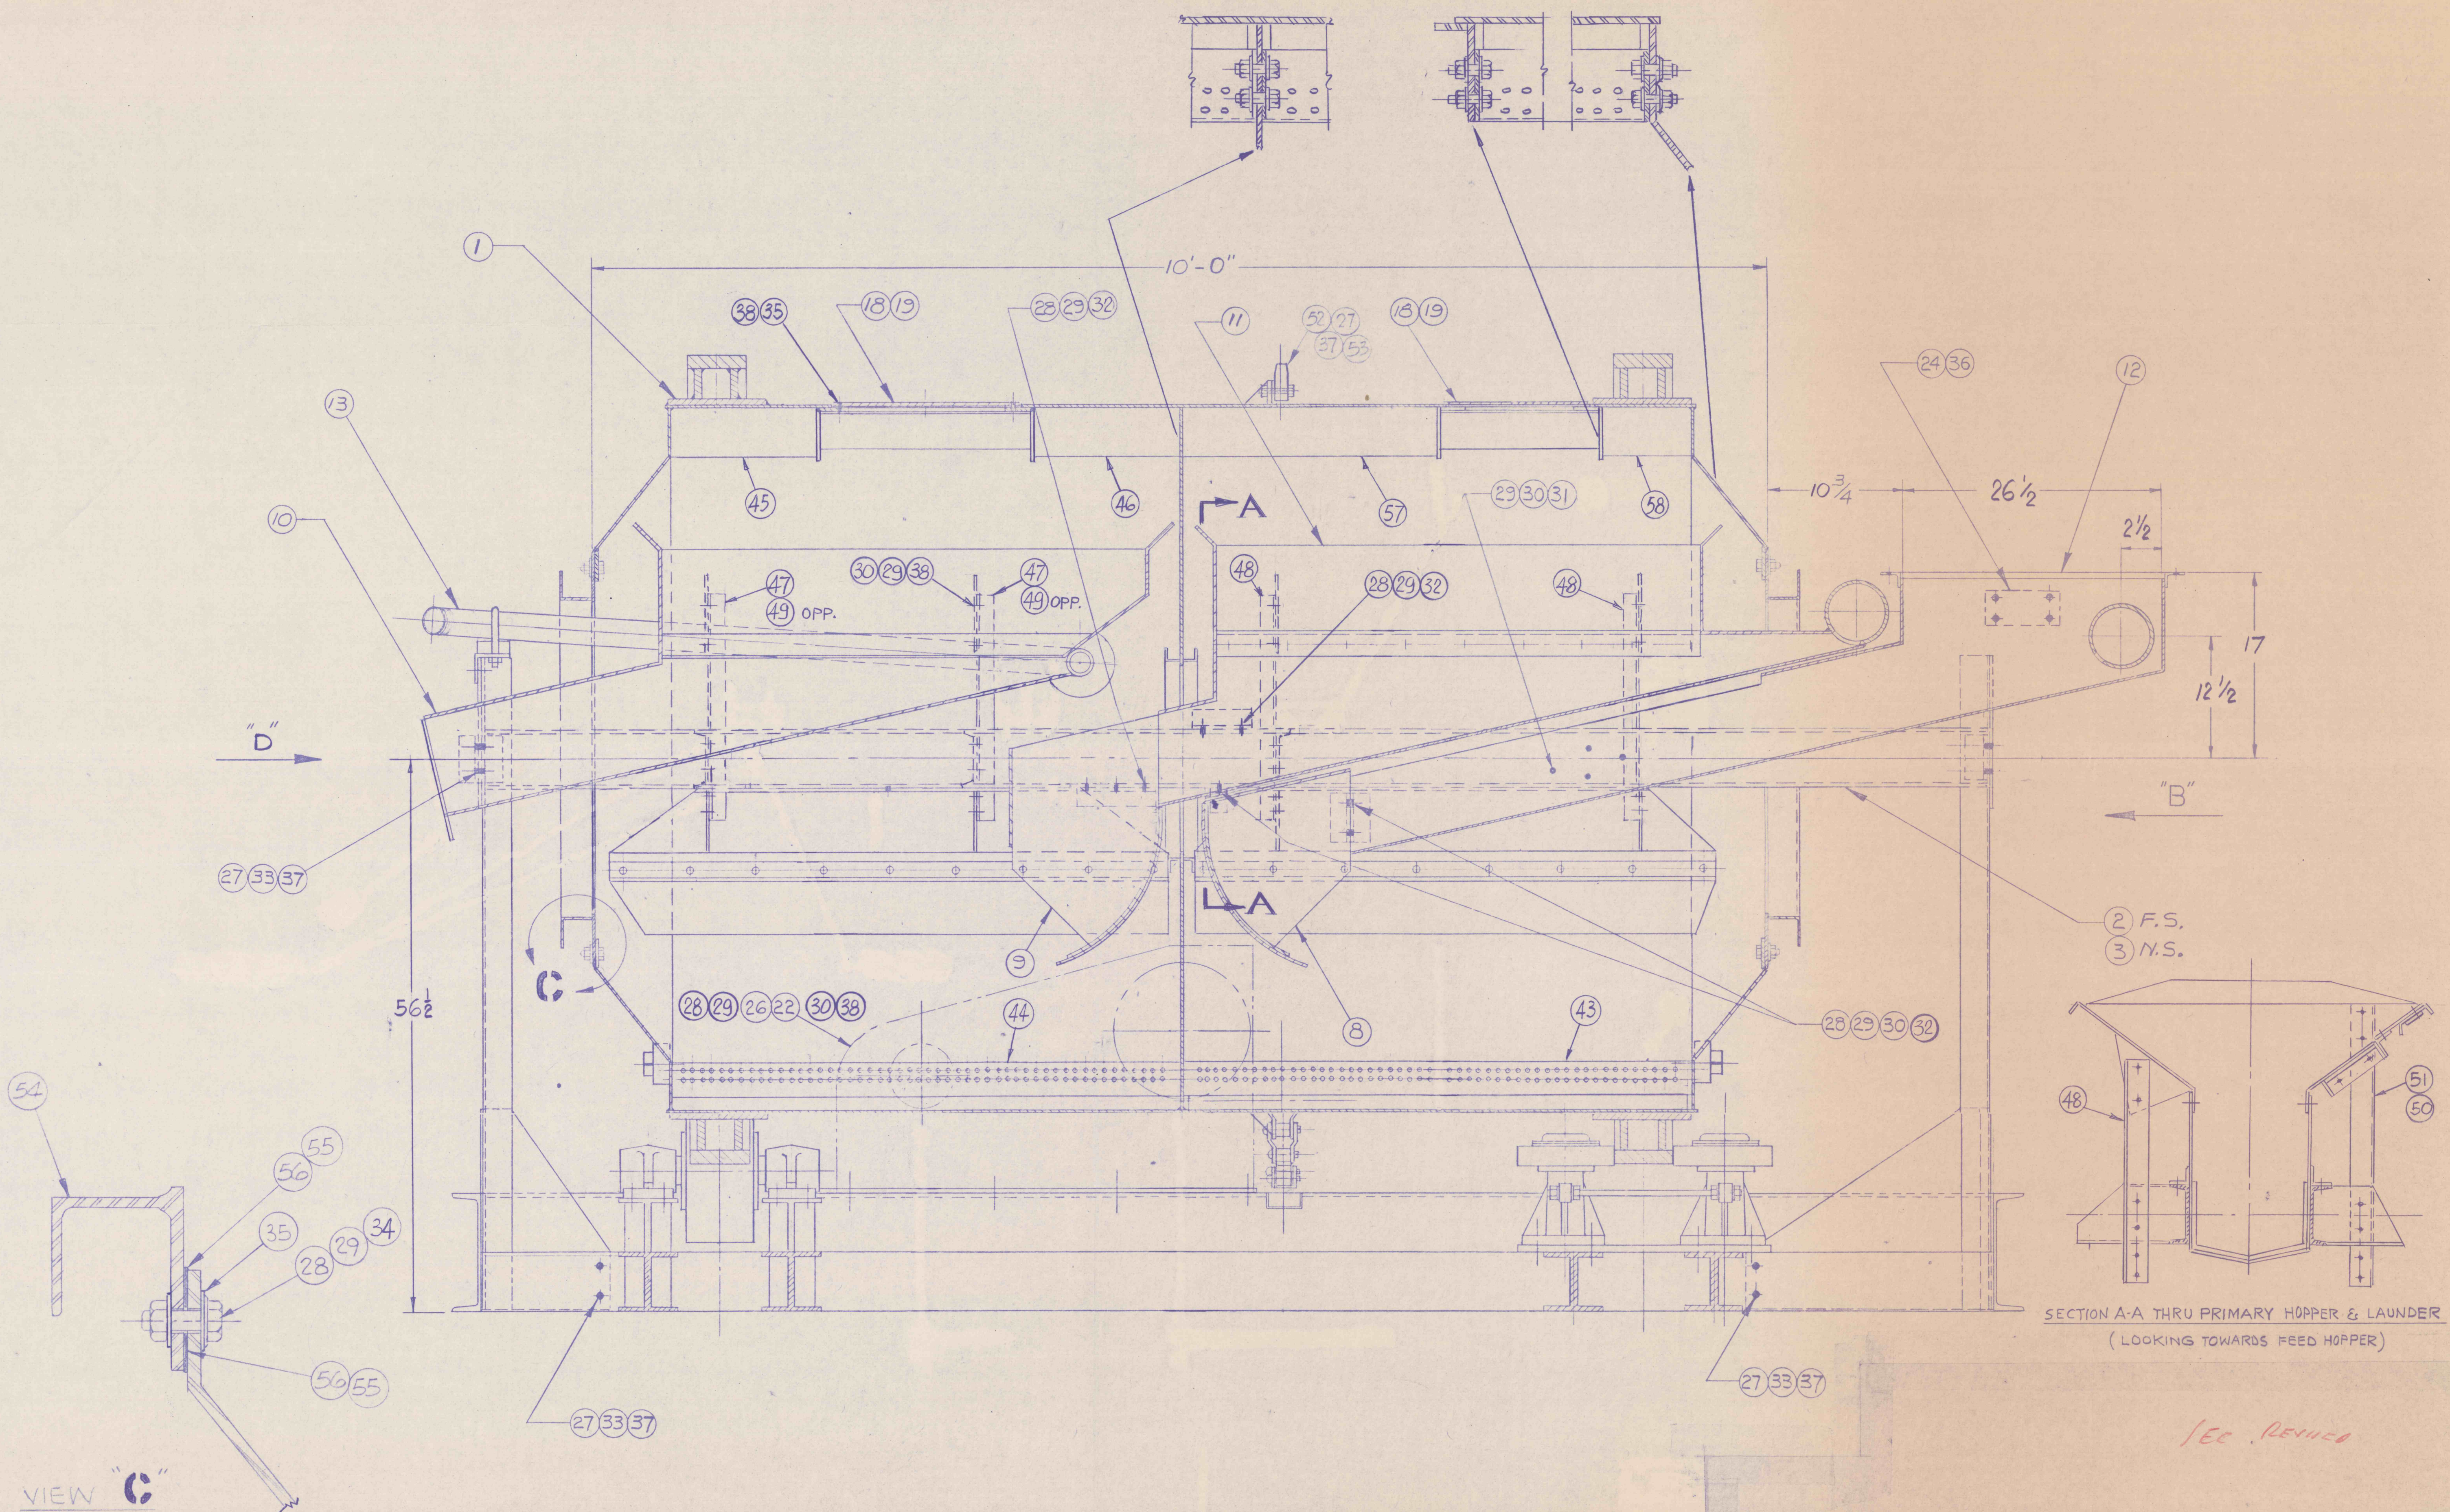

SECTION A-A THRU PRIMARY HOPPER & LAUNDER  
(LOOKING TOWARDS FEED HOPPER)

JEC. REVISED