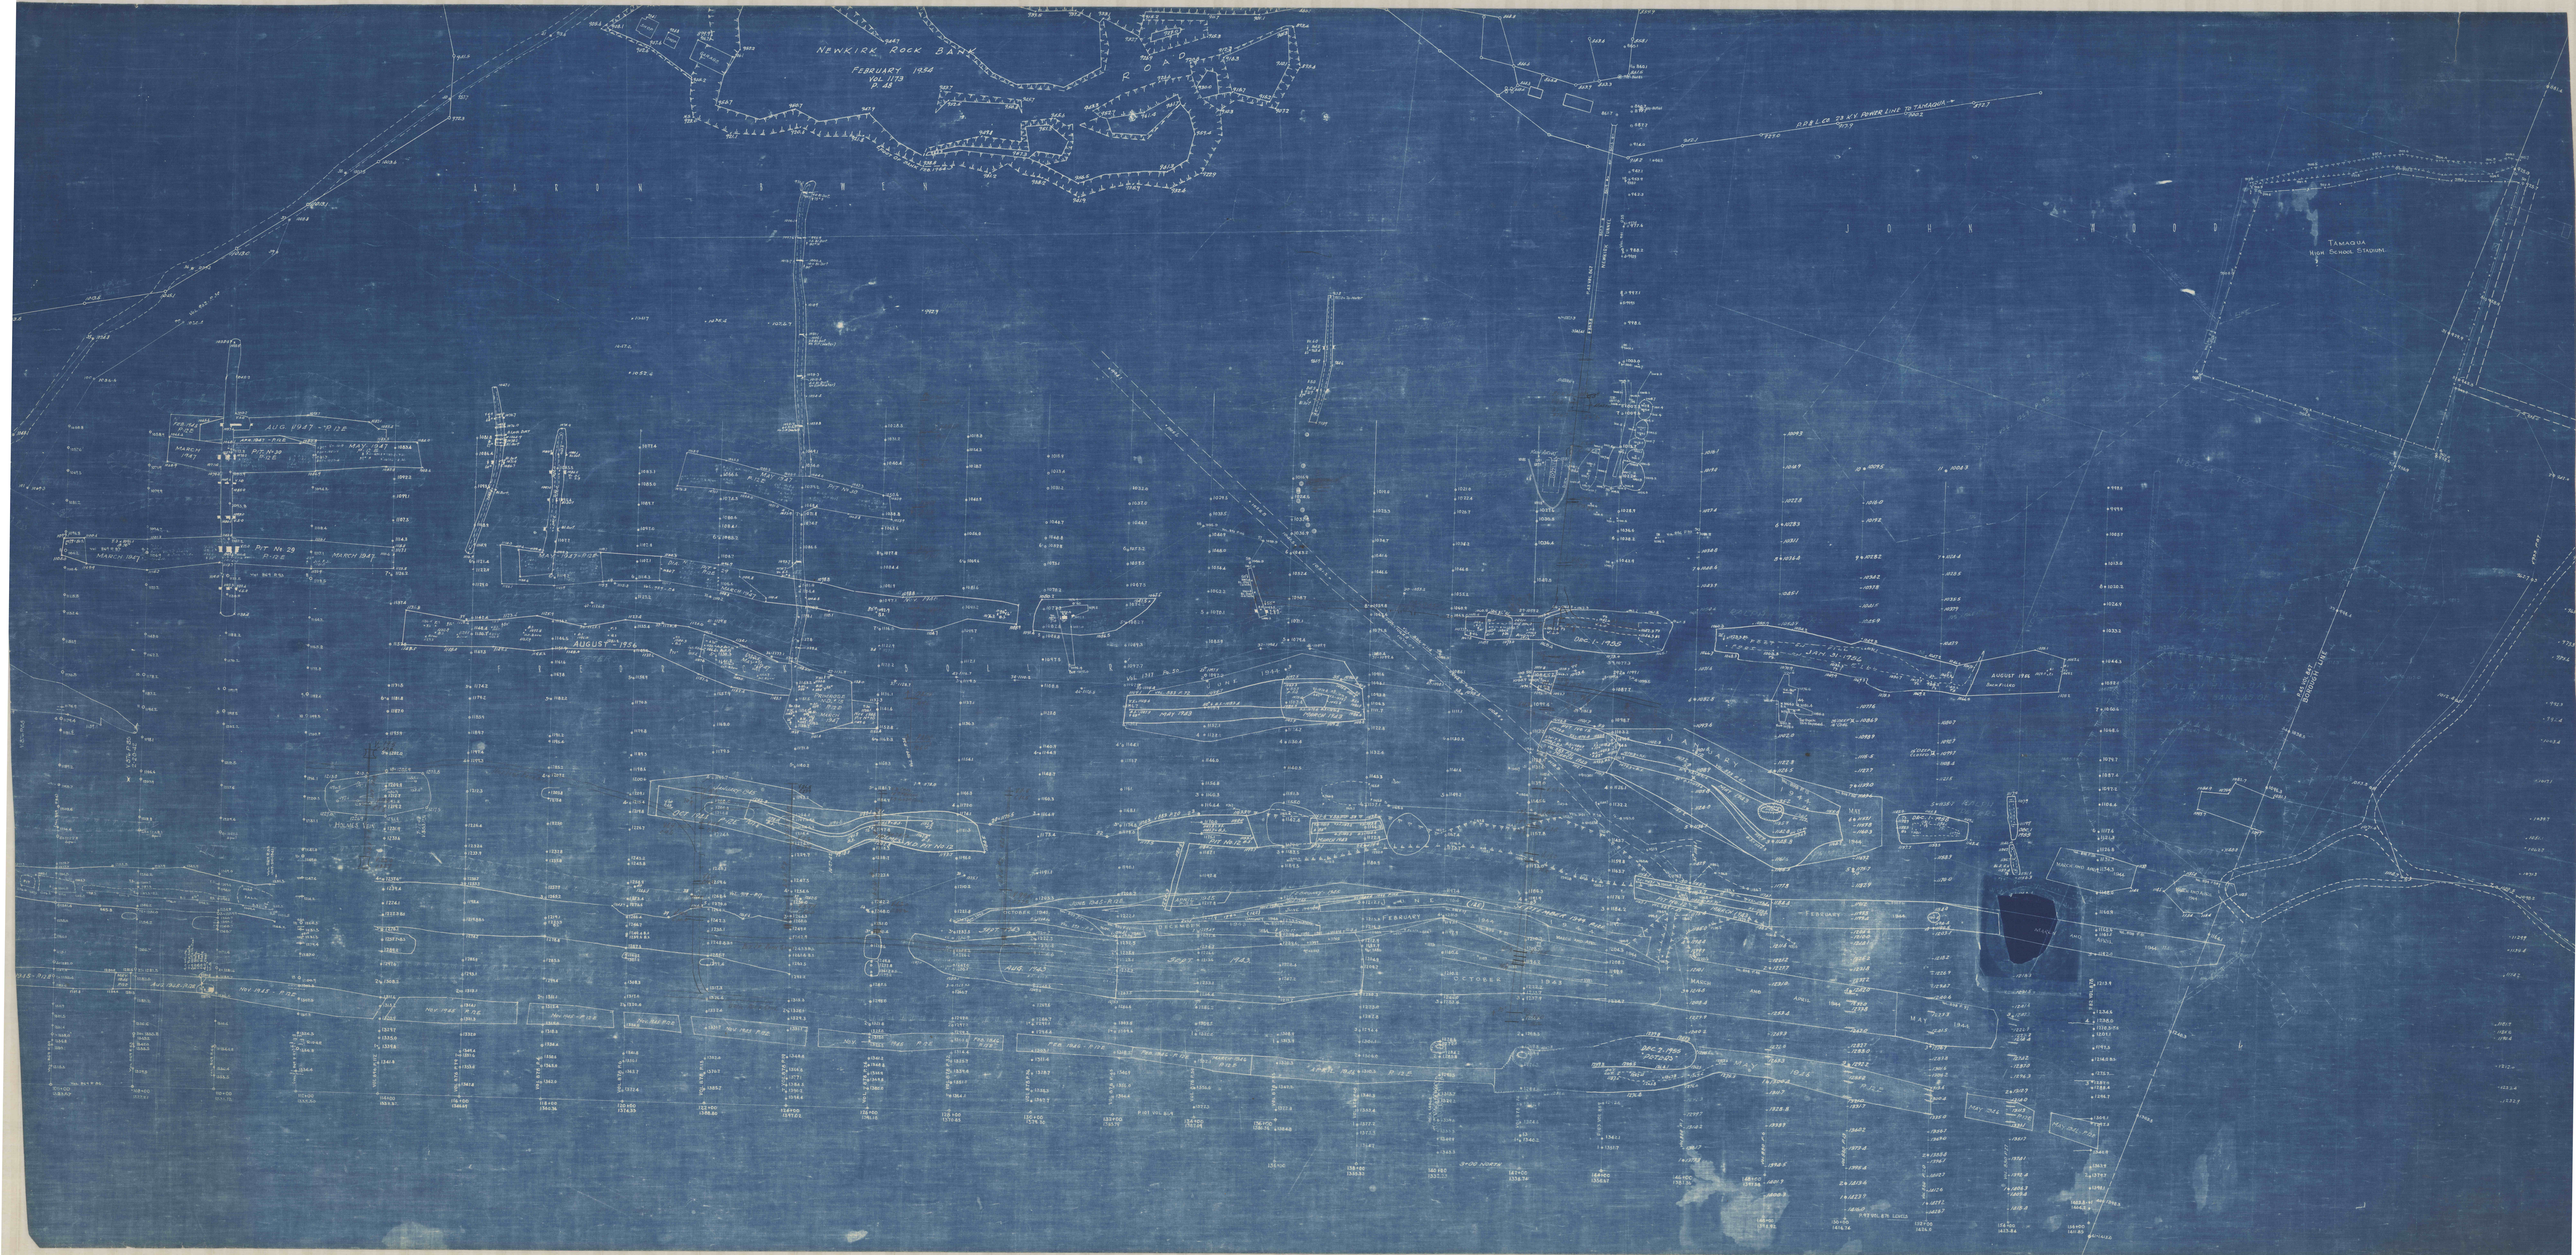

NEWKIRK ROCK BANK
FEBRUARY 1954
VOL 1173
P. 48
ROAD
FOOT OF BANK FEB. 1954
SHOP
SHOP
GARAGE
A A R O N B O W E N
J O H N W O O D
P.P.& L. CO. 23 K.V. POWER LINE TO TAMAQUA →
TAMAQUA
HIGH SCHOOL STADIUM.
NEWKIRK TUNNEL
P.43 VOL. 867
MAIN AIRWAY
F R E D R I C K B O L L E R
RALPH PETERS
FEB. 1948 P-12E
AUG. 1947 - P.12E
APR. 1947 - P.12E
MARCH 1947
PIT. No 30 P-12E
MAY 1947 P.12E
PIT No. 29 P.-12E
MARCH 1947
MAY - 1947 - P12E
DIA. N.D. PIT 29 P.12E
MARCH 1947
MAY 1947 P.12E
PIT No 30
AUGUST - 1956
MAY 1947
PRIMROSE N.D. #15 P.12E MARCH 1947
Nov 1948 Pit N° 20
NOV. 1948
HOLMES VEIN
JANUARY 1945
OCT 1944 P-12E
HOLMES N.D. PIT NO. 12
PIT NO. 12
MAY 1943
JUNE 1944
MARCH 1943
DEC. 1 - 1955
JAN. 31 - 56
AUGUST
FOOT ON FILL JAN. 31 - 1956
AUGUST 1956 BACK FILLED
PIT No 15
MARCH 1943
J A N U A R Y
MAY 1943
1944
MAY 1944
PIT No. 12
MARCH 1943
FEBRUARY 1944
DEC. 1 - 1956
DEC. 1 1955
MARCH AND APRIL 1944
JUNE 1945 - P.12E
APRIL - 1945 P.12E
FEBRUARY - 1945
OCTOBER 1943
SEPT. 1943
DECEMBER 1943
JANUARY 1944
JUNE 1944
FEBRUARY
SEPTEMBER 1944 P.12E
MARCH AND APRIL
AUG. 1943
SEPT. 1943
OCTOBER 1943
MARCH AND APRIL 1944
MAY 1944
DEC. 2. 1955 "PETERS"
MAY 1946 P.12E
1945 - P12E
MAY 1946 P.12E
AUG. 1945 - P.12E
NOV. 1945 - P.12E
NOV. 1945 P.12E
NOV. 1945 - P.12E
NOV. 1945 P.12E
NOV. 1945 P.12E
NOV. 1945 P.12E
FEB. 1946 P.12E
FEB. 1946 - P.12E
FEB. 1946 - P.12E
MARCH 1946 P.12E
APRIL 1946 P.12E
MAY 1946 P.12E
MAY 1946 - P.12E
PIT
FALL
V.376 P.85 2-20-42
WIRE ROPE FENCE
N 85 05 E 700
BEGINNING
LINE
VOL. 1269 - P. 93
SALEM HILL COAL CO. SHOIL BANK AS OF
P.45 VOL 847
BOROUGH LINE
15' DEEP CLOSED
26' DEEP 16' COAL
3+00 NORTH
P.101 VOL 869
P.97 VOL 876 LEVELS
106+00 1323.57
108+00 1327.21
110+00 1331.12
112+00 1335.50
114+00 1338.32
116+00 1346.69
118+00 1360.36
120+00 1374.33
122+00 1388.80
124+00 1397.02
126+00 1391.18
128+00 1370.85
130+00 1379.30
132+00 1385.79
134+00 1387.09
136+00 1380.36
138+00 1355.33
140+00 1332.23
142+00 1338.74
144+00 1356.67
146+00 1381.36
148+00 1398.92
150+00 1416.76
152+00 1426.0
154+00 1423.84
156+00 1411.85