


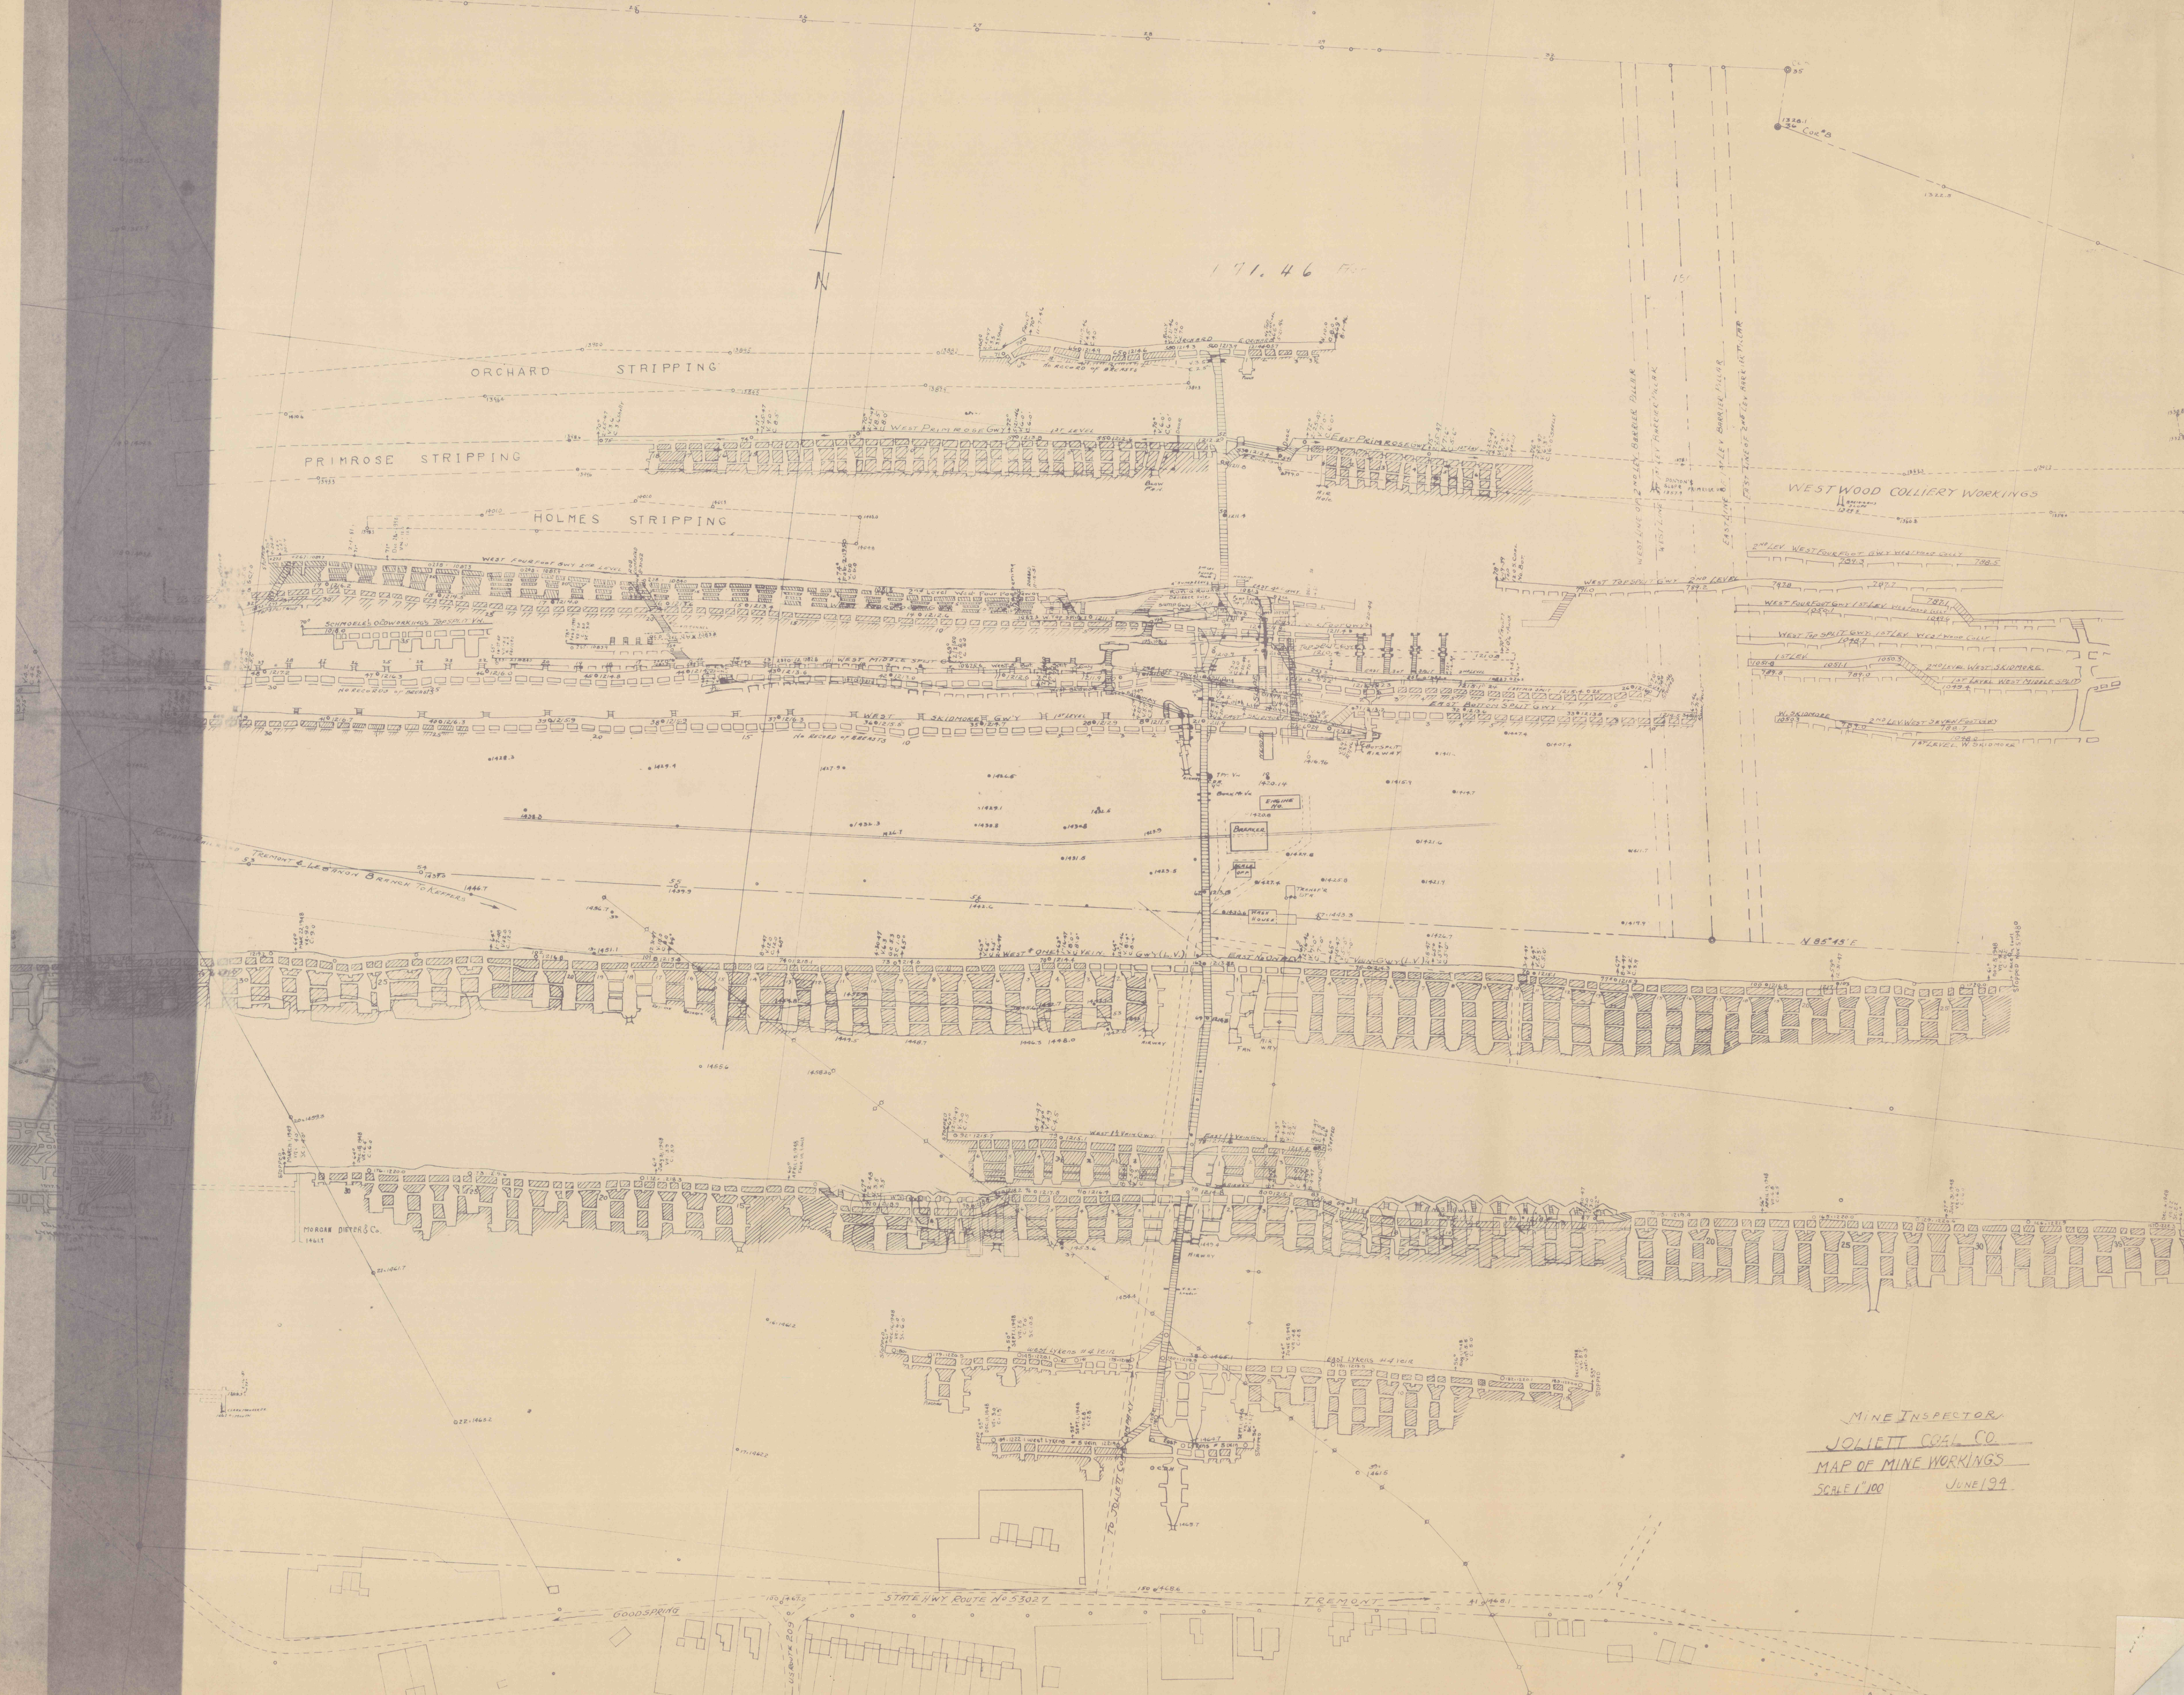

MINE INSPECTOR
JOLIET COAL CO.
MAP OF MINE WORKINGS
SCALE 1"=100 JUNE 1914