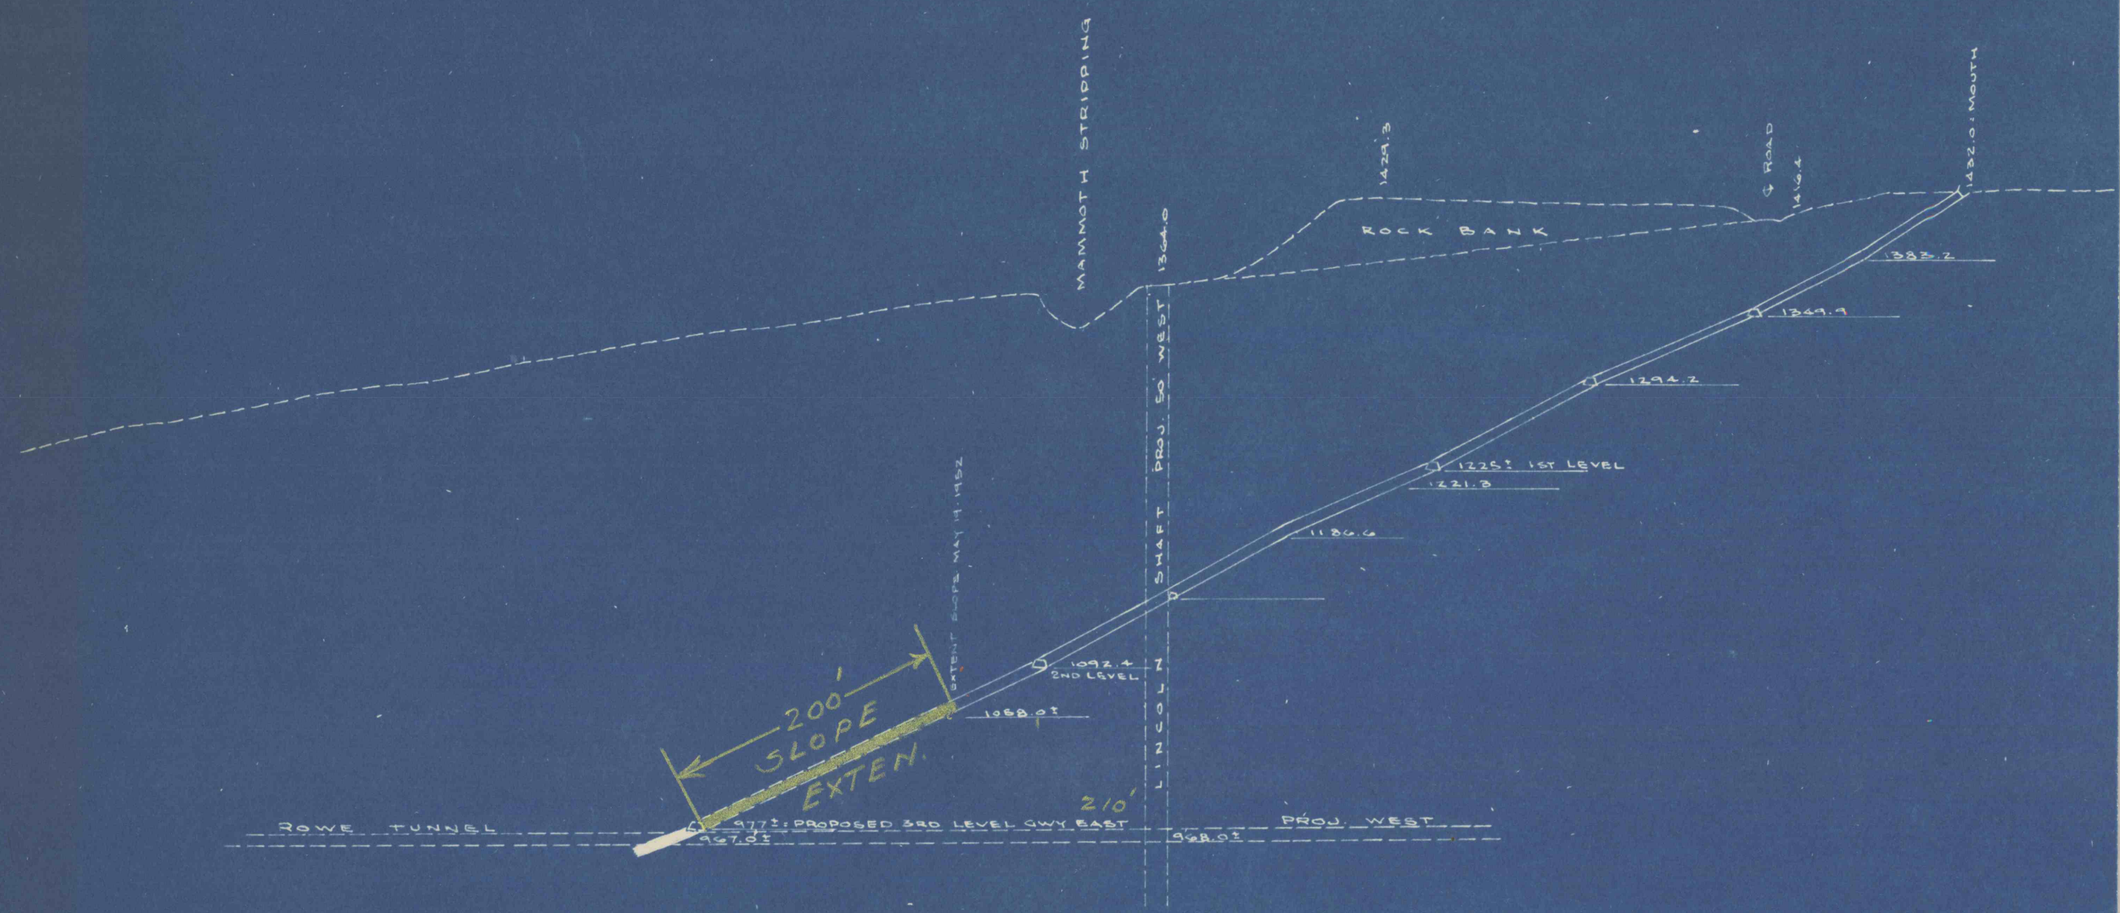


SECTION LOOKING WEST

DATUM 800

## MOYERS SLOPE

CROSS SECTION THRU MOYERS BUCK MTN. VN. SLOPE SHOWING PROPOSED 3RD LEVEL GWY. IN REGARDS TO TAPPING OF ROWE TUNNEL.

SCALE 1" = 100'  MAY 28, 1952
A. RIEDEL, ENGR.