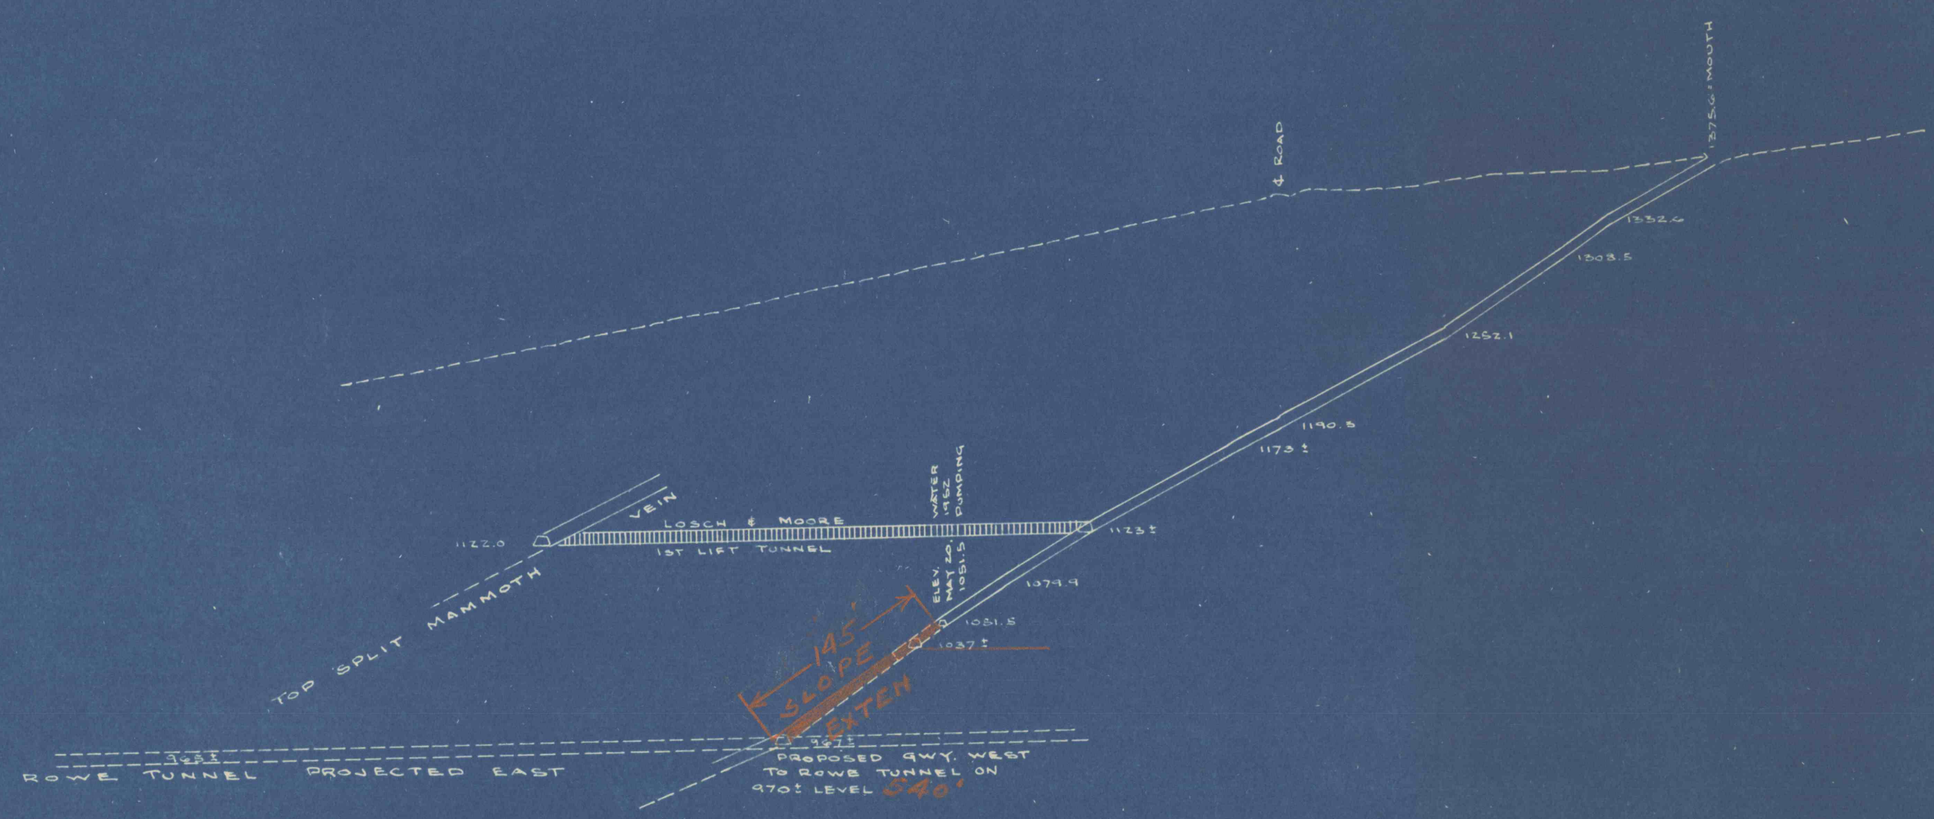

SECTION LOOKING WEST

DATUM 800

ZIMMERMANS SLOPE

CROSS SECTION THRU ZIMMERMANS BUCK MTN. VN. SLOPE SHOWING THE PROROSED, 967 LEVEL GWY. IN REGARDS TO DRAINAGE INTO ROWE TUNNEL

SCALE 1" = 100'

MAY 28, 1952

A. RIEDEL, ENGR.