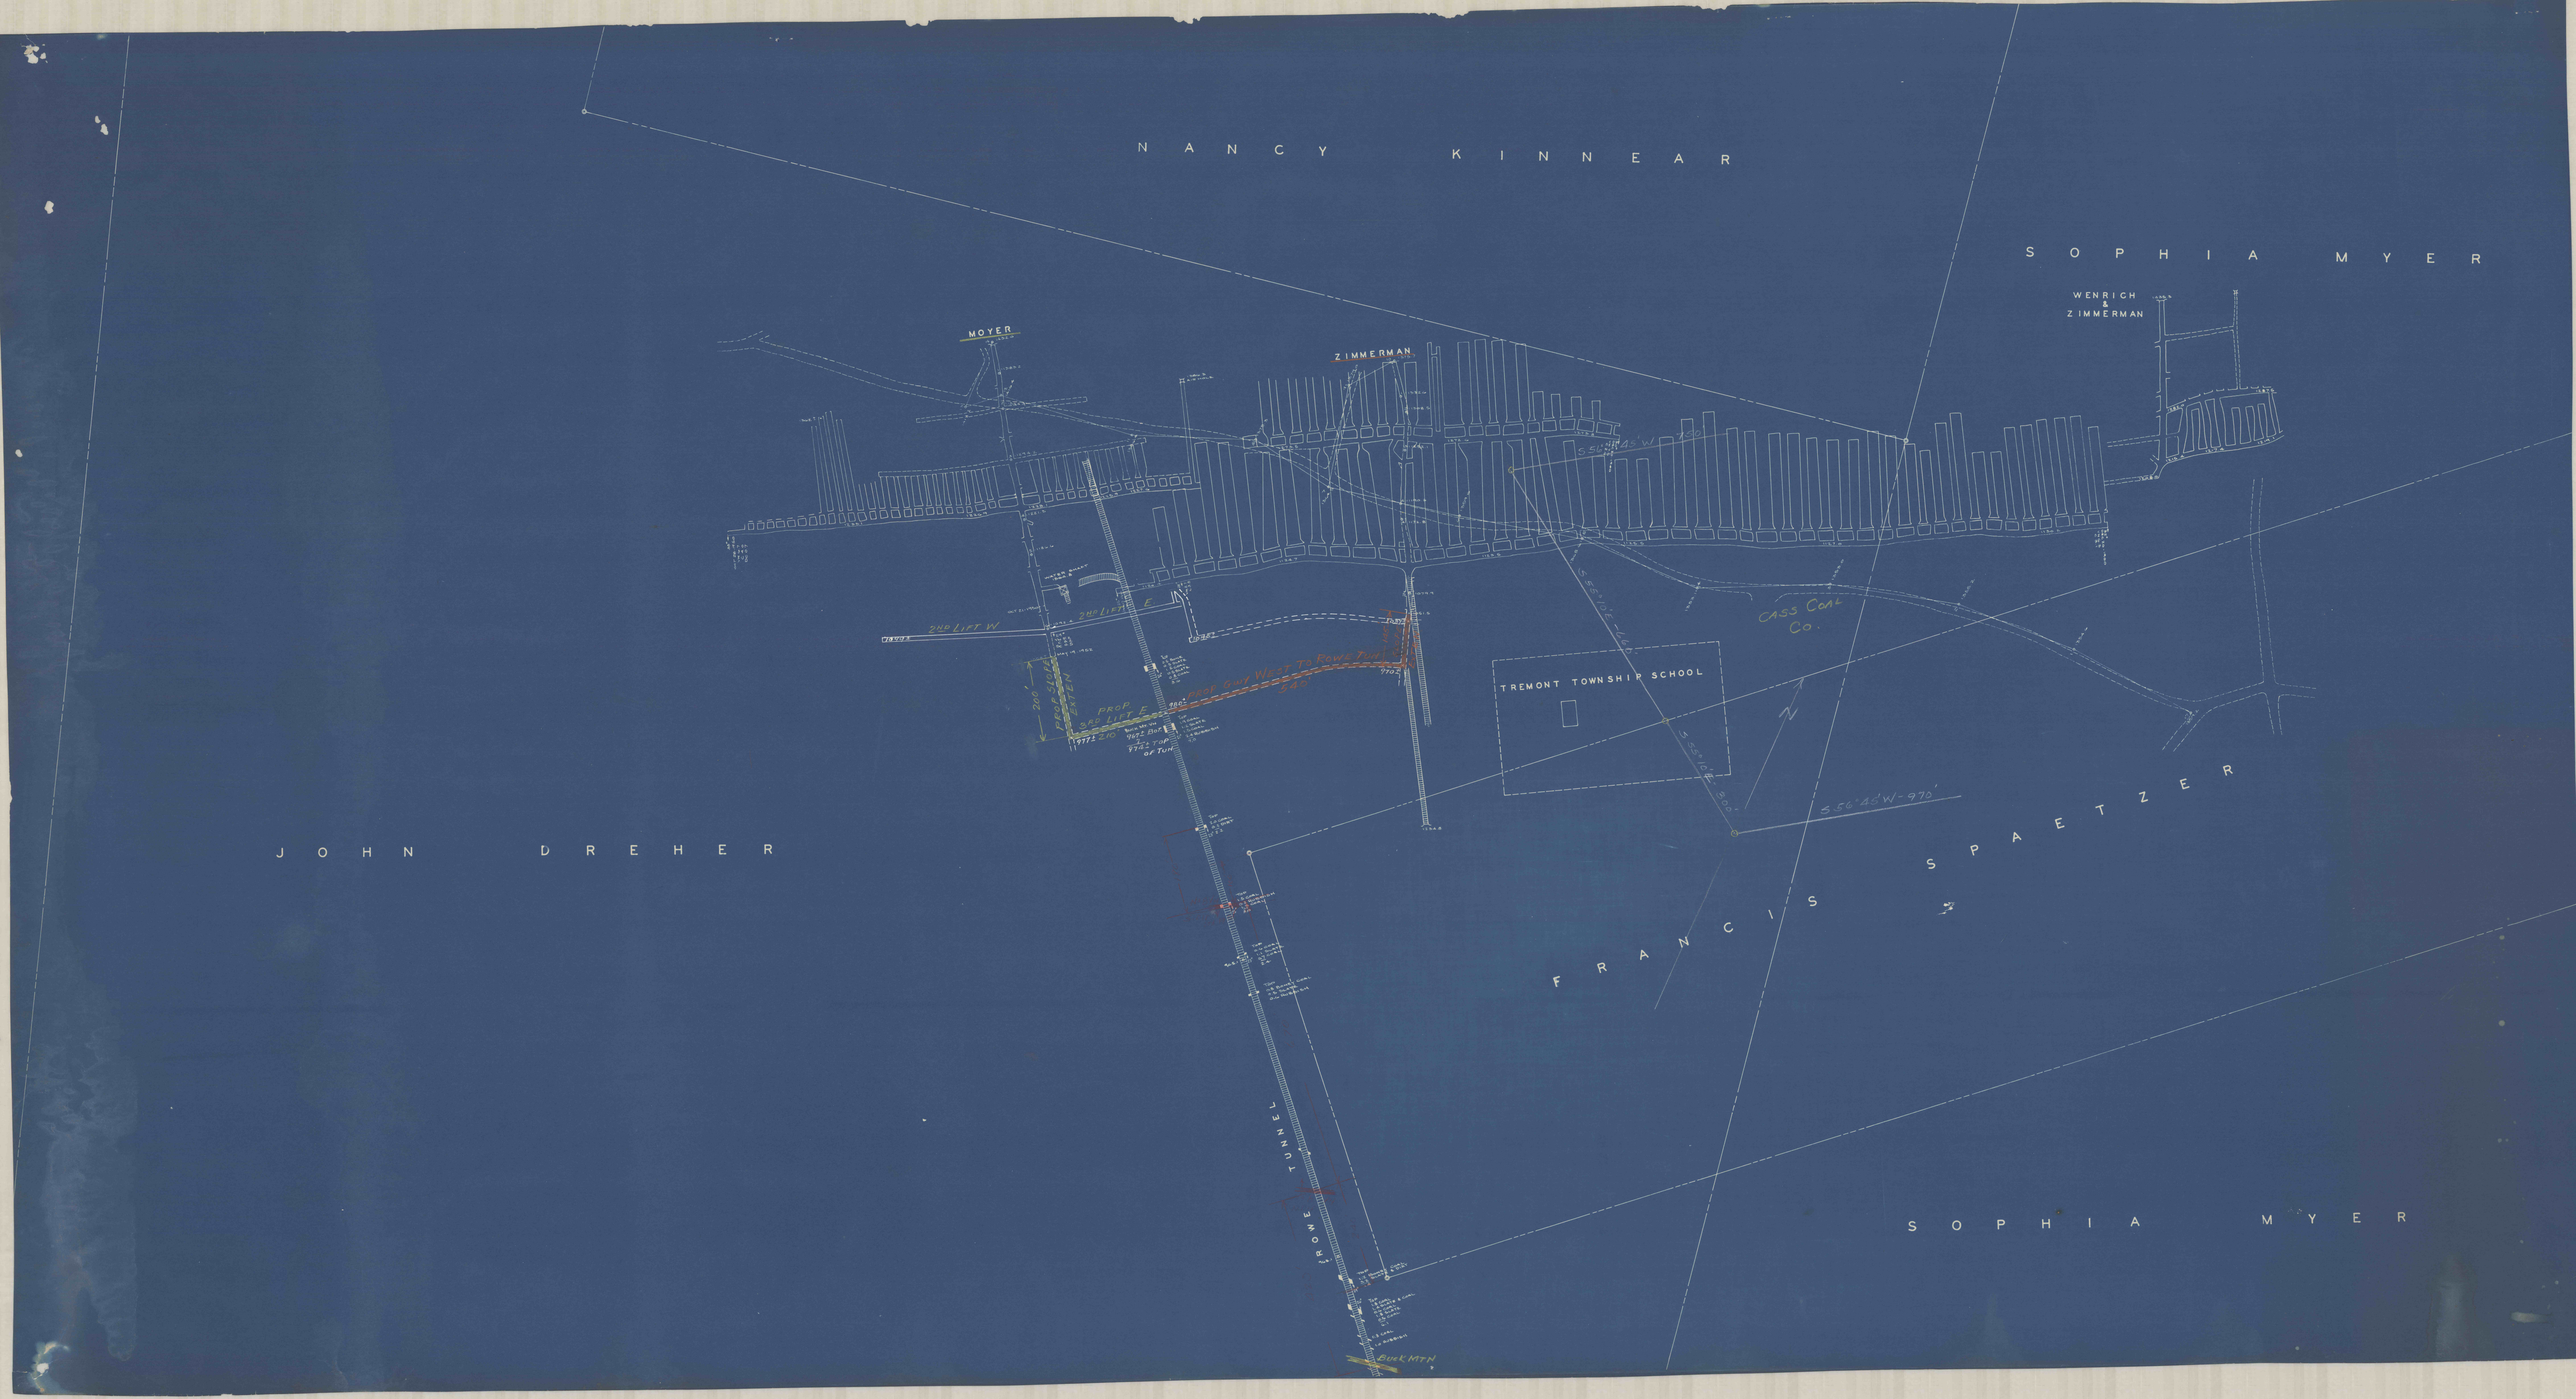
NANCY KINNEAR
SOPHIA MYER
WENRICH & ZIMMERMAN
MOYER
ZIMMERMAN
S 51°45' W - 710'
2ND LIFT W
2ND LIFT E
CASS COAL CO.
TREMONT TOWNSHIP SCHOOL
PROP. 3RD LIFT E
PROP. GOAF WEST TO ROWE TUNNEL
540'
PROPOSED ROW
200'
S 56°40' W - 970'
JOHN DREHER
FRANCIS SPAETZER
SOPHIA MYER
ROWE TUNNEL
BUCK MTN