
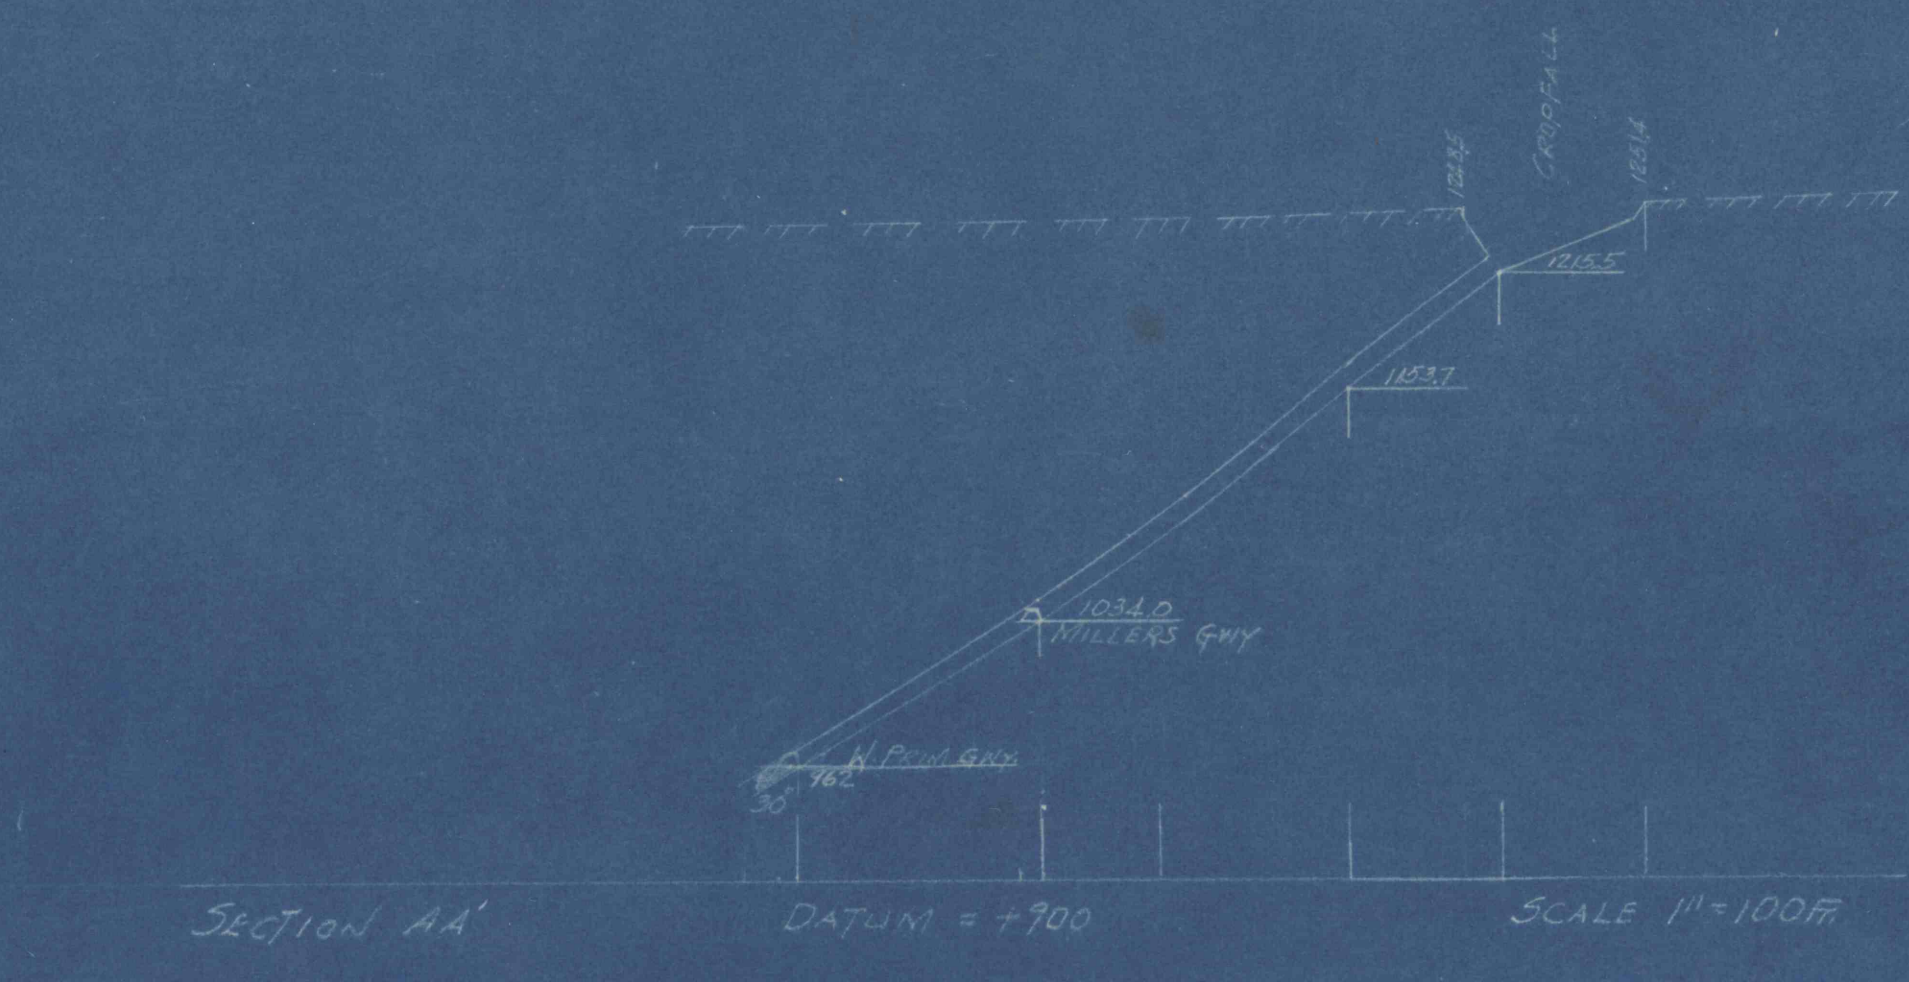


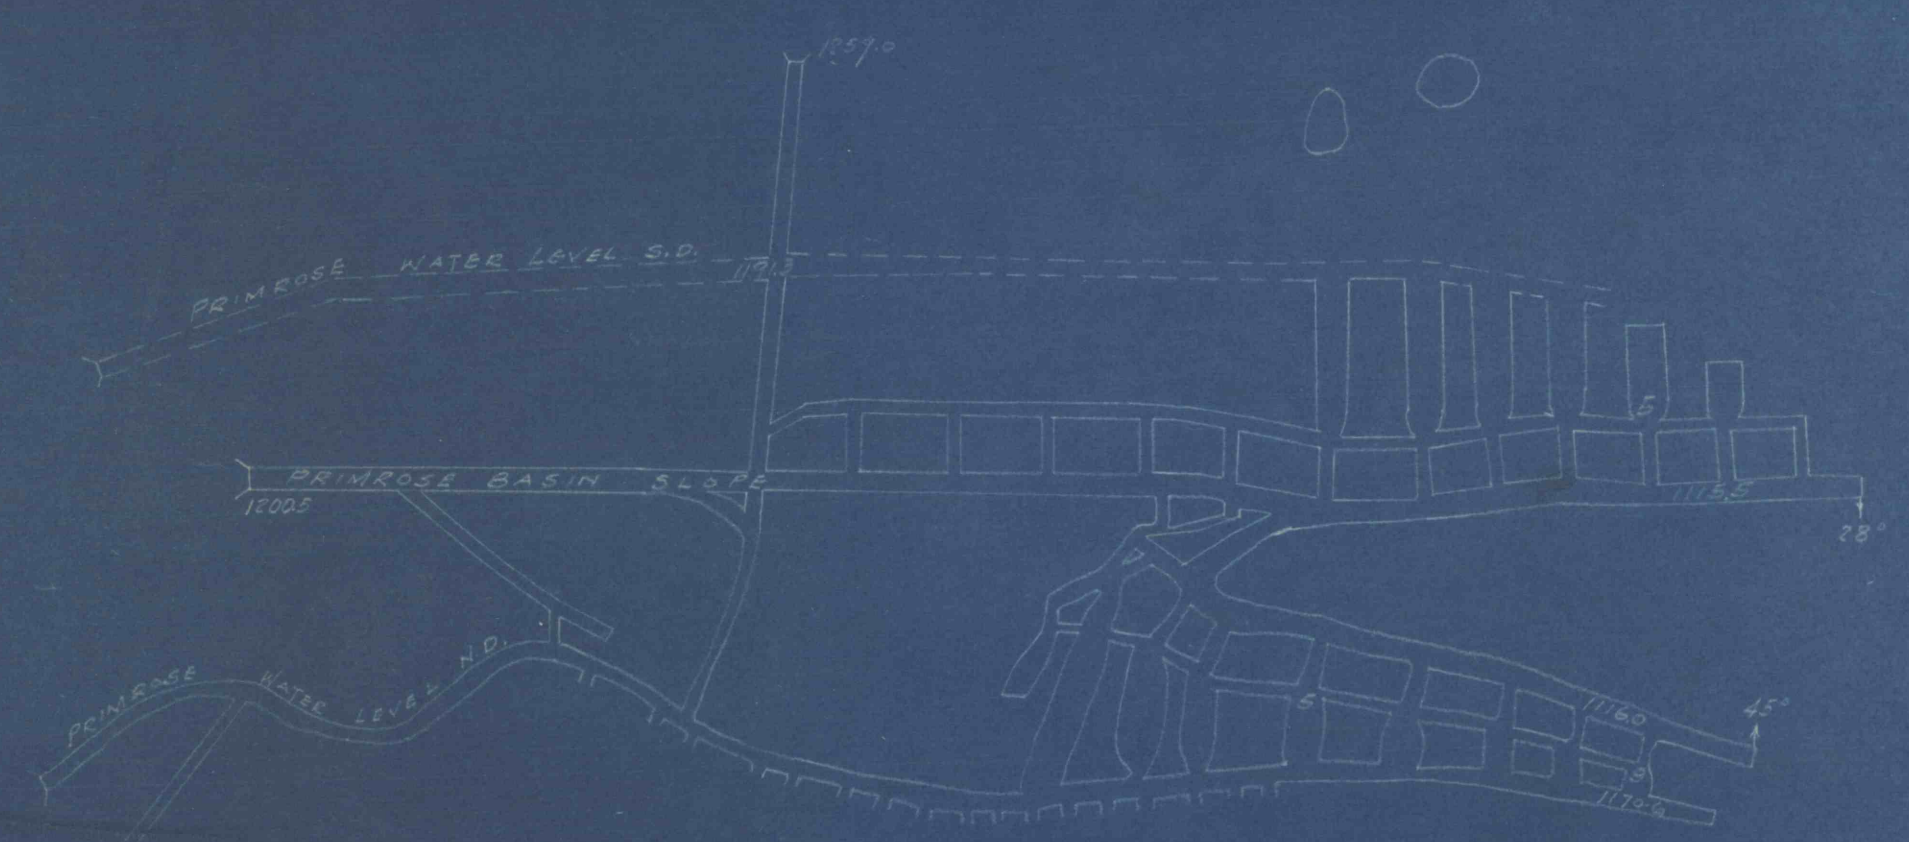

RAUSCH CREEK, PA.
DEAN COAL COMPANY
MAP OF MINE WORKINGS
TREVINO, PA.
SCALE 1"=100'