
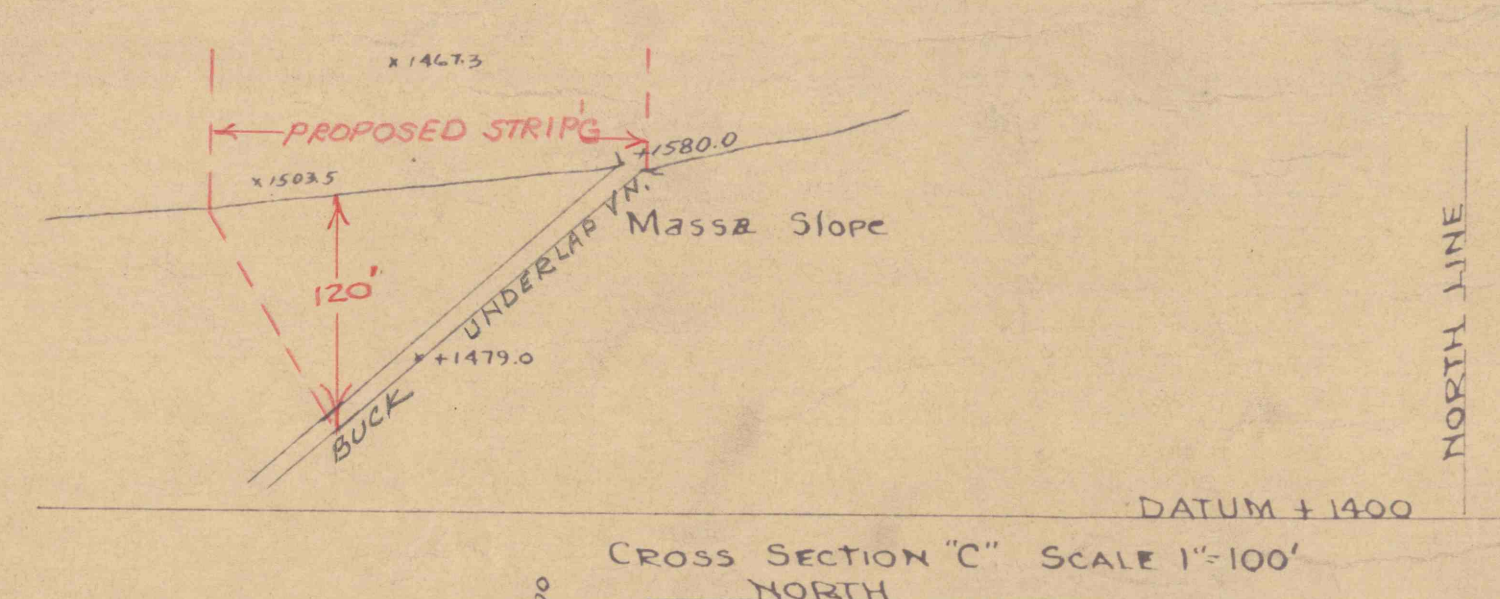
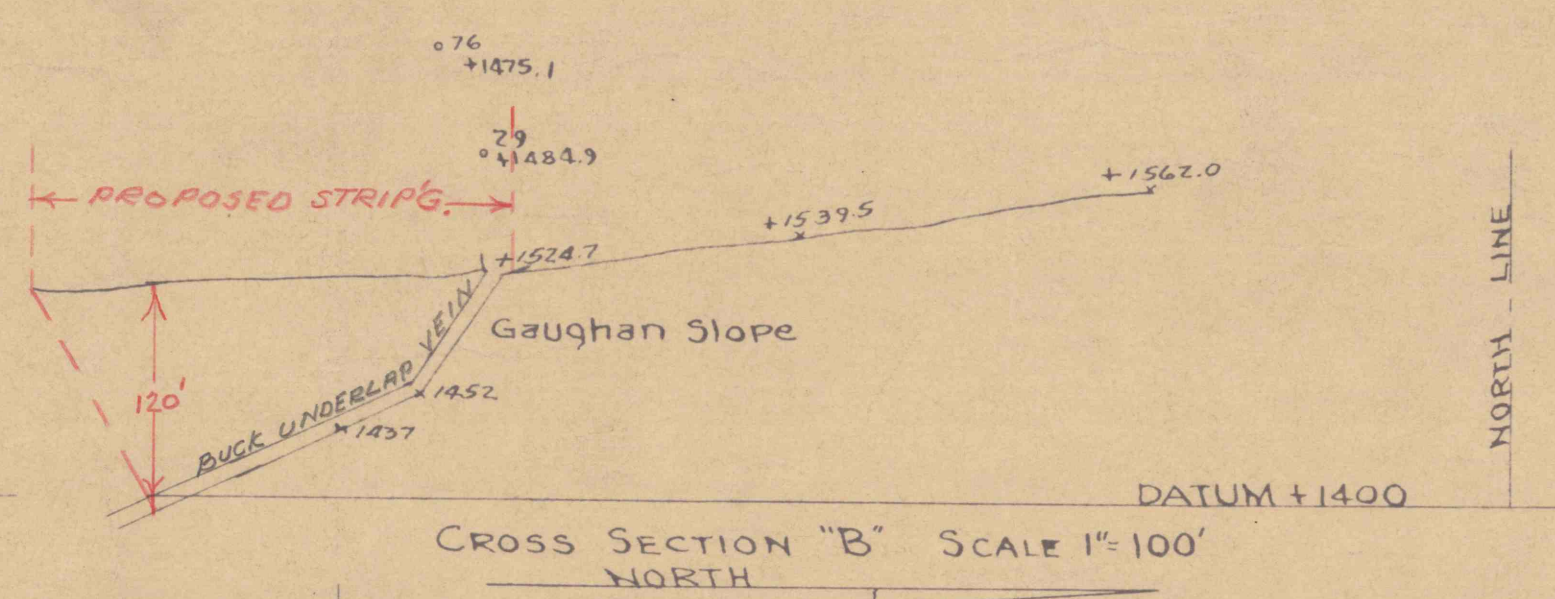
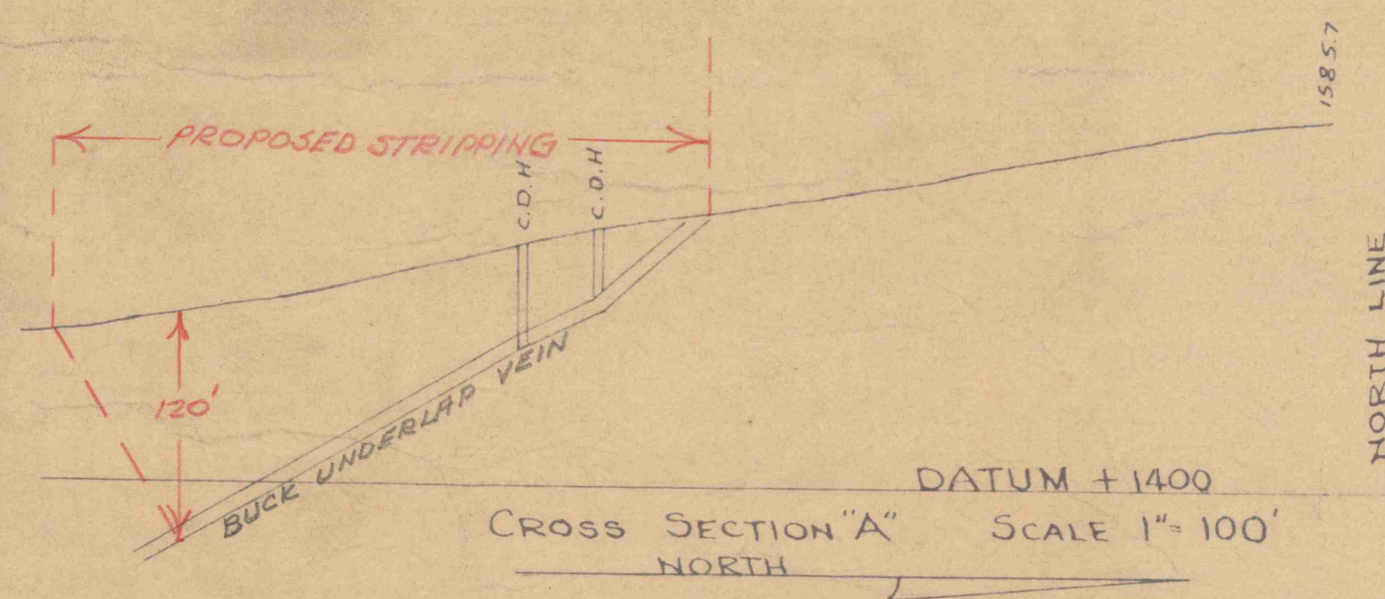


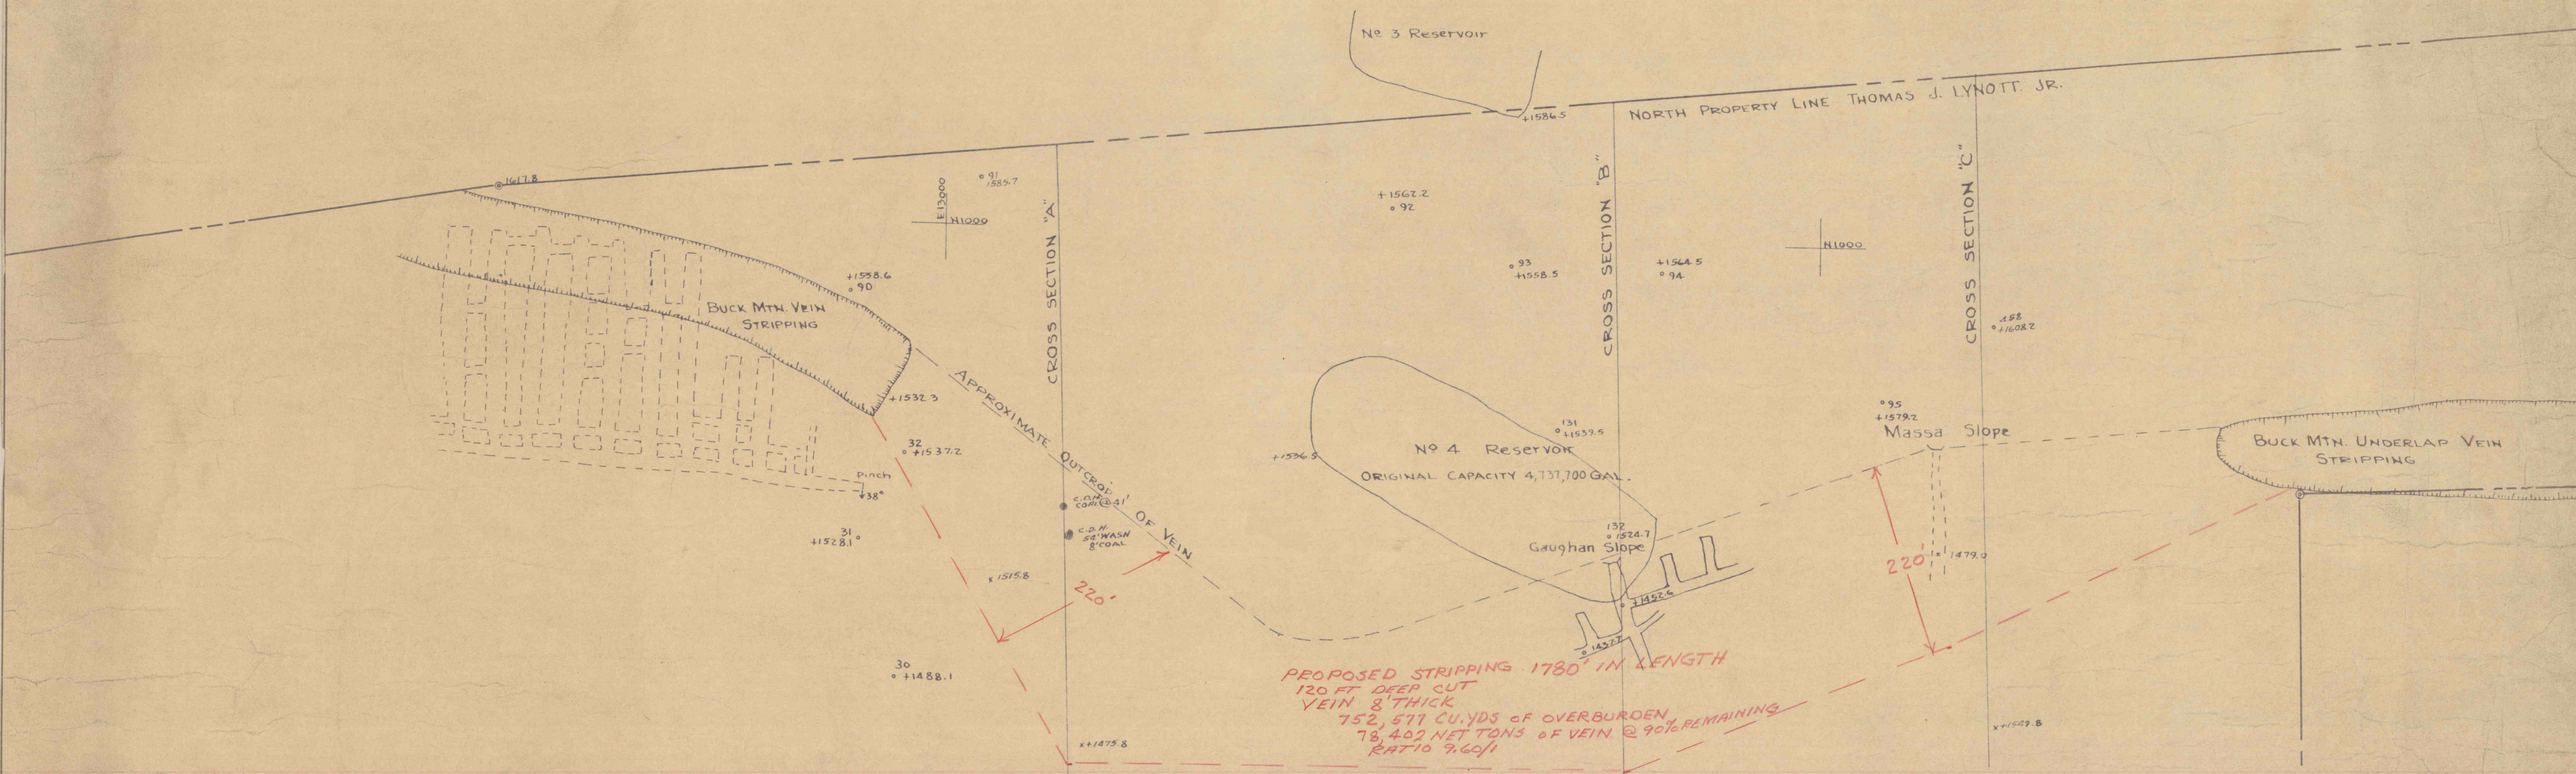

WEST LINE OF CENTRALIA BOROUGH