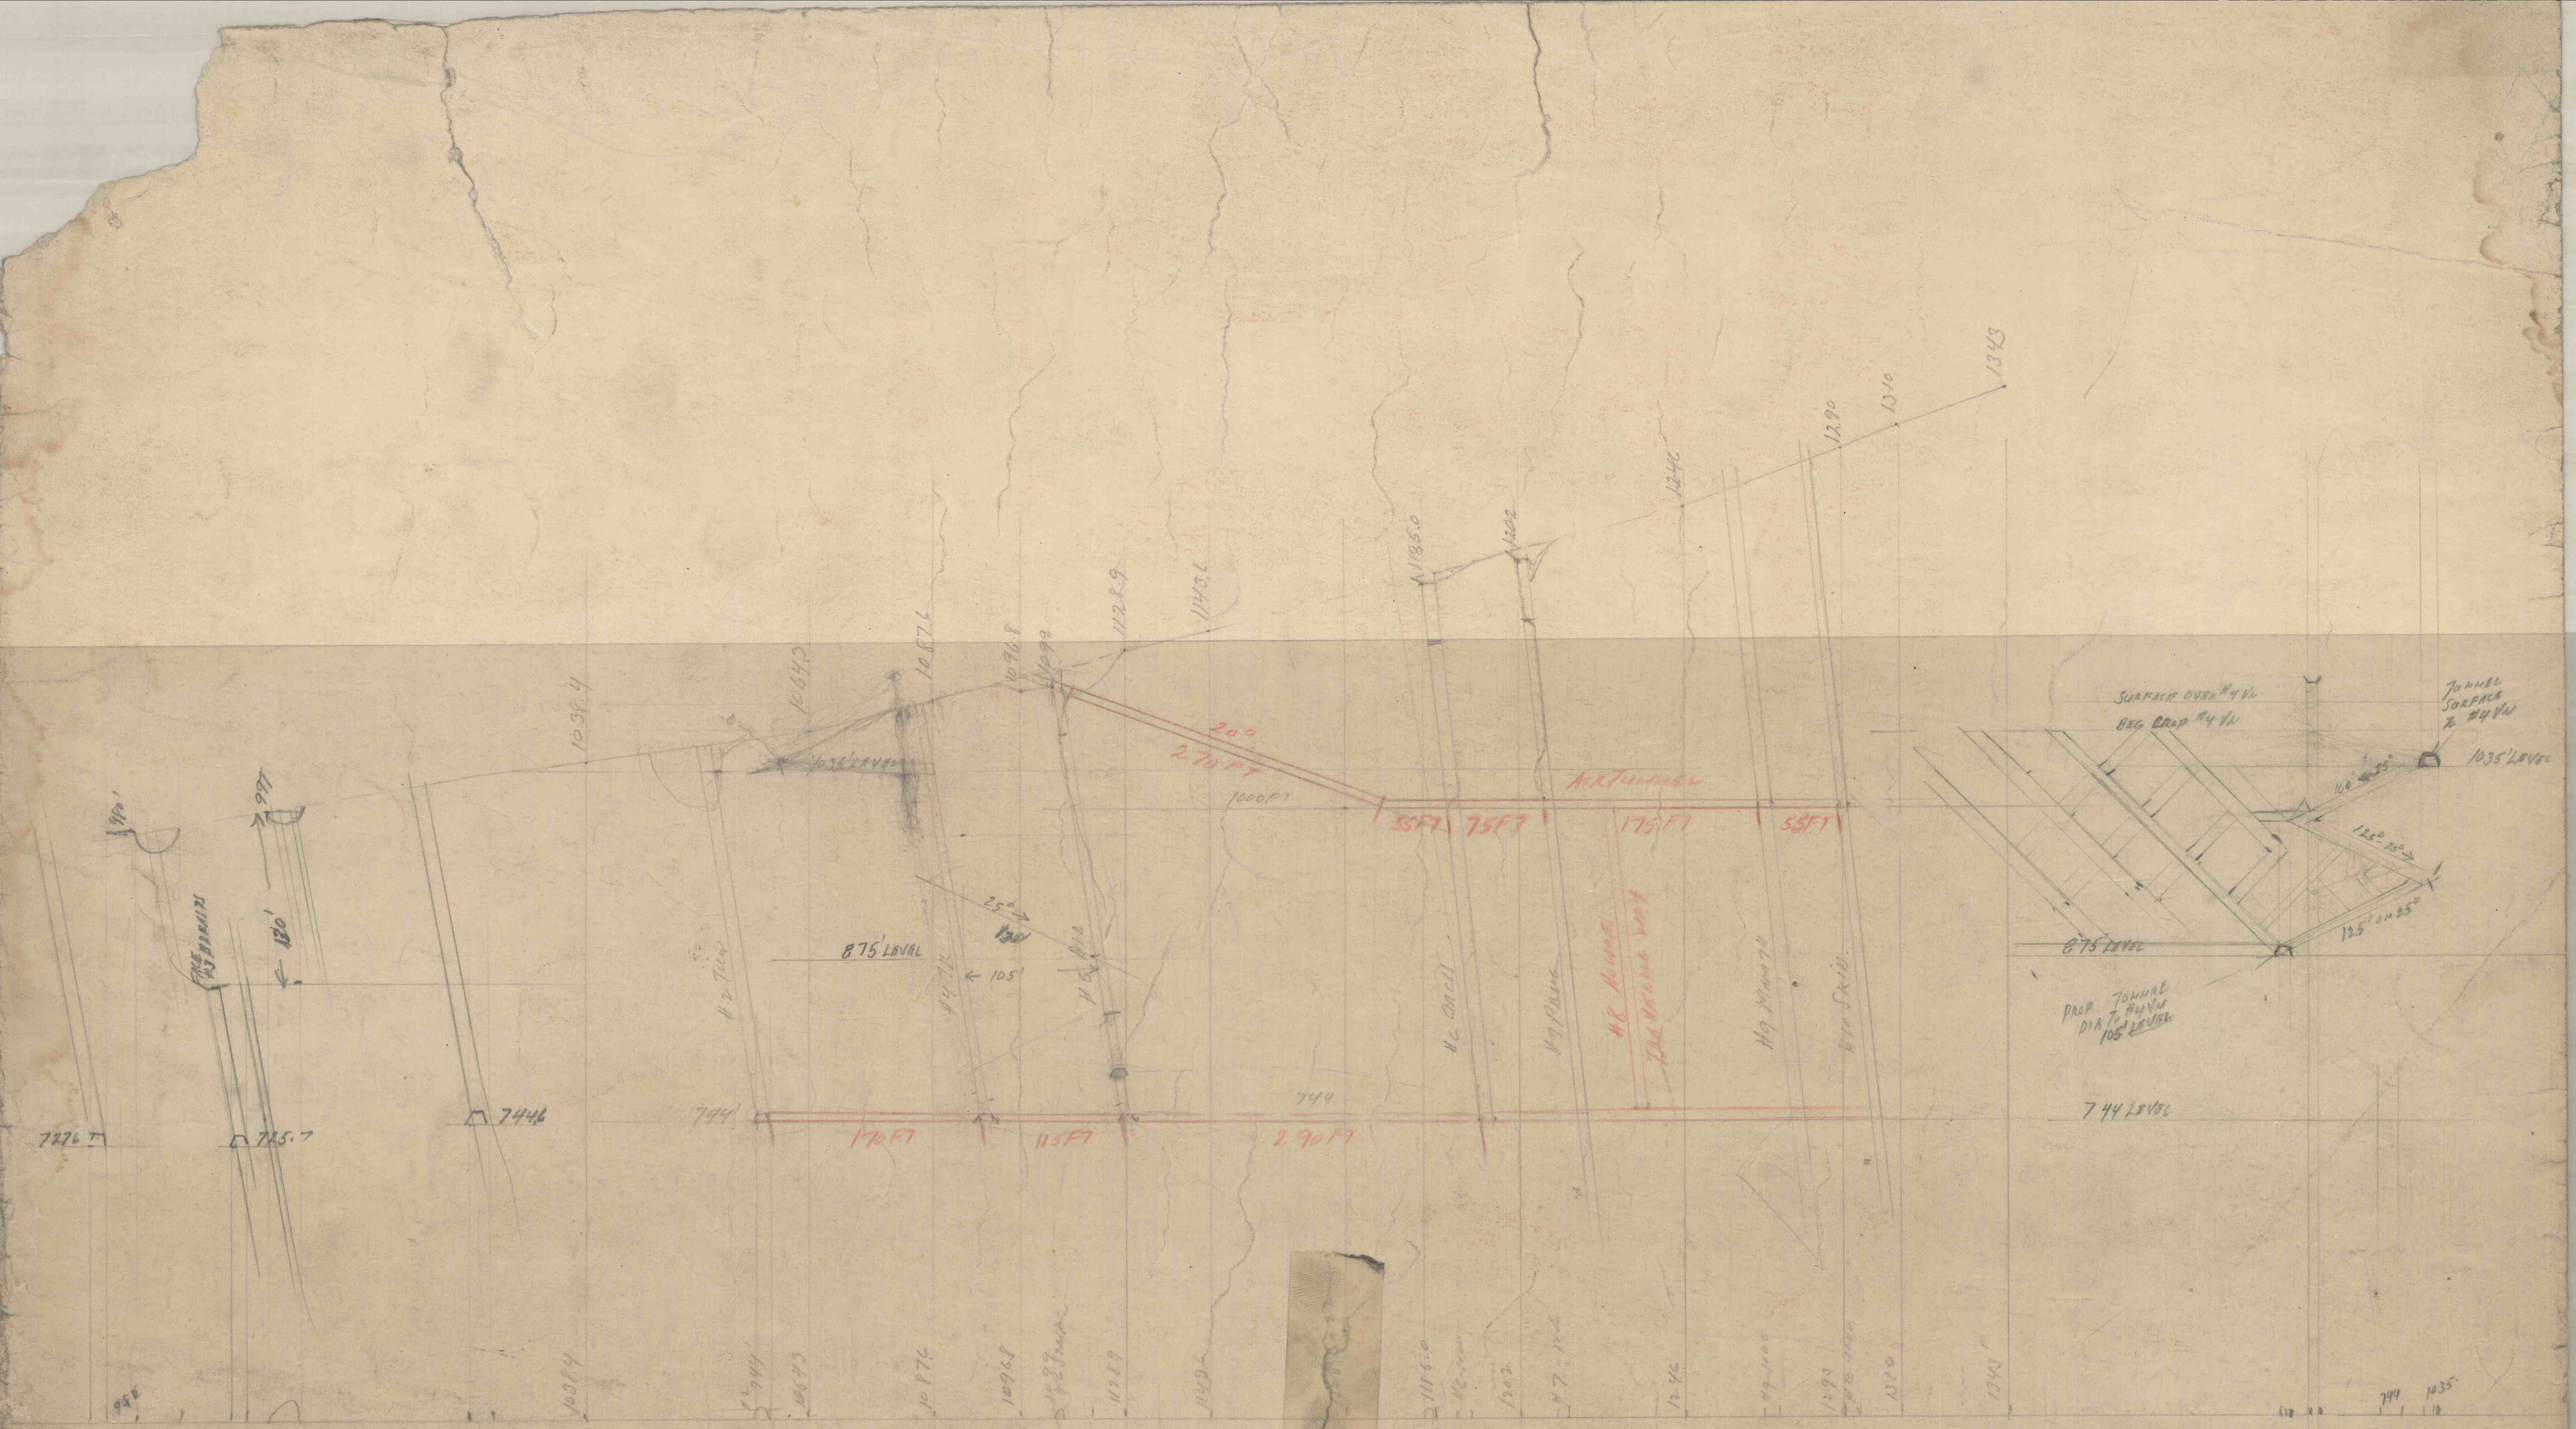
875' LEVEL
744' LEVEL
1035' LEVEL
7446
7276
7225.7
1035.4
1087.2
1122.9
1143.2
1185.0
1202
1246
1290
1310
1343
200
270 FT
1000 FT
55FT
75FT
175FT
55FT
170FT
115FT
290FT
744
105'
125'
SURFACE OVER #4 VL
BEG. CROP #4 VL
TUNNEL SURFACE & #4 VL
1035' LEVEL
875' LEVEL
744' LEVEL
PROP. TUNNEL DIA. & #4 VL
105' LEVEL
