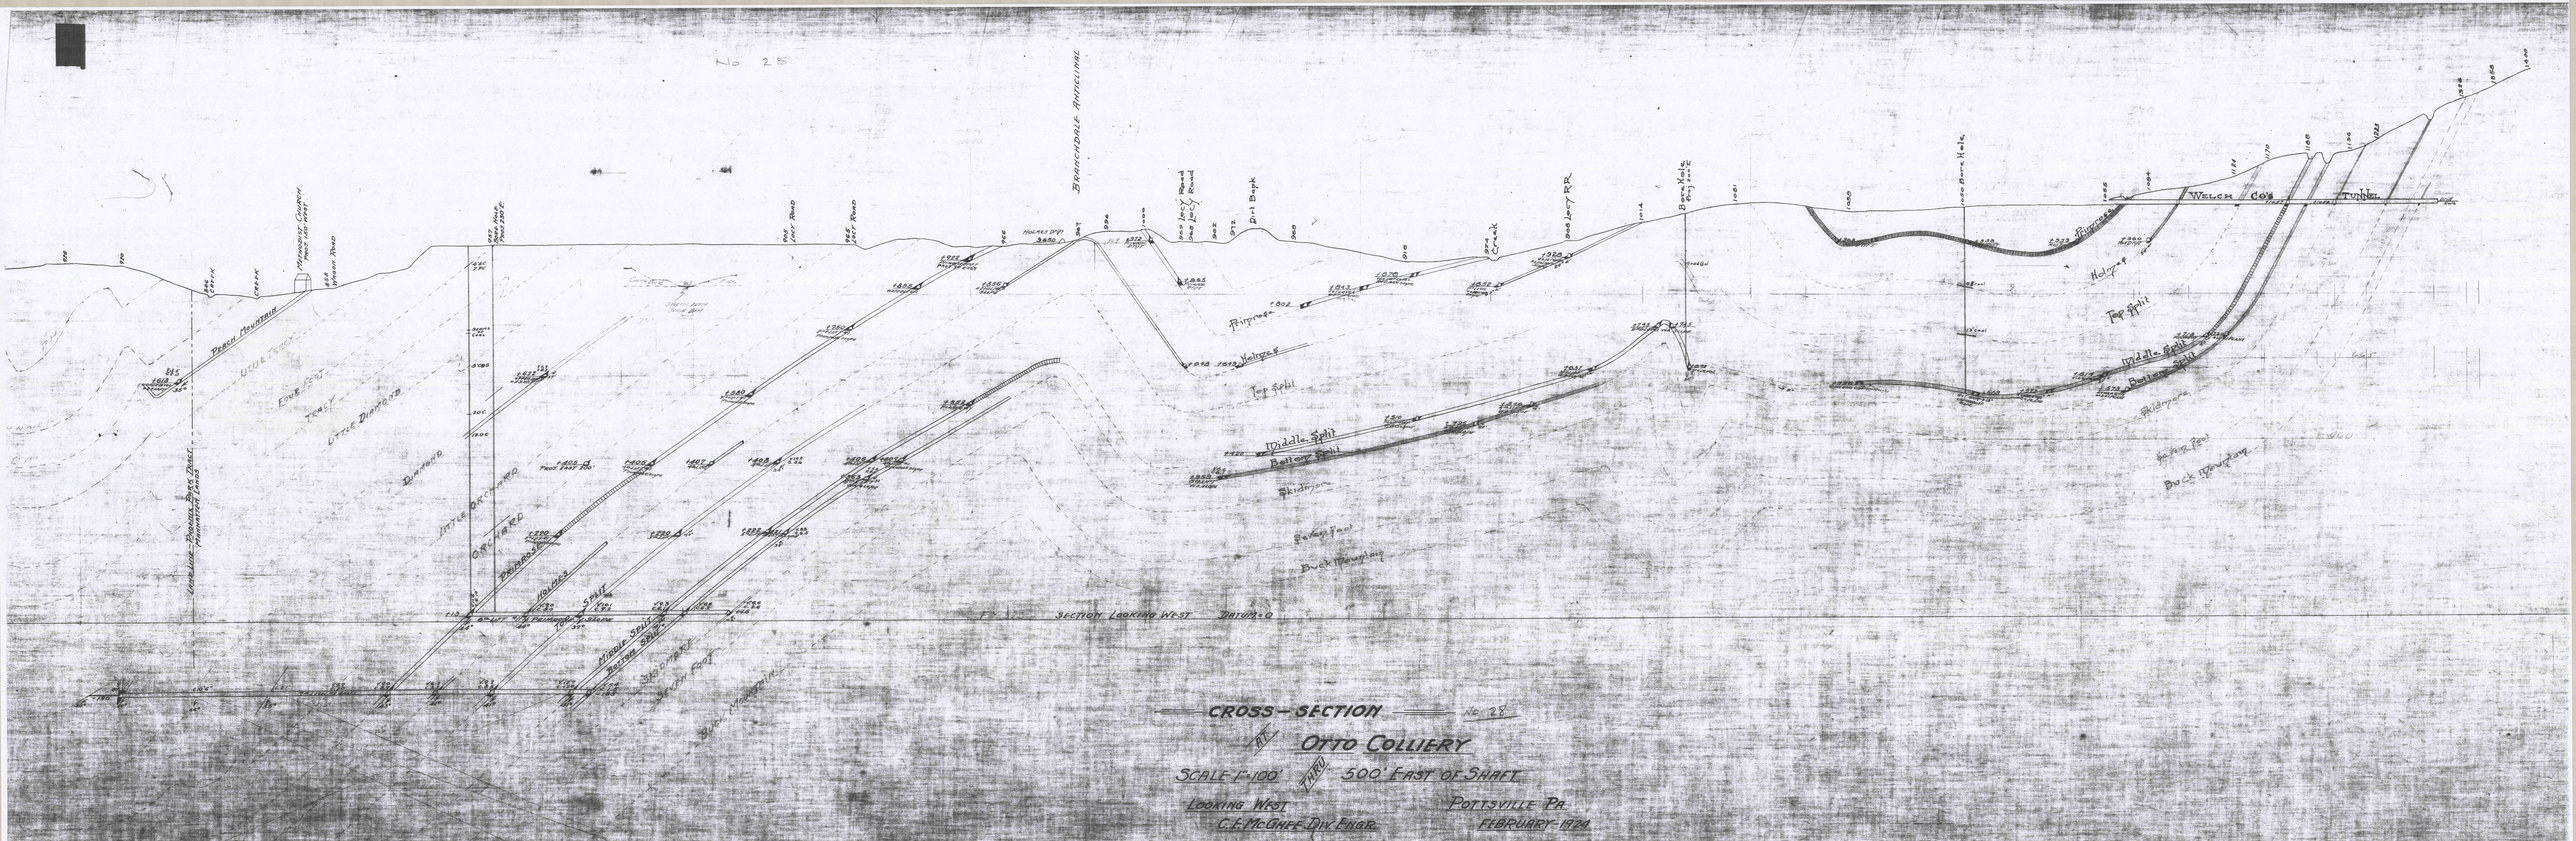


CROSS-SECTION No. 28

OF

OTTO COLLIERY

SCALE 1"=100' AND 500' EAST OF SHAFT

LOOKING WEST POTTSVILLE PA.

C.E. McGHEE DIV. ENGR. FEBRUARY-1924